
FARRIS, HANSEN & ASSOC. INC.

7 RIDGWAY COURT— P.O. BOX 437 ELKHORN, WISCONSIN 53121 PHONE (262) 723—2098 FAX (262) 723—5886 PLAT OF SURVEY
LOTS 35 & 36, BLOCK "G" CRYSTAL BOWL, A SUBDIVISION
LOCATED IN THE NW 1/4 OF SEC. 13, T3N, R15E
WALWORTH COUNTY, WISCONSIN

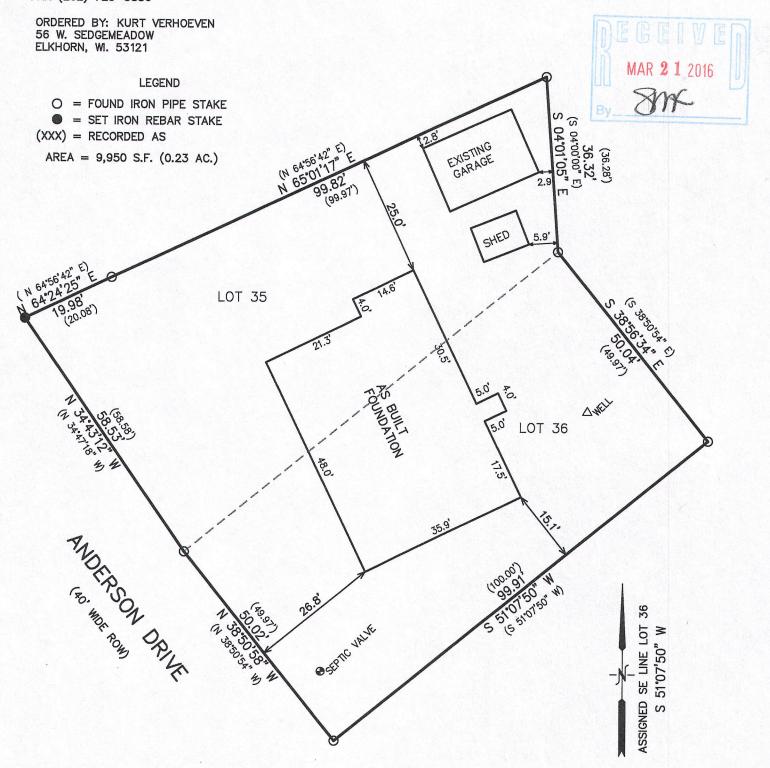

NOTE: COPIES OF THIS MAP TO WHICH THE FOLLOWING CERTIFICATE WILL APPLY SHOW SURVEYOR'S ORIGINAL SEAL AND SIGNATURE IN RED INK. COPIES BY ANY OTHER MEANS MAY HAVE ALTERATIONS WHICH DO NOT REPRESENT THE SURVEYOR'S WORK PRODUCT.

I HEREBY CERTIFY THAT THE ABOVE DESCRIBED PROPERTY HAS BEEN SURVEYED UNDER MY DIRECTION AND THAT THE ABOVE MAP IS A TRUE REPRESENTATION THEREOF AND SHOWS THE SIZE AND LOCATION OF THE PROPERTY AND ITS EXTERIOR BOUNDARIES. THIS SURVEY IS MADE FOR THE USE OF THE PRESENT OWNERS OF THE PROPERTY, AND ALSO THOSE WHO PURCHASE, MORTGAGE, OR GUARANTEE THE TITLE THERETO WITHIN ONE YEAR FROM THE DATE HEREOF.

DATED: DECEMBER 30,2015

REVISED 02-03-2016
TO SHOW SIZE & LOCATION OF AS BUILT FOUNDATION

35-1268

GORDON

S-2101

PETER S. GORDON R.L.S. 2101

PROJECT NO. 9441 DATED: 12-30-2015 SHEET 1 OF 1 SHEETS