

PERMIT PLAT
LOT 1 CSM 4534

LOCATED IN THE SE 1/4 OF THE SE 1/4 SECTION 10 &
THE SW 1/4 OF THE SW 1/4 SECTION 11
TOWN 1 NORTH, RANGE 15 EAST
WALWORTH COUNTY, WISCONSIN



NOTE: COPIES OF THIS MAP TO WHICH THE FOLLOWING CERTIFICATE
WILL APPLY SHOW THE SURVEYOR'S ORIGINAL SEAL AND SIGNATURE
IN RED INK. COPIES BY ANY OTHER MEANS MAY HAVE ALTERATIONS
WHICH DO NOT REPRESENT THE SURVEYOR'S WORK PRODUCT.


I HEREBY CERTIFY THAT THE ABOVE DESCRIBED PROPERTY HAS BEEN
SURVEYED UNDER MY DIRECTION AND THAT THE ABOVE MAP IS A TRUE
REPRESENTATION THEREOF AND SHOWS THE SIZE AND LOCATION OF
THE PROPERTY AND ITS EXTERIOR BOUNDARIES. THIS SURVEY IS
MADE FOR THE USE OF THE PRESENT OWNERS OF THE PROPERTY, AND
ALSO THOSE WHO PURCHASE, MORTGAGE, OR GUARANTEE THE TITLE
THERE TO WITHIN ONE YEAR FROM THE DATE HEREOF.

DATED: JULY 17, 2014

Peter S. Gordon
PETER S. GORDON R.L.S. 2101

REVISED 09-29-2014
TO SHOW SIZE & LOCATION OF
AS BUILT FOUNDATION

REVISED 06-06-2016
TO SHOW SIZE & LOCATION OF
PROPOSED SHED

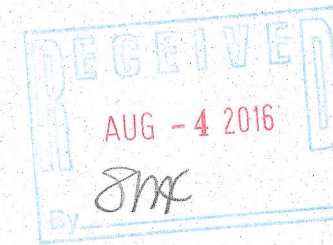

FARRIS, HANSEN & ASSOC. INC. CERTIFIED SURVEY MAP NO. 4534
7 RIDGWAY COURT - P.O. BOX 437
ELKHORN, WISCONSIN 53121
PHONE (262) 723-2088
FAX (262) 723-5886

LOCATED IN PART OF THE SE 1/4
OF THE SE 1/4 OF SECTION 10 AND
IN PART OF THE SW 1/4 OF THE
SW 1/4 OF SECTION 11, ALL IN
TOWN 1 NORTH, RANGE 15 EAST,
WALWORTH COUNTY, WISCONSIN

Doc # 887412
Recorded
July 01, 2014 11:43 PM
FILED
DONNA R. PUESS
REGISTER OF DEEDS
WALWORTH COUNTY, WI
Fee Amount: \$30.00
Total Pages: 3

SOILS: M9B, M92, M92, & M92
LEGEND

- = FOUND CONCRETE COUNTY MONUMENT W/BRASS CAP
- = FOUND IRON PIPE STAKE, 1" DIA.
- = FOUND IRON REBAR STAKE, 3/4" DIA.
- = RIGHT OF WAY POST FOUND AT PROPERTY CORNER
- = SET IRON REBAR STAKE 3/4" x 24" x 150 lbs./ft UNPLATTED
- = SOIL BORING LOCATED LANDS
- [XXX] = RECORDED AS

THIS INSTRUMENT DRAFTED BY PETER S. GORDON
PROJECT NO. 4459.14
DATED: 05/09/2014
SHEET 1 OF 3 SHEETS

CSM #4534

PETER S. GORDON
62101
ELKHORN,
WI

VOL. 29 PAGE 312



WORK ORDERED BY:
JOHN LASKOWSKI
W8075 STY. ROAD A
DELAVAN, WI.

FARRIS, HANSEN & ASSOCIATES, INC.
ENGINEERING - ARCHITECTURE - SURVEYING
7 RIDGWAY COURT P.O. BOX 437
ELKHORN, WISCONSIN 53121
OFFICE: (262) 723-2088 FAX: (262) 723-5886

REVISIONS

PROJECT NO.
4459.14

DATE:
07-17-2014

SHEET NO.
1 OF 1

JUN 06 2016

X:\Projects\4459\4459_1\ACAD\PermitPlat

CA4534-1

3/5-1277