

LAND-MARK SURVEYING

Mark L. Miritz

Wisconsin Professional Land Surveyor S-2582



N9330 Knuteson Drive
Whitewater, WI 53190
Phone: (262) 495-3284
MARKMIRITZ@
LAND-MARKSURVEYING.COM

PLAT OF SURVEY

LEGAL DESCRIPTION

LOT 4, BLOCK 3, CHAPEL HILLS SUBDIVISION
LOCATED IN THE NORTHEAST 1/4, OF THE
NORTHEAST 1/4, SECTION 3, TOWNSHIP 3 NORTH
RANGE 15 EAST, IN THE TOWN OF RICHMOND,
WALWORTH COUNTY, WISCONSIN

OWNER: DAVID F SCOTT III and
MARINA D. SCOTT
6 N. SMITH ST.
PALATINE, IL. 60067

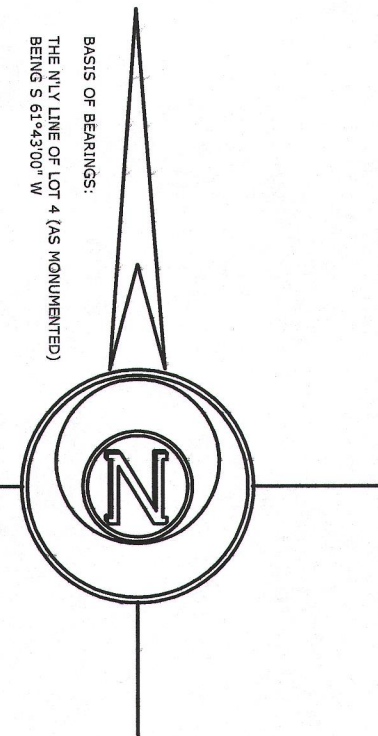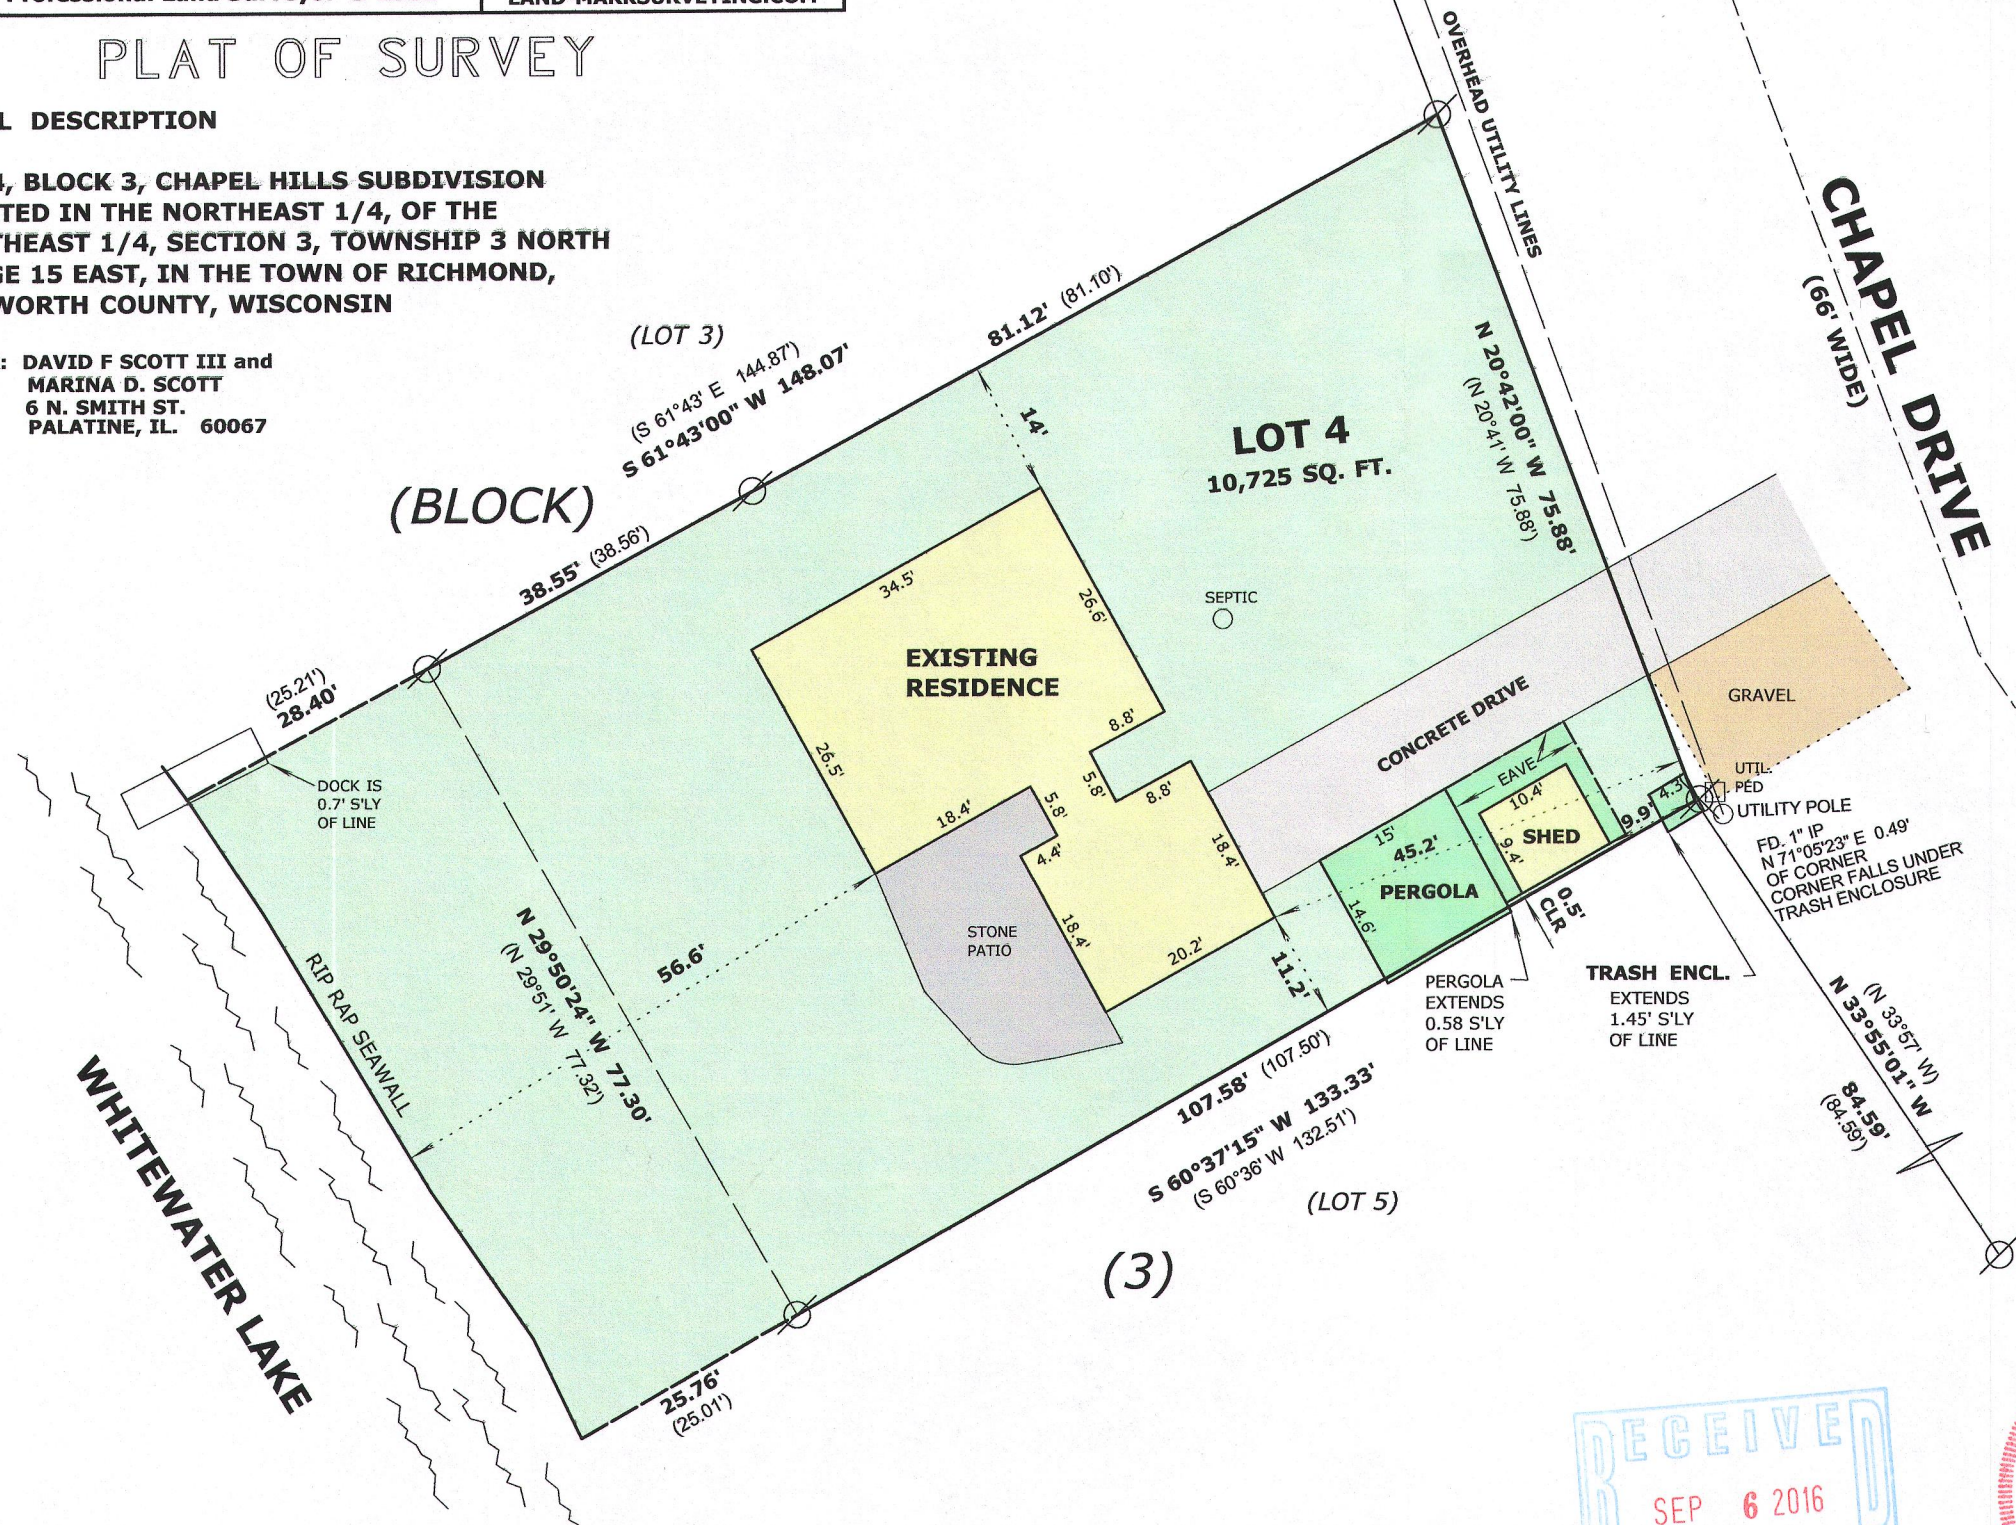

LEGEND


- FOUND IRON PIPE 1 1/4"
- FOUND IRON PIPE 1"
- (x x) RECORDED AS DIMENSION

SCALE: 1 INCH = 20 FEET

"I hereby certify that the above described property has been surveyed by me or under my direction and that the above map is a true representation thereof and shows the size and location of the property, its exterior boundaries, the location of all visible structures and dimensions of all principal buildings thereon, boundary fences, apparent easements, roadways and visible encroachments, if any."
"This survey is made for the use of the present owners of the property, and also those who purchase, mortgage, or guarantee the title thereto within one year from date hereof."

Mark L. Miritz
MARK L. MIRITZ
WISCONSIN PROFESSIONAL
LAND SURVEYOR S-2582

DATE: JULY 6, 2015 JOB NO. 16.701

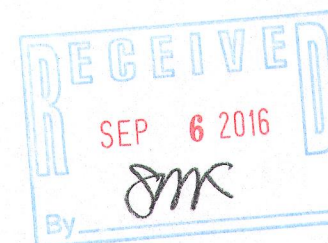

CCH-7B

315-1280