

PREPARED FOR
 JOAN ROLBIECKI
 W7915 TERRITORIAL RD
 DELAVAN, WI. 53115

AS BUILT


- OF -

PATHFINDER SURVEYING INC.
 (formerly)
 J.K. SURVEYING INC.
 P.O BOX 322
 LAKE GENEVA, WI. 53147
 WWW.PATHFINDERSURVEYING.NET
 262-248-8303


LOT 1 OF WALWORTH COUNTY CERTIFIED SURVEY MAP No. 1122, RECORDED IN VOLUME 5 OF CERTIFIED SURVEYS ON PAGE 144 AT THE WALWORTH COUNTY REGISTER OF DEEDS, LOCATED IN THE NE 1/4 OF THE NW 1/4 OF SECTION 11, TOWN 3 NORTH, RANGE 15 EAST, TOWN OF RICHMOND, COUNTY OF WALWORTH AND STATE OF WISCONSIN.

EXCEPT THAT PART OF SAID LOT 1 DESCRIBED AS FOLLOWS:
 COMMENCING AT THE NE CORNER OF LOT 2 OF SAID CERTIFIED SURVEY MAP No. 1122 THENCE S89°30'36" W ALONG THE CENTERLINE OF TERRITORIAL ROAD 217.58 FEET TO THE POINT OF BEGINNING, THENCE CONTINUE ALONG SAID CENTERLINE 64.67 FEET; THENCE S 03°30'26"W 290.21 FEET; THENCE EAST 82.76 FEET; THENCE N 00°04'00" W 289.67 FEET TO THE CENTERLINE OF TERRITORIAL ROAD AND THE POINT OF BEGINNING.

PROPERTY ADDRESS W7915 TERRITORIAL RD.

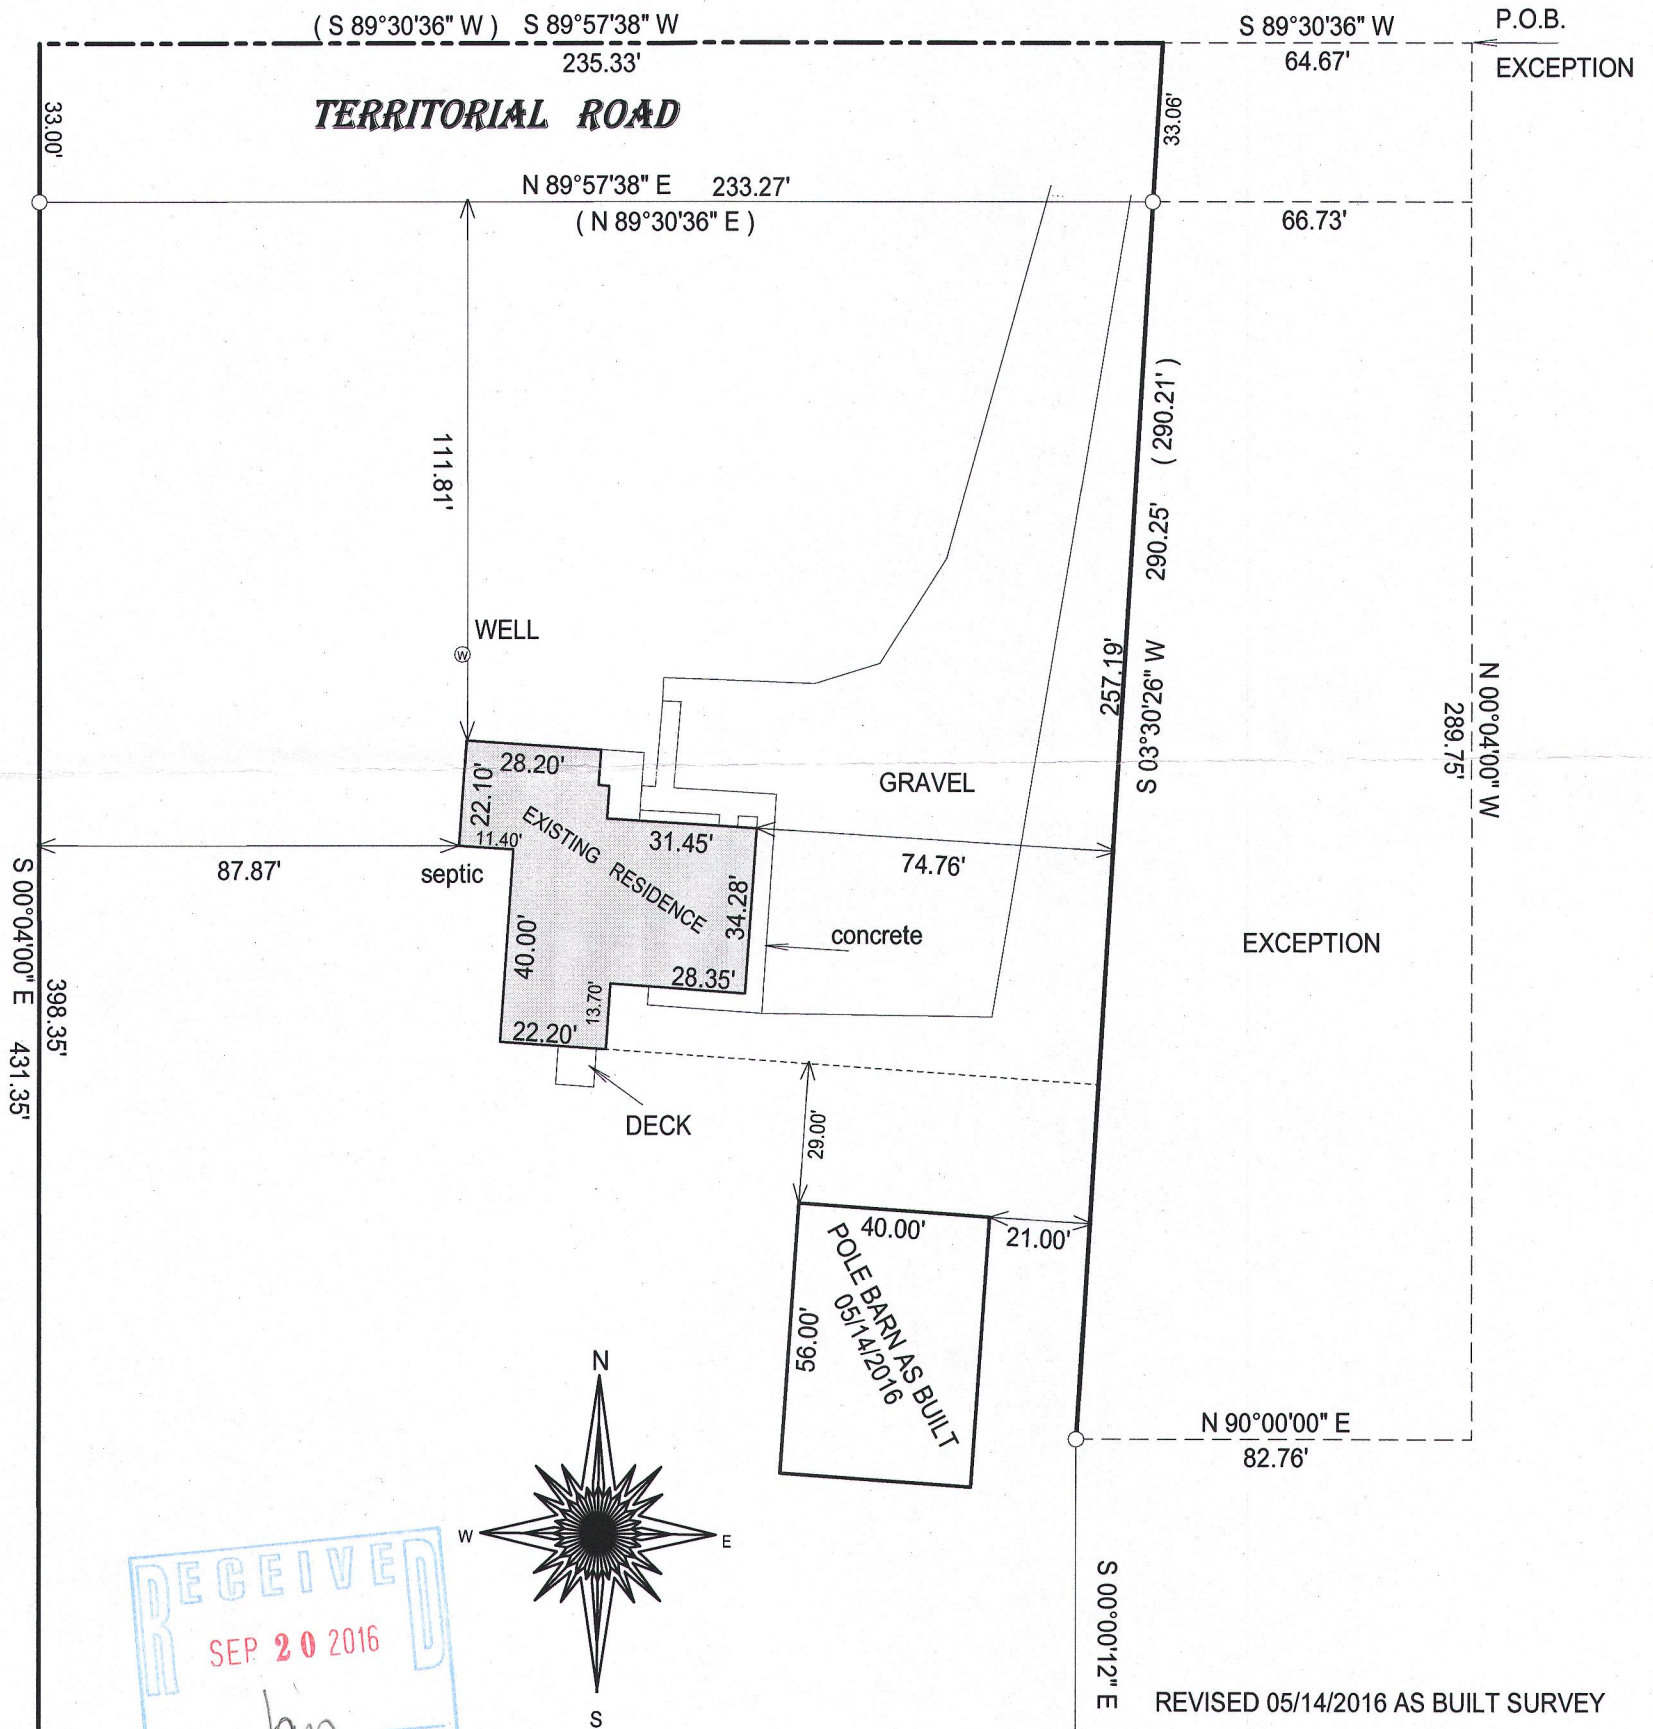

RECEIVED
 SEP 20 2016
 By: *Jan*

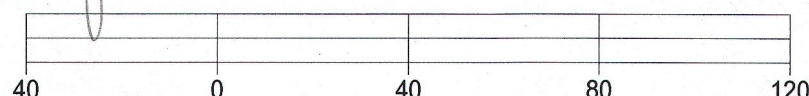

BASIS OF BEARING OF THIS PLAT: THE CERTIFIED SURVEY MAP OF RECORD.
 I hereby certify that I have surveyed the above- described property and the above map is a true representation thereof and shows the size and location of the property, its exterior boundaries, the location and dimensions of all structures thereon, fences, apparrant easements and roadways and visible encroachments if any.

This survey is made for the present owners of the property, and those who purchase, mortgage, or guarantee the title thereto, within one year from the date hereof.

DATED THIS 17TH DAY OF MARCH, 2015.

REVISED 05/14/2016 AS BUILT SURVEY
 revised 4-7-2016 added proposed shed

WISCONSIN
 JEFFREY L. KIMPS
 S-2436
 LAKE GENEVA, WIS.
 LAND SURVEYOR
 JEFFREY L. KIMPS S - 2436
 Wisconsin Registered Land Surveyor
 (original if signed in red)

() = recorded as
 □ = found iron bar
 ○ = found iron pipe
 ● = set iron pipe
 ■ = set iron bar
 SCALE 1" = 40'
 JOB # 15-56pg
 TAX ID #
 CA112200001