

PLAT OF SURVEY

LOT 2 OF CERTIFIED SURVEY MAP NO. 1365, RECORDED IN VOLUME 6 PAGES 208 AND 209 OF CERTIFIED SURVEY MAPS OF WALWORTH COUNTY, WISCONSIN AND LOCATED IN GOVERNMENT LOT 4 OF FRACTIONAL SECTION 9, T.3N., R.15E. OF THE 4TH P.M., TOWN OF RICHMOND, WALWORTH COUNTY, WISCONSIN.




STATE OF WISCONSIN
COUNTY OF ROCK SS.

I HEREBY CERTIFY THAT I HAVE SUPERVISED THE SURVEY OF THE PROPERTY DESCRIBED ABOVE FOR THE EXCLUSIVE USE OF EARTHSCAPE LANDSCAPING AND THAT TO THE BEST OF MY KNOWLEDGE AND BELIEF THE PLAT HEREON DRAWN CORRECTLY REPRESENTS SAID SURVEY AND ITS LOCATION AND COMPLIES WITH CHAPTER A-E7.

GIVEN UNDER MY HAND AND SEAL THIS 18th DAY OF SEPTEMBER, 2019, AT JANESVILLE, WISCONSIN.


Ronald J. Combs
Ronald J. Combs
P.L.S. Number 1330

If the surveyor's signature is not red in color, the map is a copy and may contain unauthorized alterations. The certification contained hereon shall not apply to any copies.

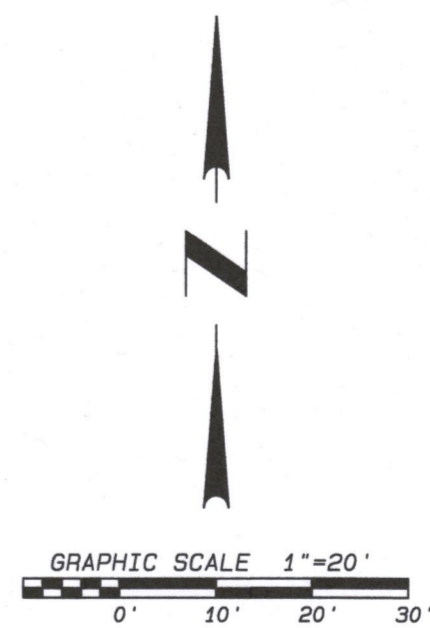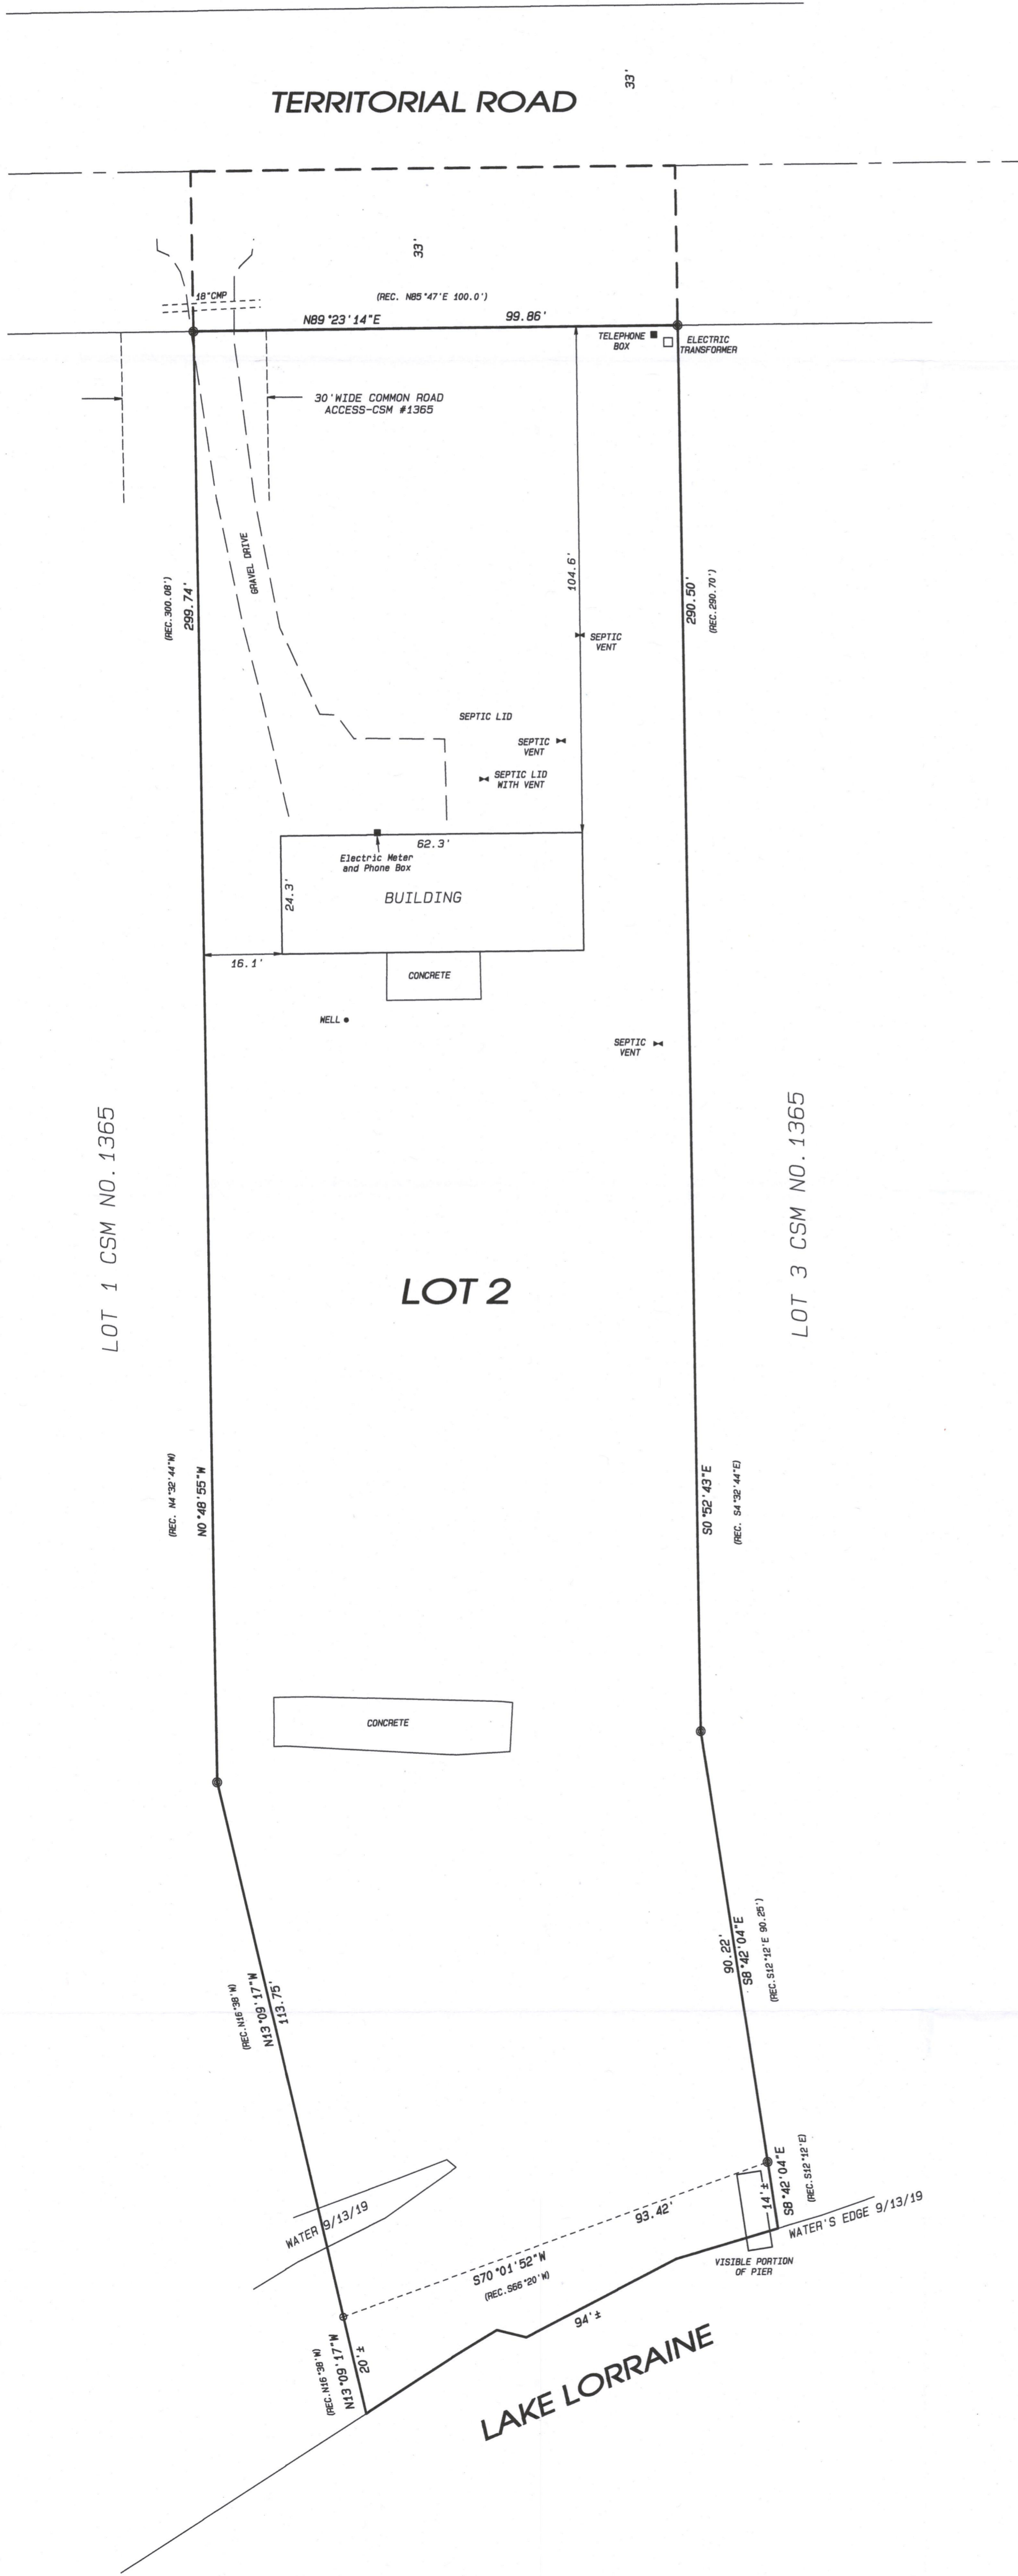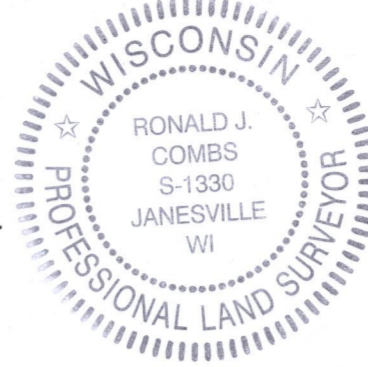

LEGEND:
○ SET IRON PIN, 3/4"x 24", 1.5 LBS./LIN. FT.
● FOUND 1" IRON PIPE

NOTES:
FIELDWORK COMPLETED SEPTEMBER 18TH, 2019.
THIS SURVEY IS SUBJECT TO ANY AND ALL EASEMENTS AND AGREEMENTS, RECORDED AND UNRECORDED.
ASSUMED N89°23'14"E ALONG THE NORTH LINE OF SAID LOT 2.

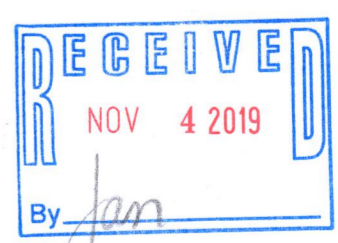

 109 W. Milwaukee St. Janesville, WI 53548 www.combsurvey.com	• LAND SURVEYING	DATE	09/18/19
	• LAND PLANNING	BY	sll
	• CIVIL ENGINEERING	PROJECT NO.	119-404
		CLIENT	REED