


Plat of Survey

of

Lot 1 of Certified Survey Map No. 2100,


recorded in Vol. 10 of Certified Survey Maps of Walworth County on Page 90 and located in the Southwest 1/4 of the Southwest 1/4 of Section 22, Town 3 North, Range 15 East, Town of Richmond, Walworth County, Wisconsin.

Surveyed for: **Wisconsin Lamb**
N5784 Johnson Road
Delavan, Wisconsin. 53115

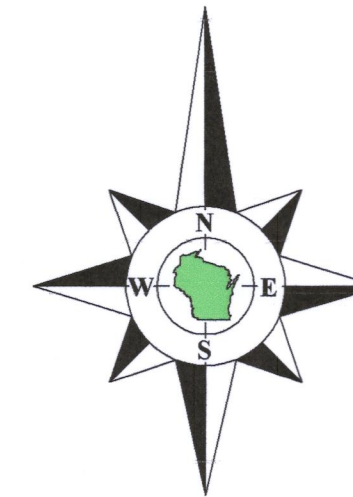


Bearings referenced to the West line of the Southwest 1/4 of Section 22-3-15, recorded as N0°51'03"E on Certified Survey Map No. 2100. A rotation of 3°15' 22" from the Wisconsin State Plane Coordinate System, South Zone, (NAD-27).

Coordinates are referenced to the Wisconsin State Plane Coordinate System, South Zone, (NAD-27).

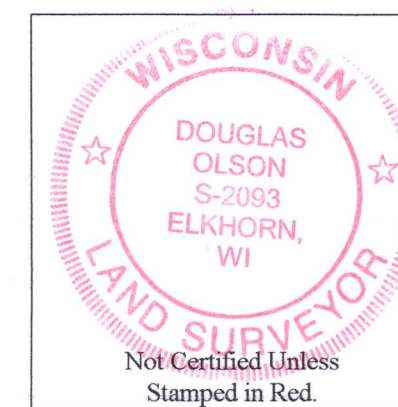

Notes:

- 1) This Plat of Survey is not certified unless signed and sealed in red ink.
- 2) This survey is subject to Wisconsin lien laws. This Plat of Survey is the notice of intent to file lien. Lien waiver required.
- 3) The Survey Date shown on this Plat of Survey is the completion date of the field work.

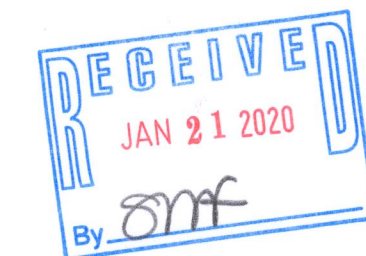

Copyright ©2019 by Olson Land Surveying, LLC.

All rights reserved. No part of this survey plat may be reproduced or transmitted in any form by any means - graphic, electronic, or mechanical, including photocopying, tracing, or information storage and retrieval systems - without permission in writing from Douglas G. Olson, Olson Land Surveying, LLC.

I hereby certify that I have surveyed the above described property in compliance with Chapter A-E 7 of the Wisconsin Administrative Code and that the map hereon is correct to the best of my professional knowledge and belief and shows the size and location of the property, its exterior boundaries, the location and dimensions of all visible structures thereon, boundary fences, apparent easements and roadways and visible encroachments, if any.

This survey is made for the exclusive use of the present owners of the property, and also those who purchase, mortgage or guarantee title thereto, within one year from the date hereof.


Douglas G. Olson
Wisconsin Professional Land Surveyor - 2093

Tax Parcel
CR 2200004A

Tax Parcel
CR 2200005A

Tax Parcel
CR 2200005A


Lot 1
Tax Parcel
CA210000001
4.985 Acres
217,130 Sq.Ft.
4.650 Acres
202,563 Sq.Ft.
Exclusive of R.O.W.

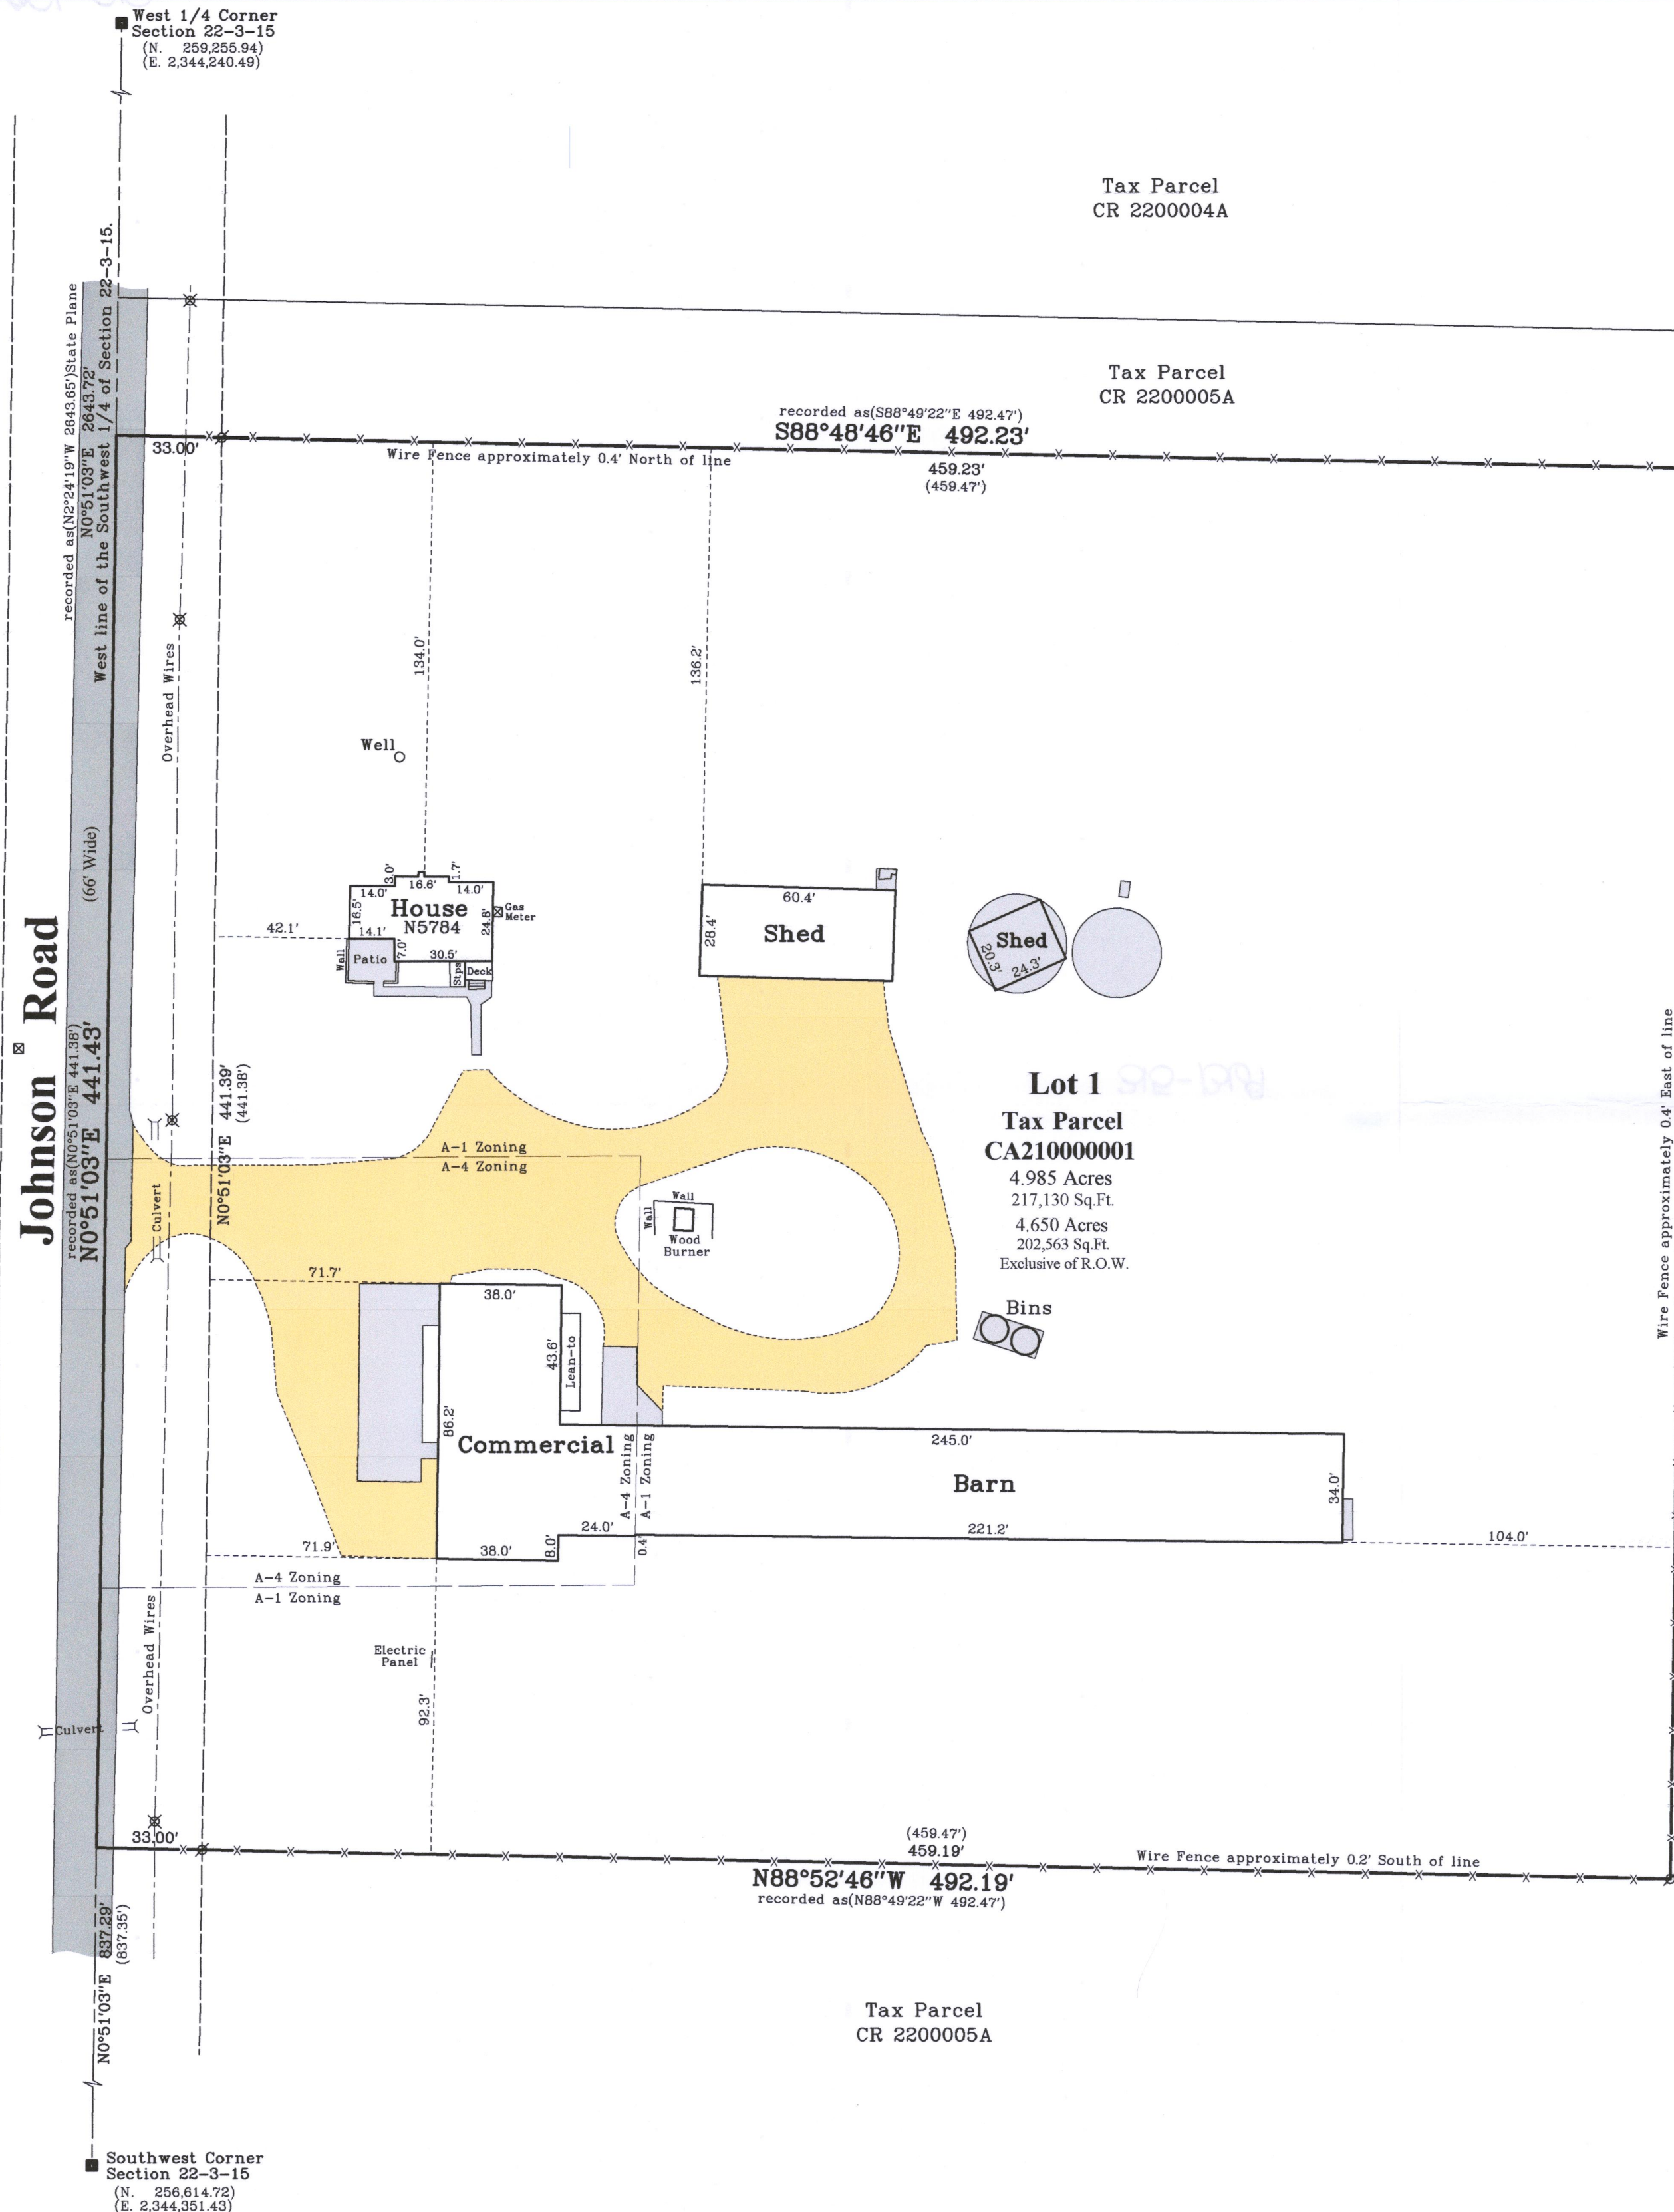

Survey Date: January 2, 2020
Revisions:



45 South Wisconsin Street | P.O. Box 322
Elkhorn, Wisconsin. 53121
Telephone: (262) 723-3434
Facsimile: (262) 723-8044
Email: doug@olsonsurveying.com
Website: www.olsonsurveying.com

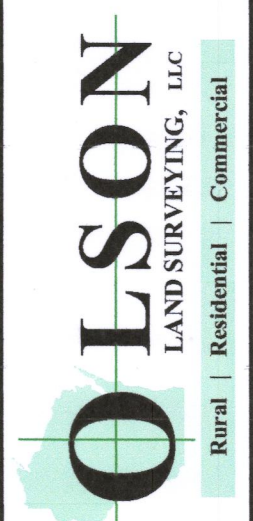

Legend of Symbols & Abbreviations

N	North
S	South
E	East
W	West
°	Degrees
'	Minutes
"	Seconds
---	In Distances
---	In Feet
---	In Inches

Found County Section Corner
Found Iron Pipe
Recorded Information
Utility Pole
Utility Pedestal
Asphalt Surface
Concrete Surface
Gravel Surface

Sheet 1 of 1 Sheets
Drawing Name:
Job Reference Number
2019.076

2019.076

CA2100-1

315-1309