


**PLAT OF SURVEY**  
-OF-

LOT 6 OF "HILLSIDE TRAILS", A SUBDIVISION LOCATED IN PART OF THE NORTHWEST 1/4 AND NORTHEAST 1/4 OF THE SOUTHWEST 1/4 OF SECTION 1, TOWNSHIP 3 NORTH, RANGE 15 EAST OF THE FOURTH PRINCIPAL MERIDIAN, IN THE TOWN OF RICHMOND, COUNTY OF WALWORTH AND STATE OF WISCONSIN.

SURVEY FOR: MAURICIO CASTANEDA  
SURVEY ADDRESS: N7037 HILLSIDE COURT, DELAVAN, WI 53115

**HILLSIDE COURT**

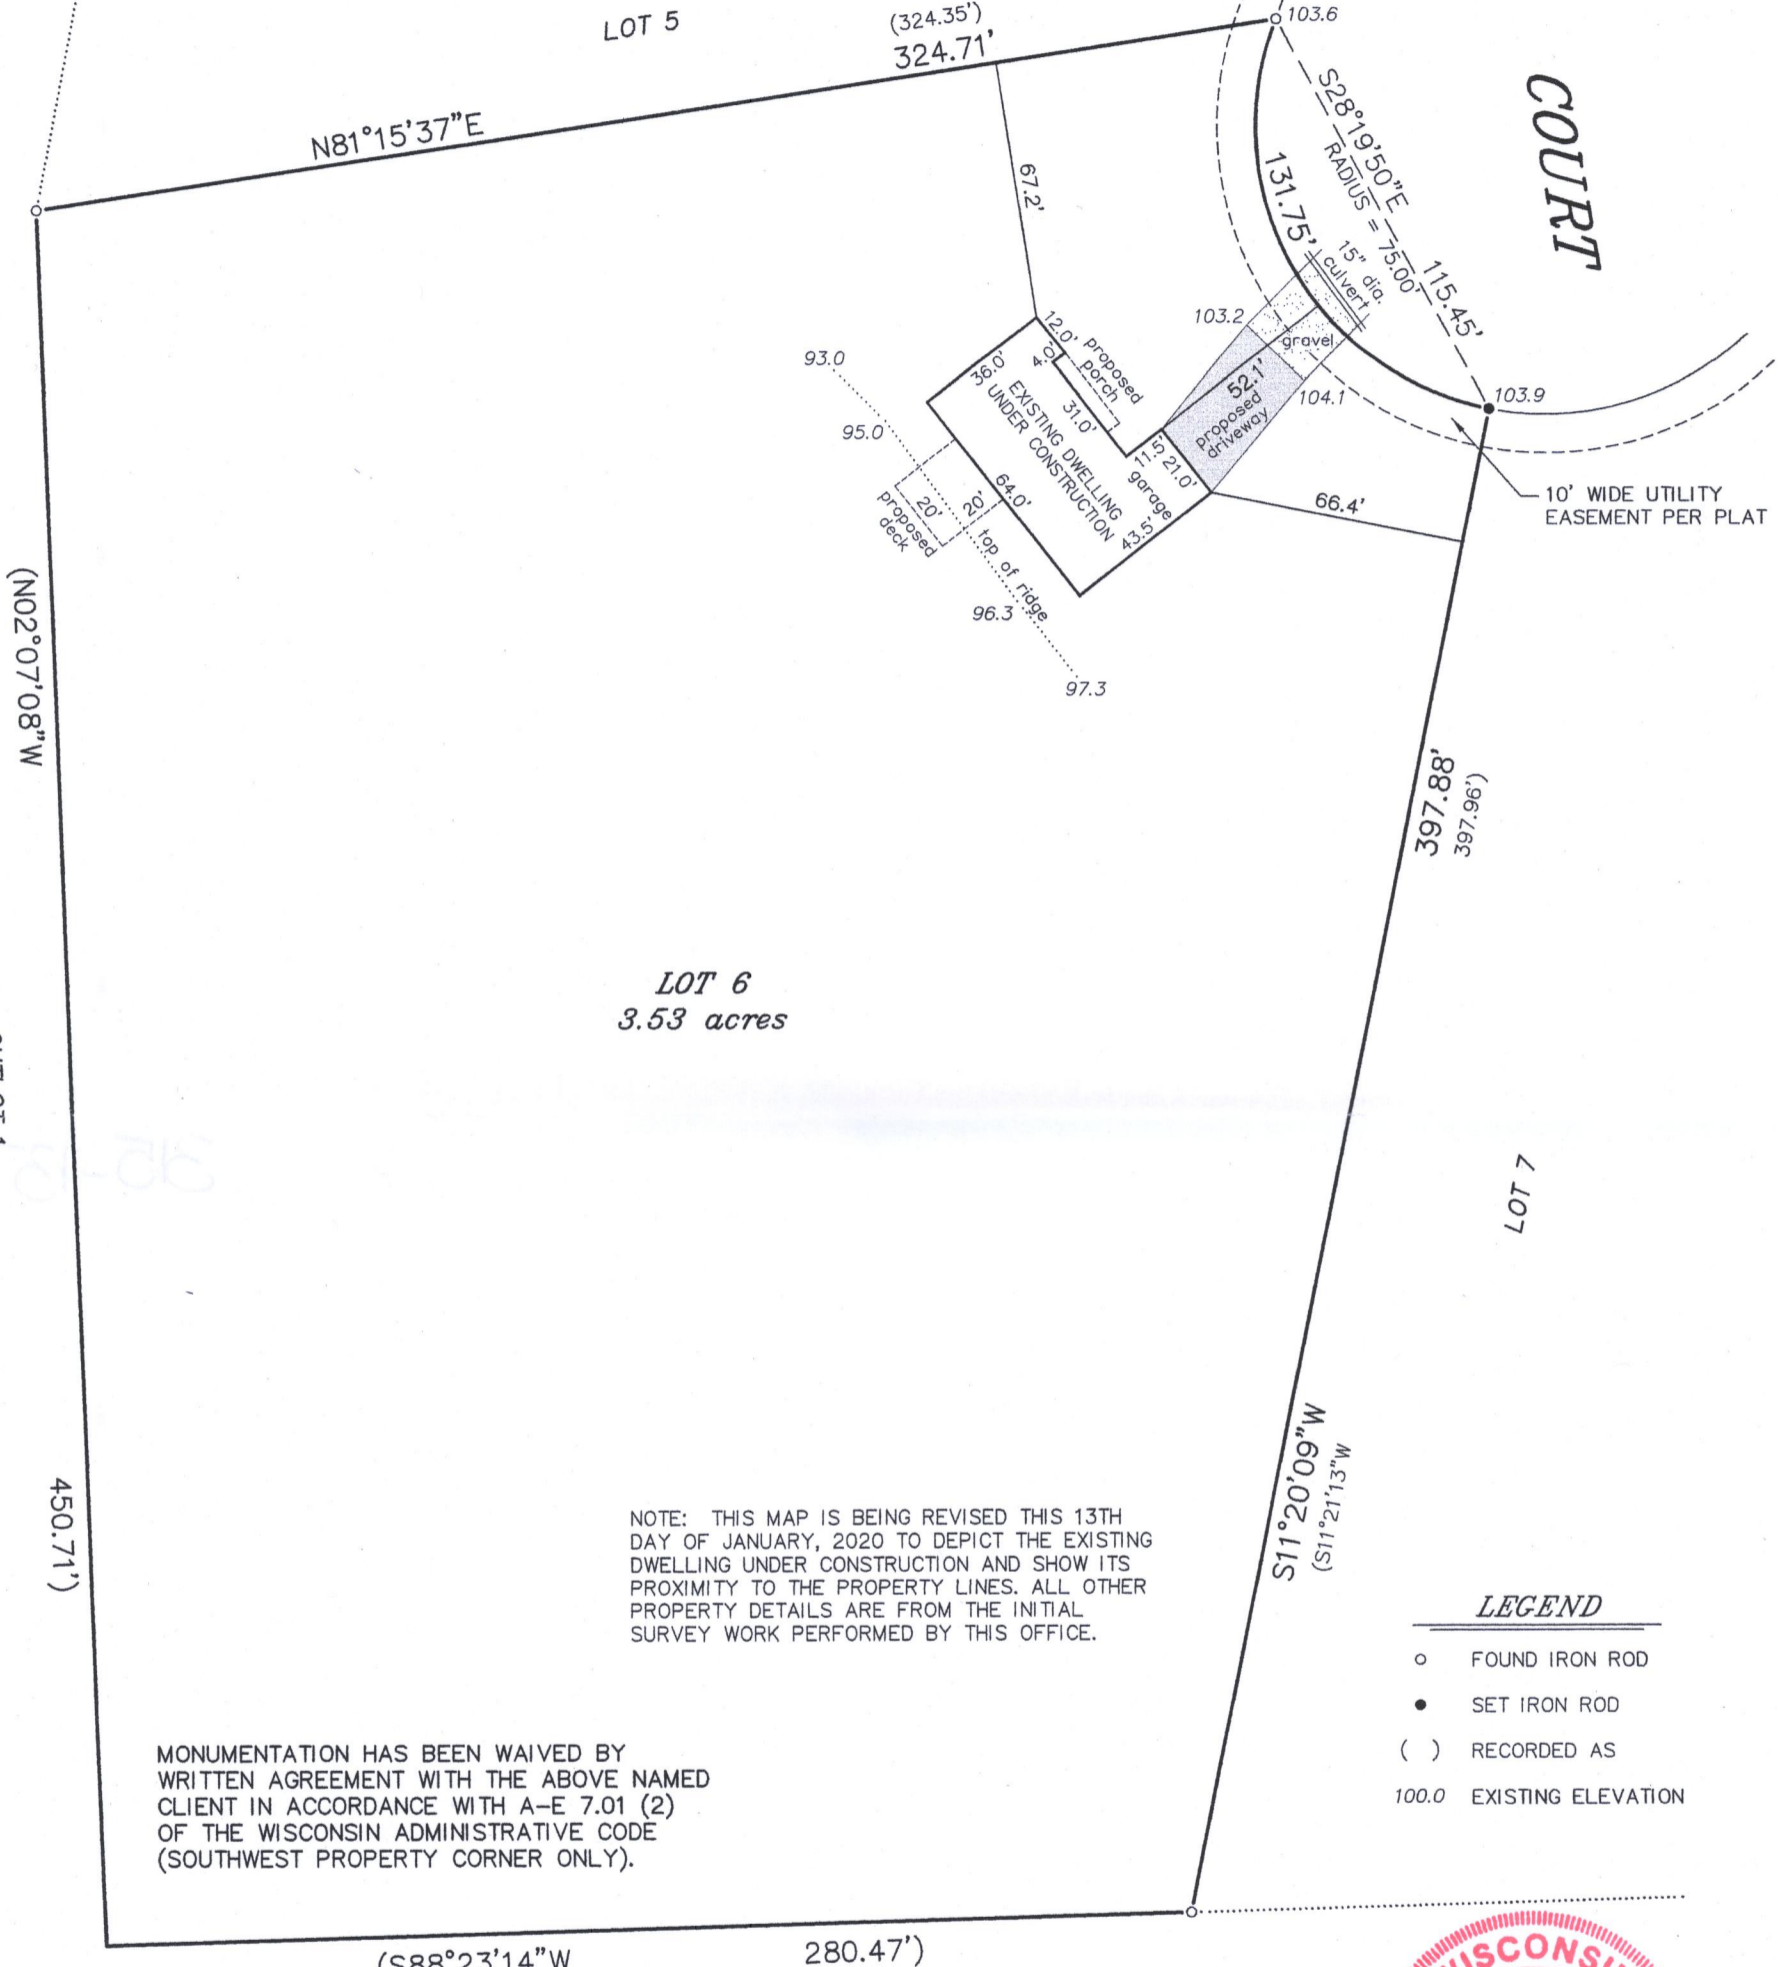

**LOT 6**  
3.53 acres

NOTE: THIS MAP IS BEING REVISED THIS 13TH DAY OF JANUARY, 2020 TO DEPICT THE EXISTING DWELLING UNDER CONSTRUCTION AND SHOW ITS PROXIMITY TO THE PROPERTY LINES. ALL OTHER PROPERTY DETAILS ARE FROM THE INITIAL SURVEY WORK PERFORMED BY THIS OFFICE.

MONUMENTATION HAS BEEN WAIVED BY WRITTEN AGREEMENT WITH THE ABOVE NAMED CLIENT IN ACCORDANCE WITH A-E 7.01 (2) OF THE WISCONSIN ADMINISTRATIVE CODE (SOUTHWEST PROPERTY CORNER ONLY).

**LEGEND**


- FOUND IRON ROD
- SET IRON ROD
- ( ) RECORDED AS
- 100.0 EXISTING ELEVATION

NOTE: REFER TO A CURRENT TITLE REPORT FOR EASEMENTS, RESTRICTIONS OR COVENANTS WHICH MAY AFFECT THIS PROPERTY.



"I HEREBY CERTIFY THAT I HAVE SURVEYED THE ABOVE DESCRIBED PROPERTY AND THAT THE ABOVE MAP IS A CORRECT REPRESENTATION THEREOF AND SHOWS THE SIZE AND LOCATION OF THE PROPERTY, ITS EXTERIOR BOUNDARIES, THE LOCATION OF ALL VISIBLE STRUCTURES AND DIMENSIONS OF ALL PRINCIPAL BUILDINGS THEREON, BOUNDARY FENCES, APPARENT EASEMENTS, ROADWAYS AND ENCROACHMENTS, IF ANY."

"THIS SURVEY IS MADE FOR THE USE OF THE PRESENT OWNERS OF THE PROPERTY, AND THOSE WHO PURCHASE, MORTGAGE, OR GUARANTEE THE TITLE THERETO WITHIN ONE YEAR FROM DATE HEREOF."

**SATTER SURVEYING, LLC**  
LAND SURVEYS, MAPPING AND PLANNING  
272 ORIGEN STREET  
BURLINGTON, WI 53105  
262-661-4239

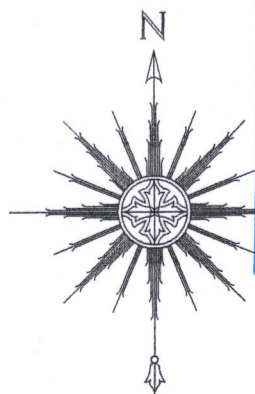

BEARINGS HEREON RELATE TO THE NORTH LINE OF LOT 6 OF HILLSIDE TRAILS SUBDIVISION. ASSUMED BEARING OF NORTH 81°15'37" EAST AS PLATTED.

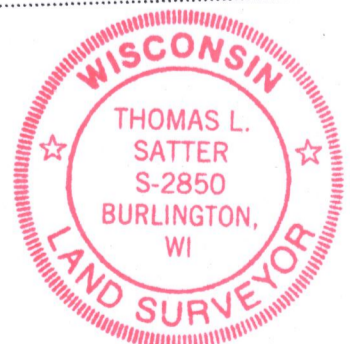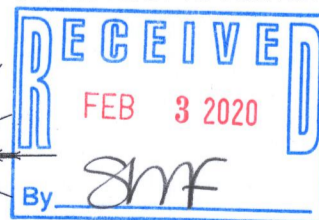


THIS IS NOT AN ORIGINAL PRINT UNLESS THIS SEAL IS RED.

*Thomas L. Satter*  
THOMAS L. SATTER S-2850

REVISED: 1/13/20  
REVISED: 9/24/19  
SEPTEMBER 16, 2019  
DATE

081906  
JOB NUMBER

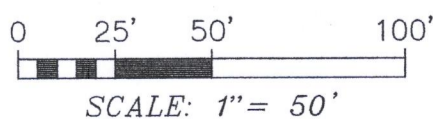

CHIL-6

315-1371121