


GEORGE T. DUNHAM
SURVEYING & SUBDIVIDING
DELAVER, WISCONSIN

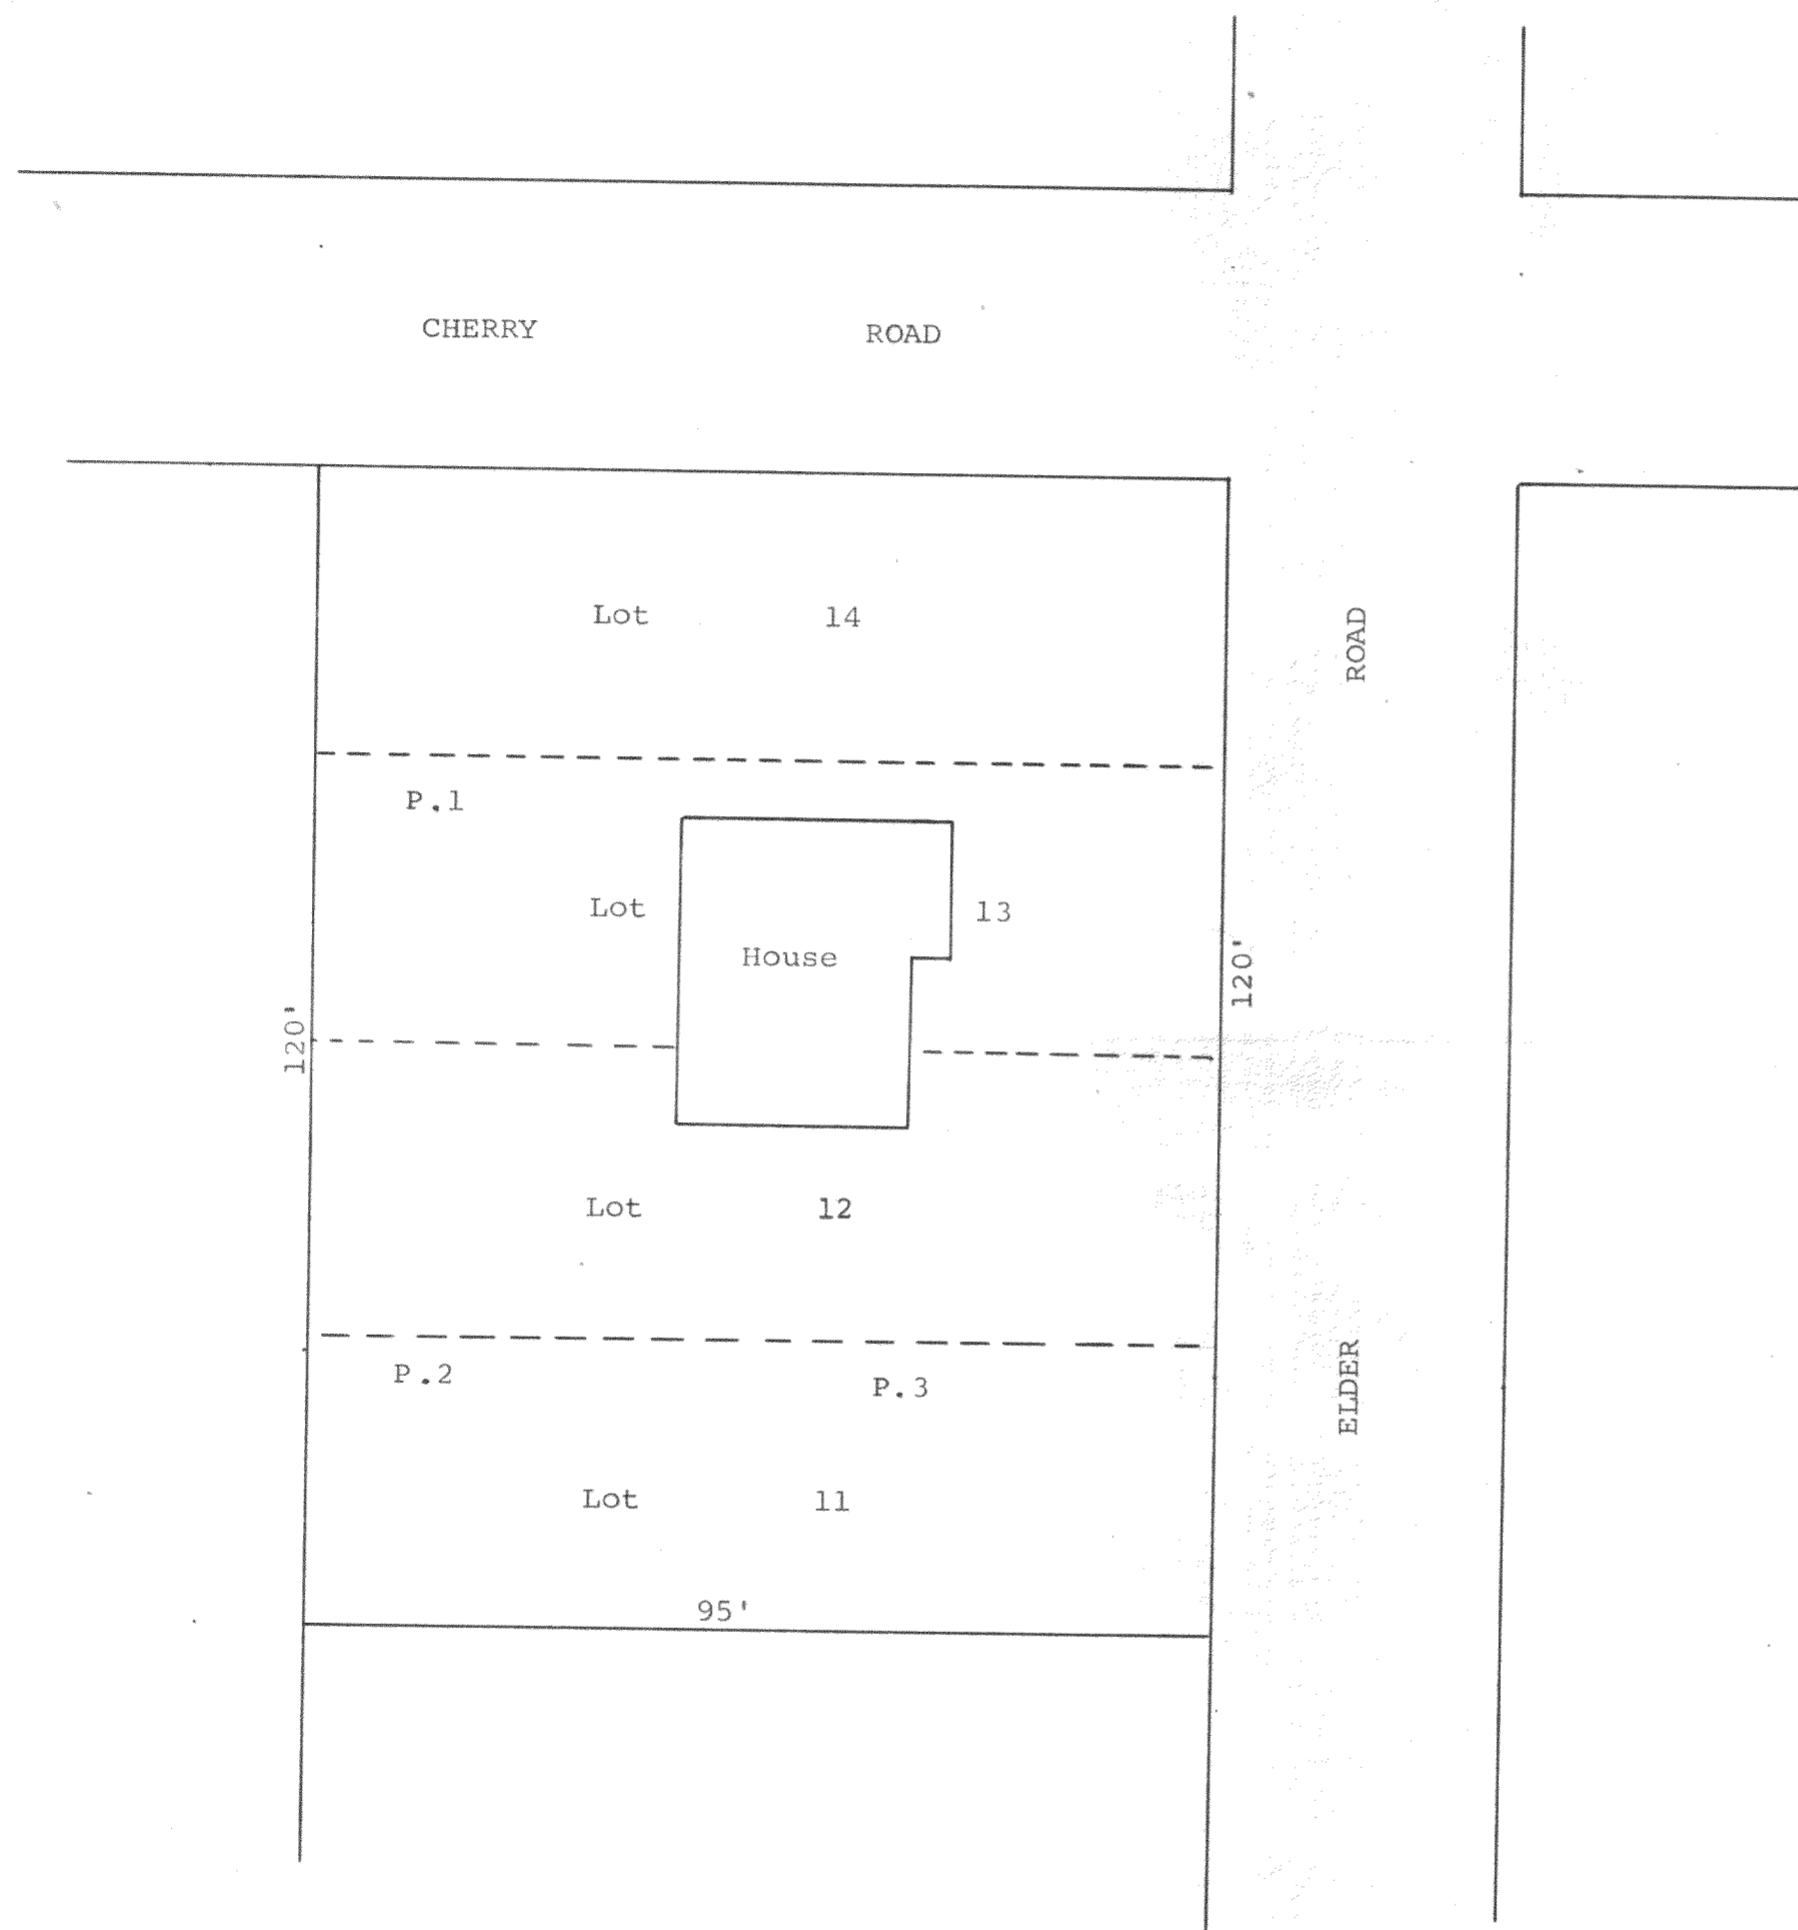

N

Scale - 1" = 20'

CS-357

Plat showing the location of the percolation tests made on the Paul Coleman property located on Lots 11-14, Block 24 of Skansen Swedish Tribune News Subdivision located in Section 9, T 3 N, R 15 E, Walworth County, Wisconsin. June 13, 1967

George T. Dunham
George T. Dunham, Surveyor

315-19