


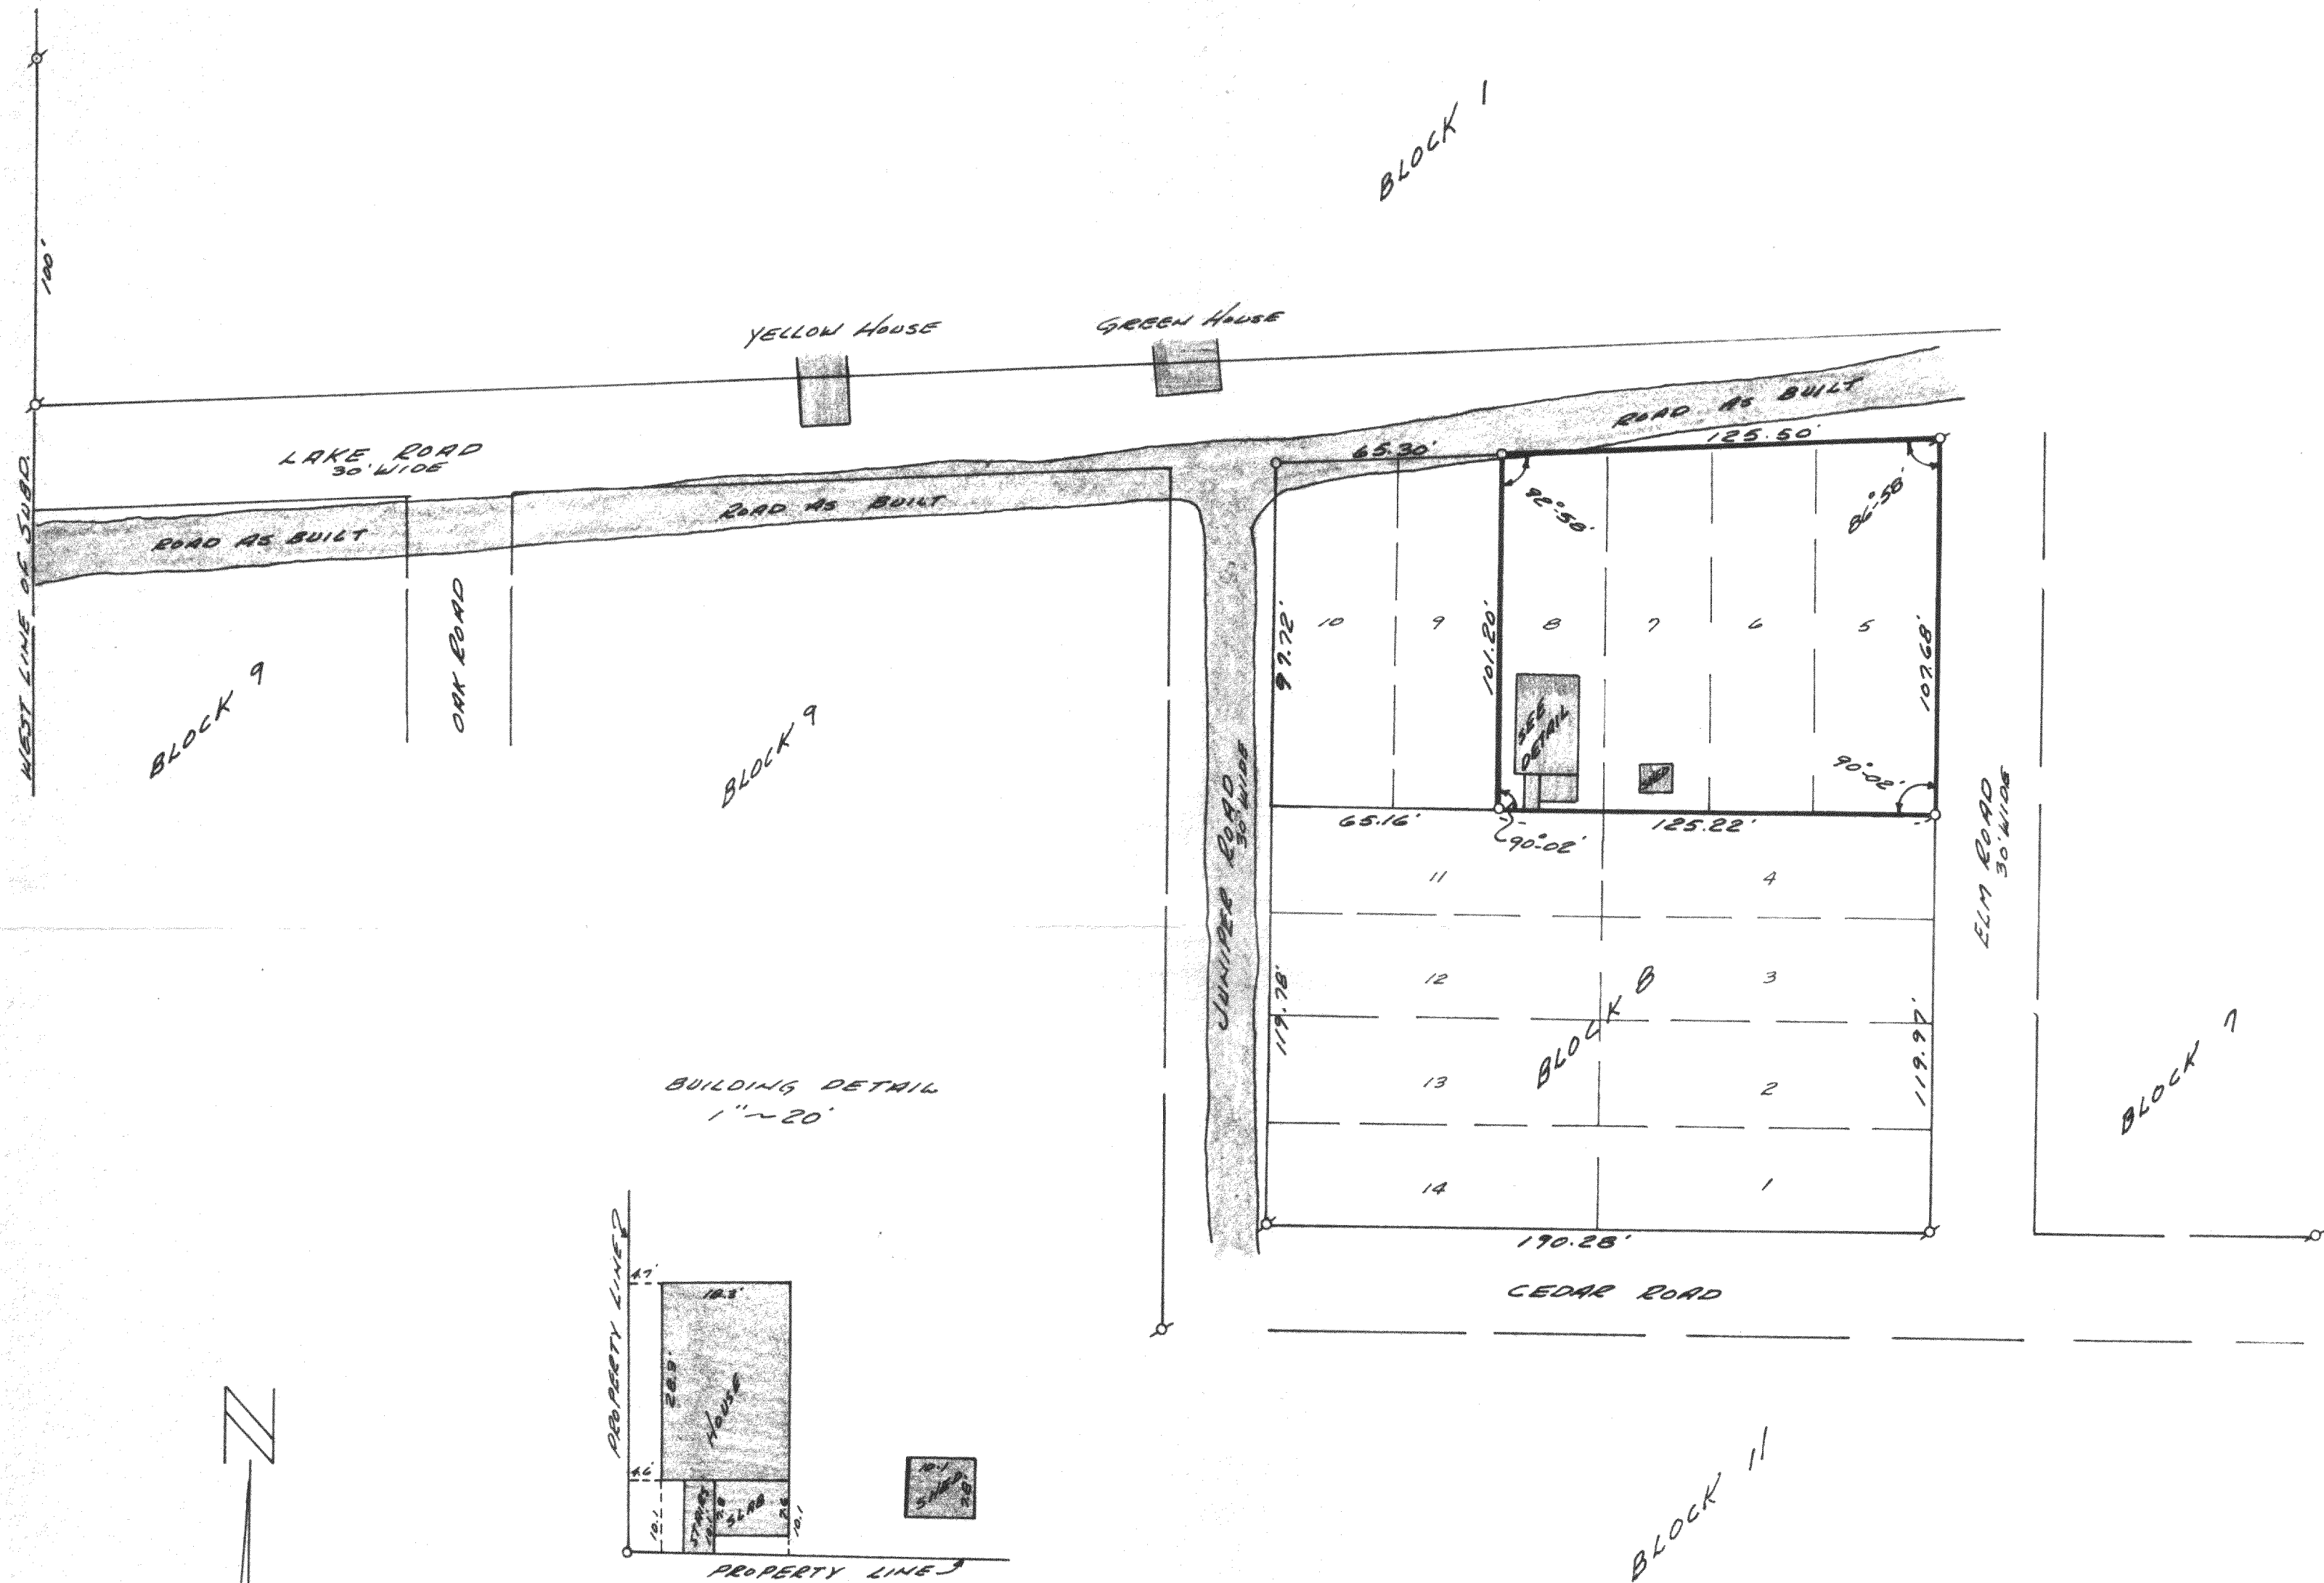

PLAT OF SURVEY OF

LOTS 5, 6, 7, AND 8, BLOCK 8 SKANSEN
SUBDIVISION LOCATED IN SECTION 9,
T3N R15E WALWORTH COUNTY,
WISCONSIN.

C2-135

Lloyd L. Jensen
SURVEYOR

SCALE 1" = 40'

DATE MAY 1971