


RECEIVED
AUG 19 1986
J. L.



Surveyed For:
Wayne Gottwald, Trustee
Wayne Gottwald Trust
8129 Westport Lane
Willow Springs, Ill. 60480

Richard C. Schulz
Richard C. Schulz, Surveyor

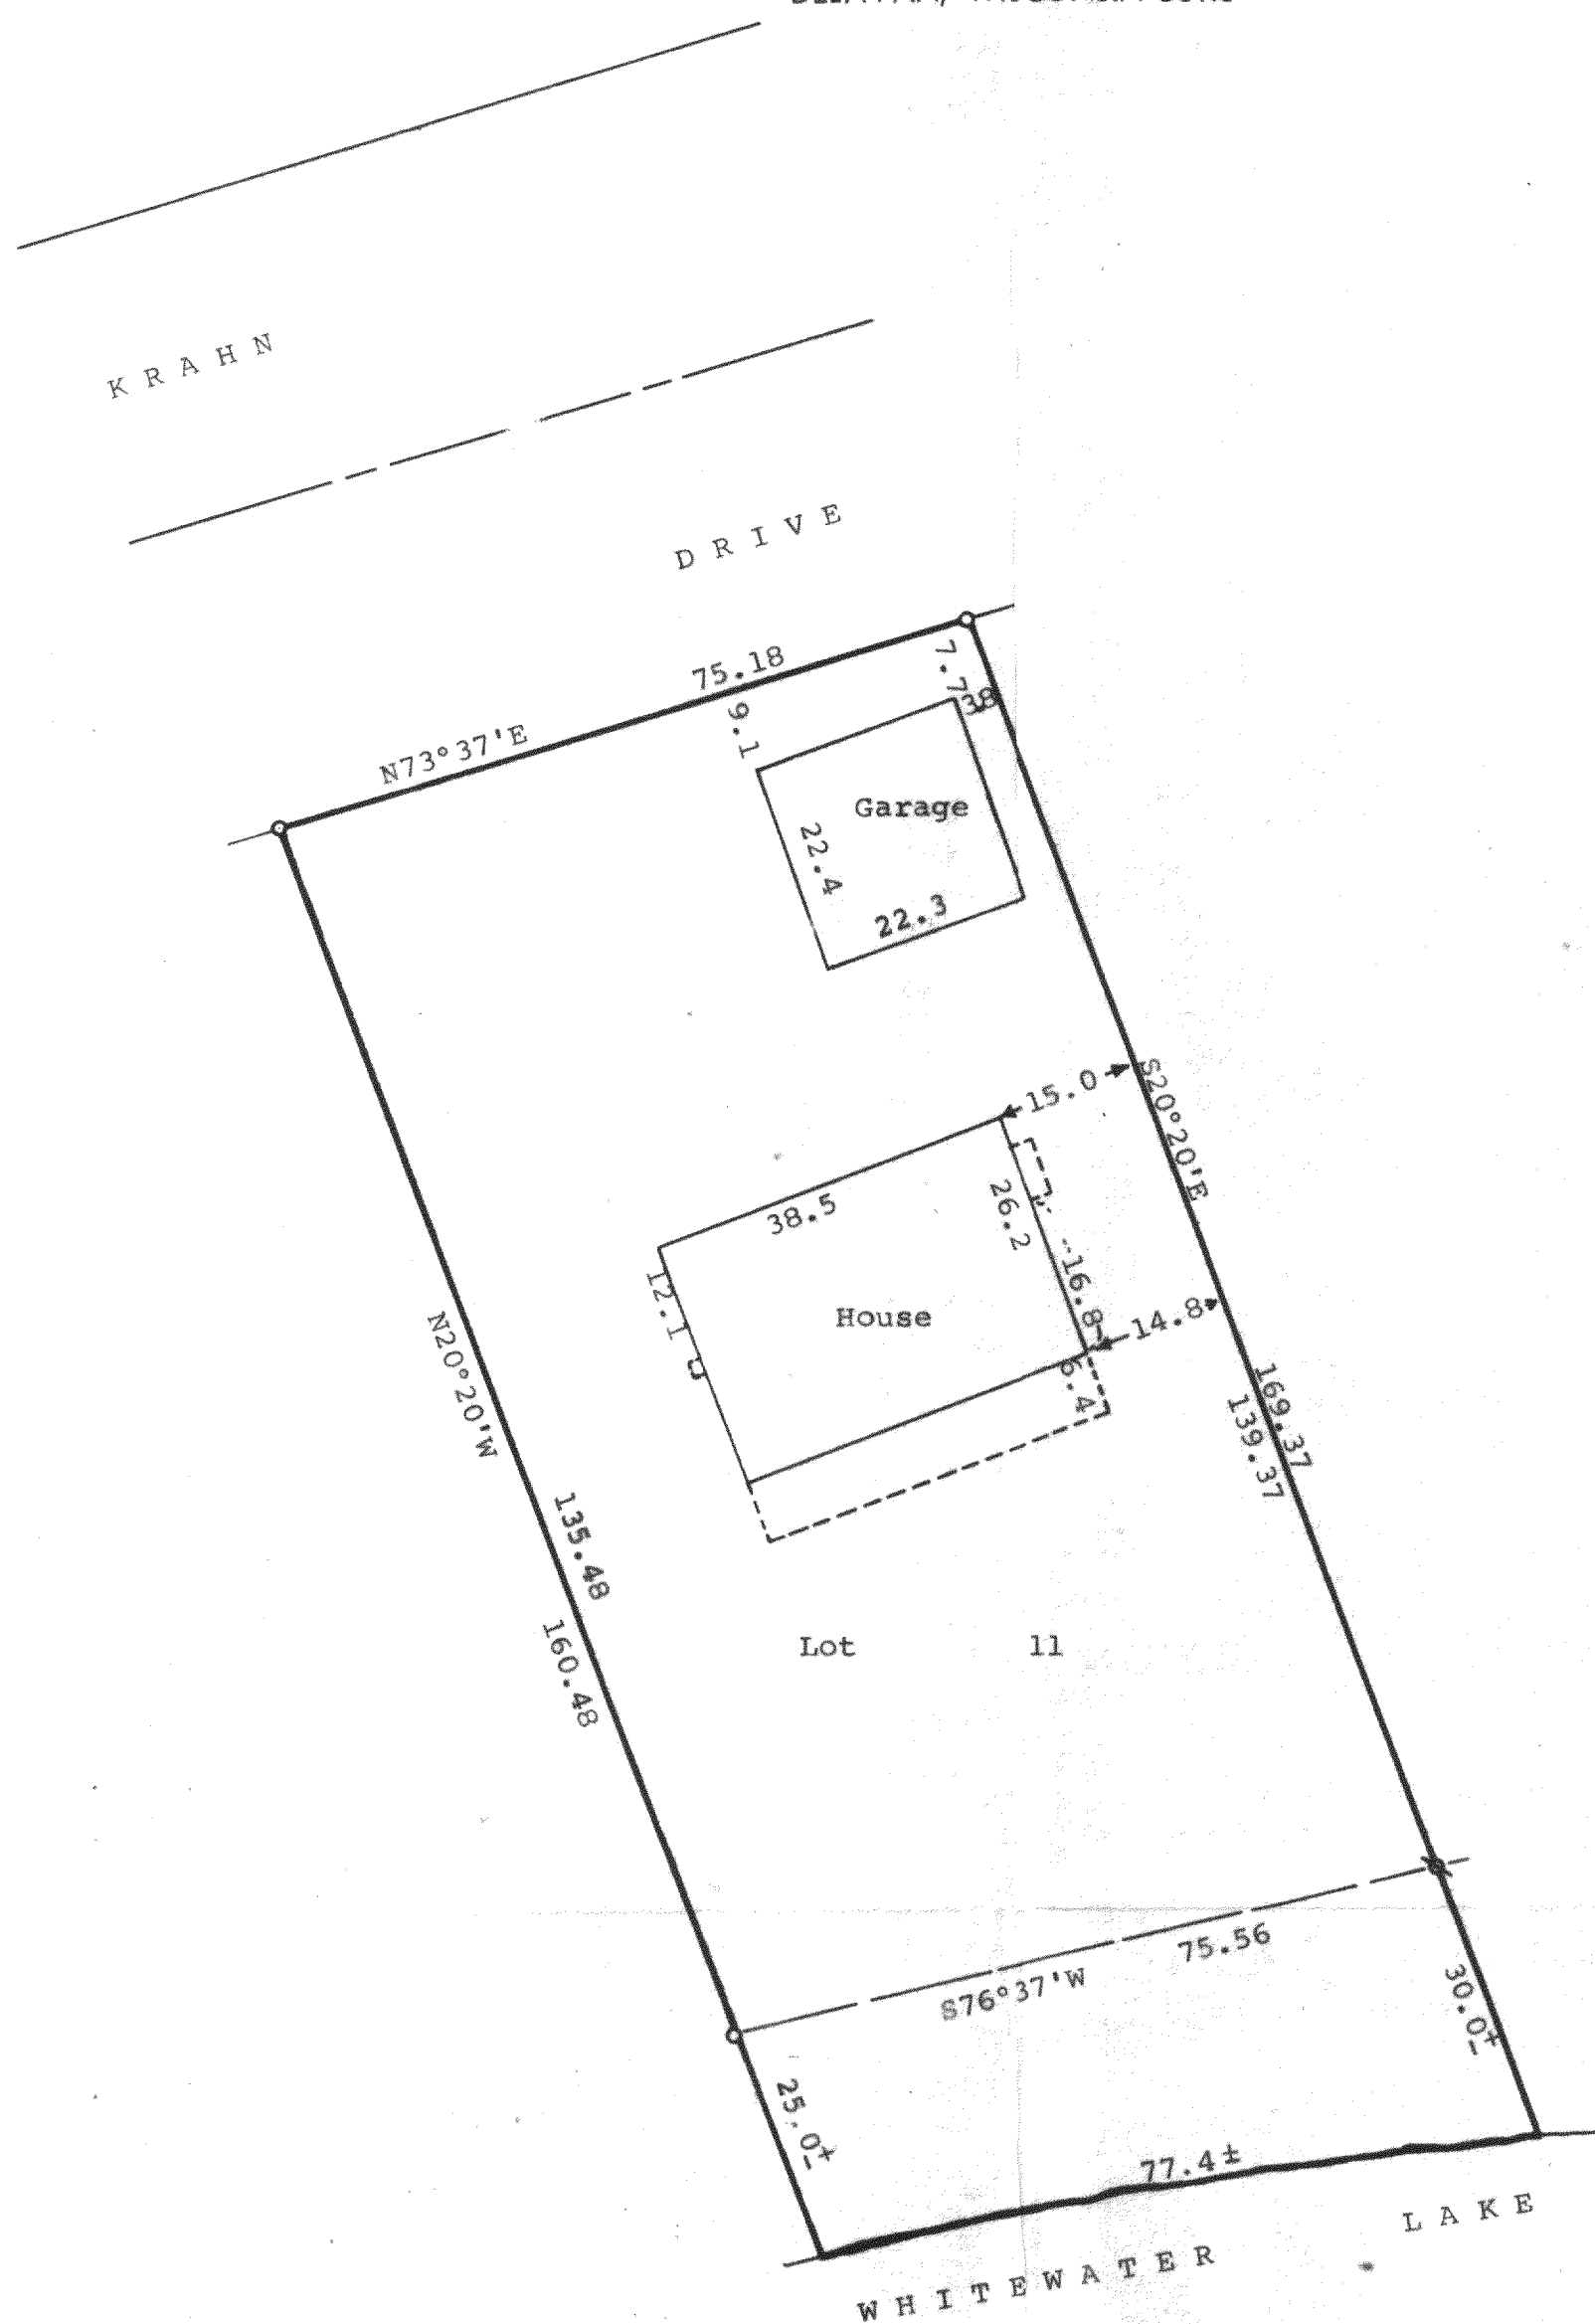