



D. D. COOPER & CO., INC.
 Daniel D. Cooper
 Rt. 4 Box 508B
 Elkhorn, WI 53121

Plat of Survey of Lot 3 of Block 2
 Richmond Heights, being located in
 the town of Richmond, Walworth
 County Wisconsin.

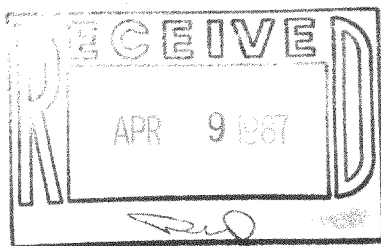

Bearing Reference: Northerly line of
 property assumed to bear N67°16'E as
 previously recorded.

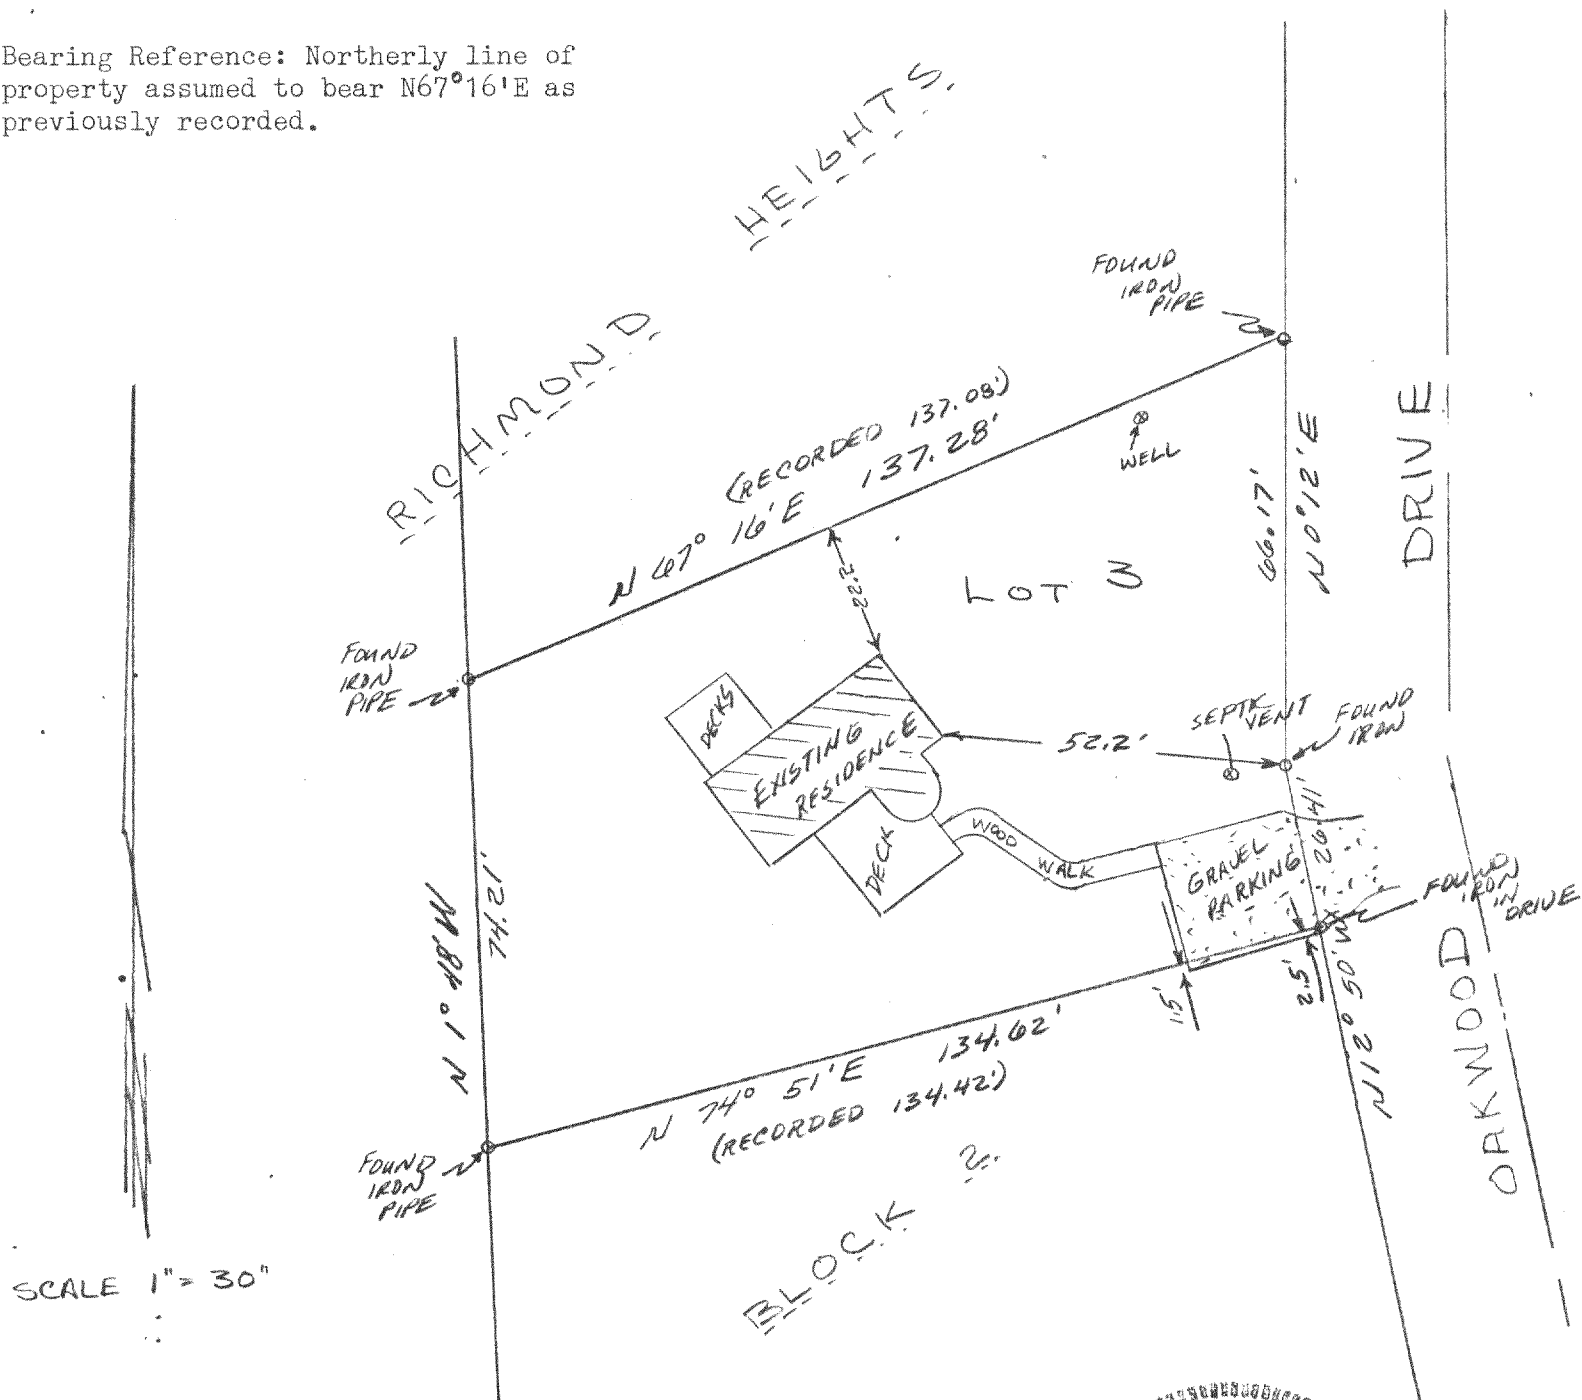


I hereby certify that I have surveyed the property described hereon
 and that the above map is a true and accurate representation
 thereof to the best of my professional knowledge and belief.

Dated this 25 day of March, 1987

Daniel D. Cooper

Daniel D. Cooper, RLS NO. S-1464

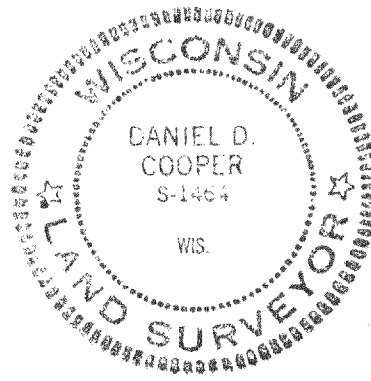

Survey ordered by Century 21
 Whitewater WI.