



D. D. COOPER & CO., INC.
Daniel D. Cooper
Rt. 4 Box 508B
Elkhorn, WI 53121

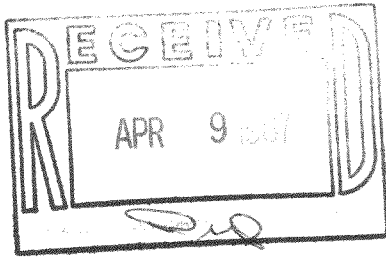

Plat of Survey of Lot 6, Block 6 Chapel Hills
Subdivision, being located in the Town of
Richmond, Walworth County, Wisconsin

Bearing reference: Westerly Line of Chapel
Drive assumed to bear
N12 53'W as recorded

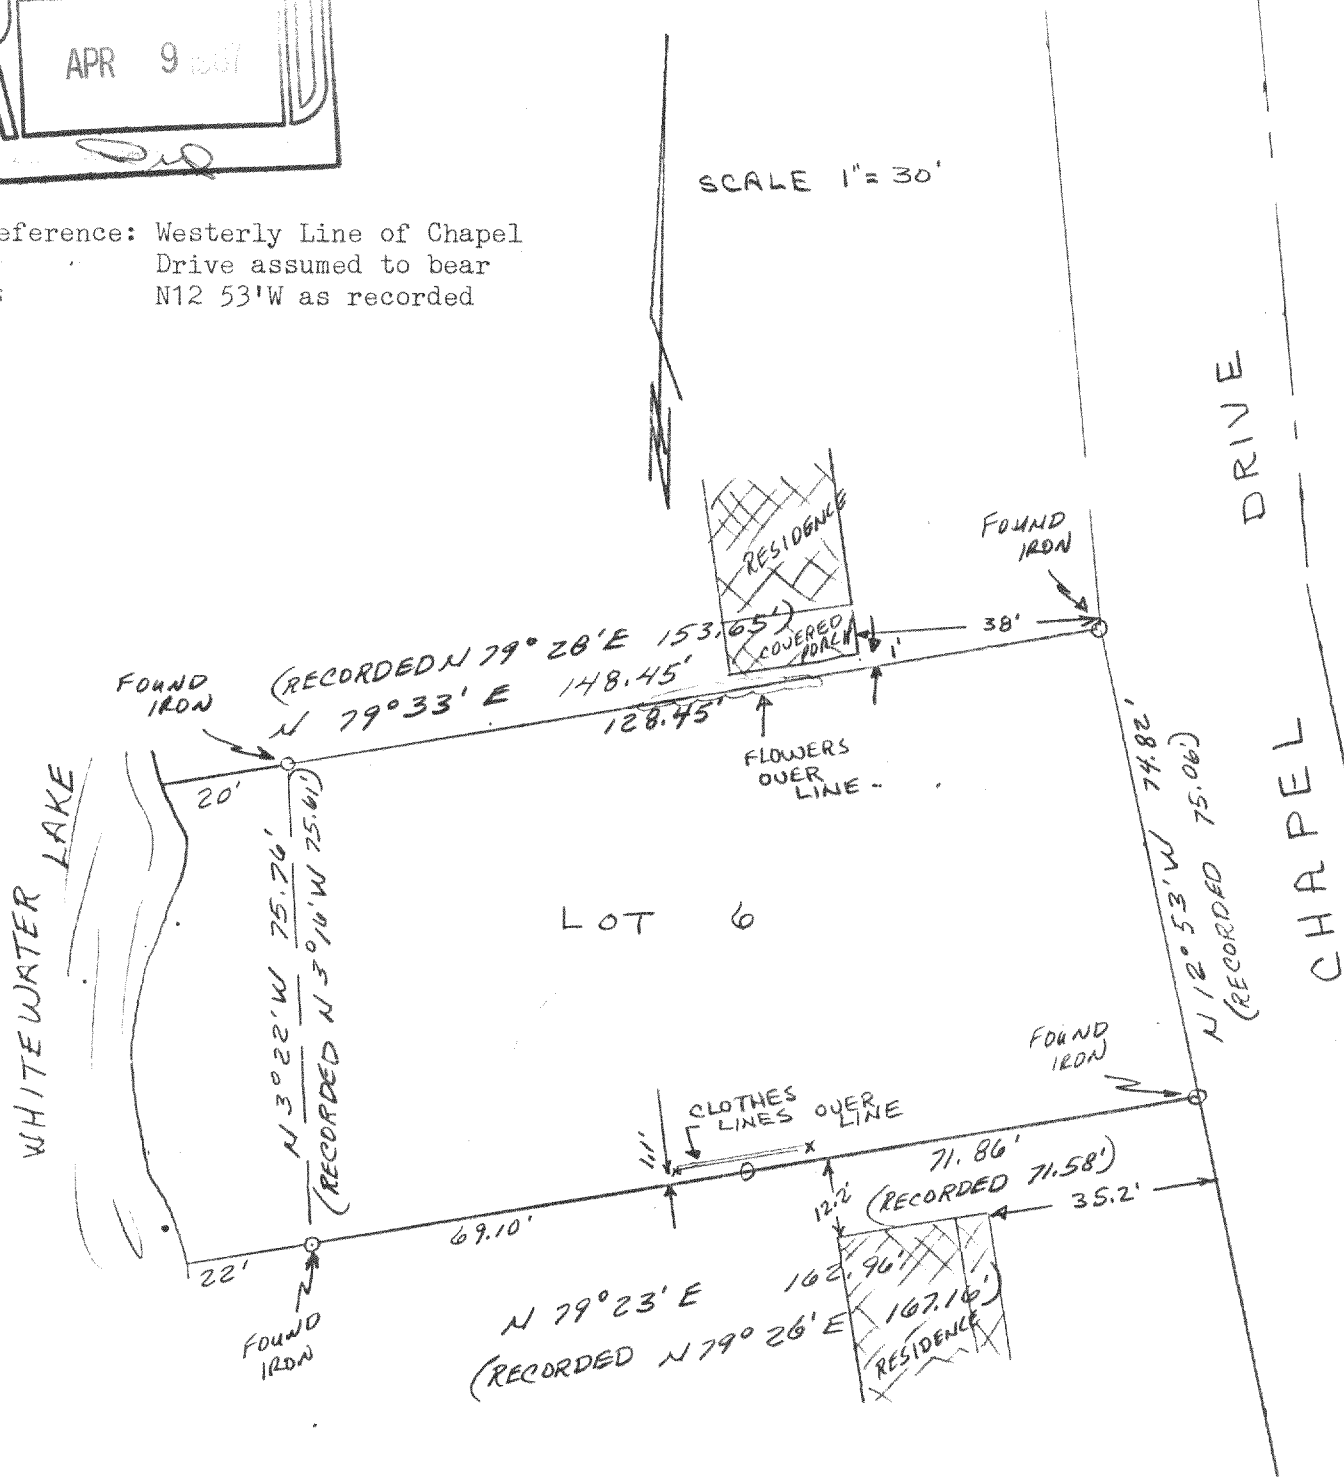

Survey ordered by Rummel-Devitt & Ass.
Whitewater WI

I hereby certify that I have surveyed the property described hereon
and that the above map is a true and accurate representation thereof
to the best of my professional knowledge and belief.

Dated this 23 day of Mar., 1987

Daniel D. Cooper
Daniel D. Cooper, RLS No S-1464

