
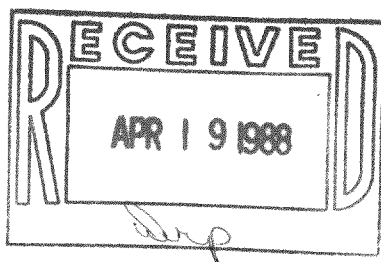


**D.D. COOPER & CO. INC.**


Route 4 Box 508B  
Elkhorn WI 53121  
Phone-414-723-6265

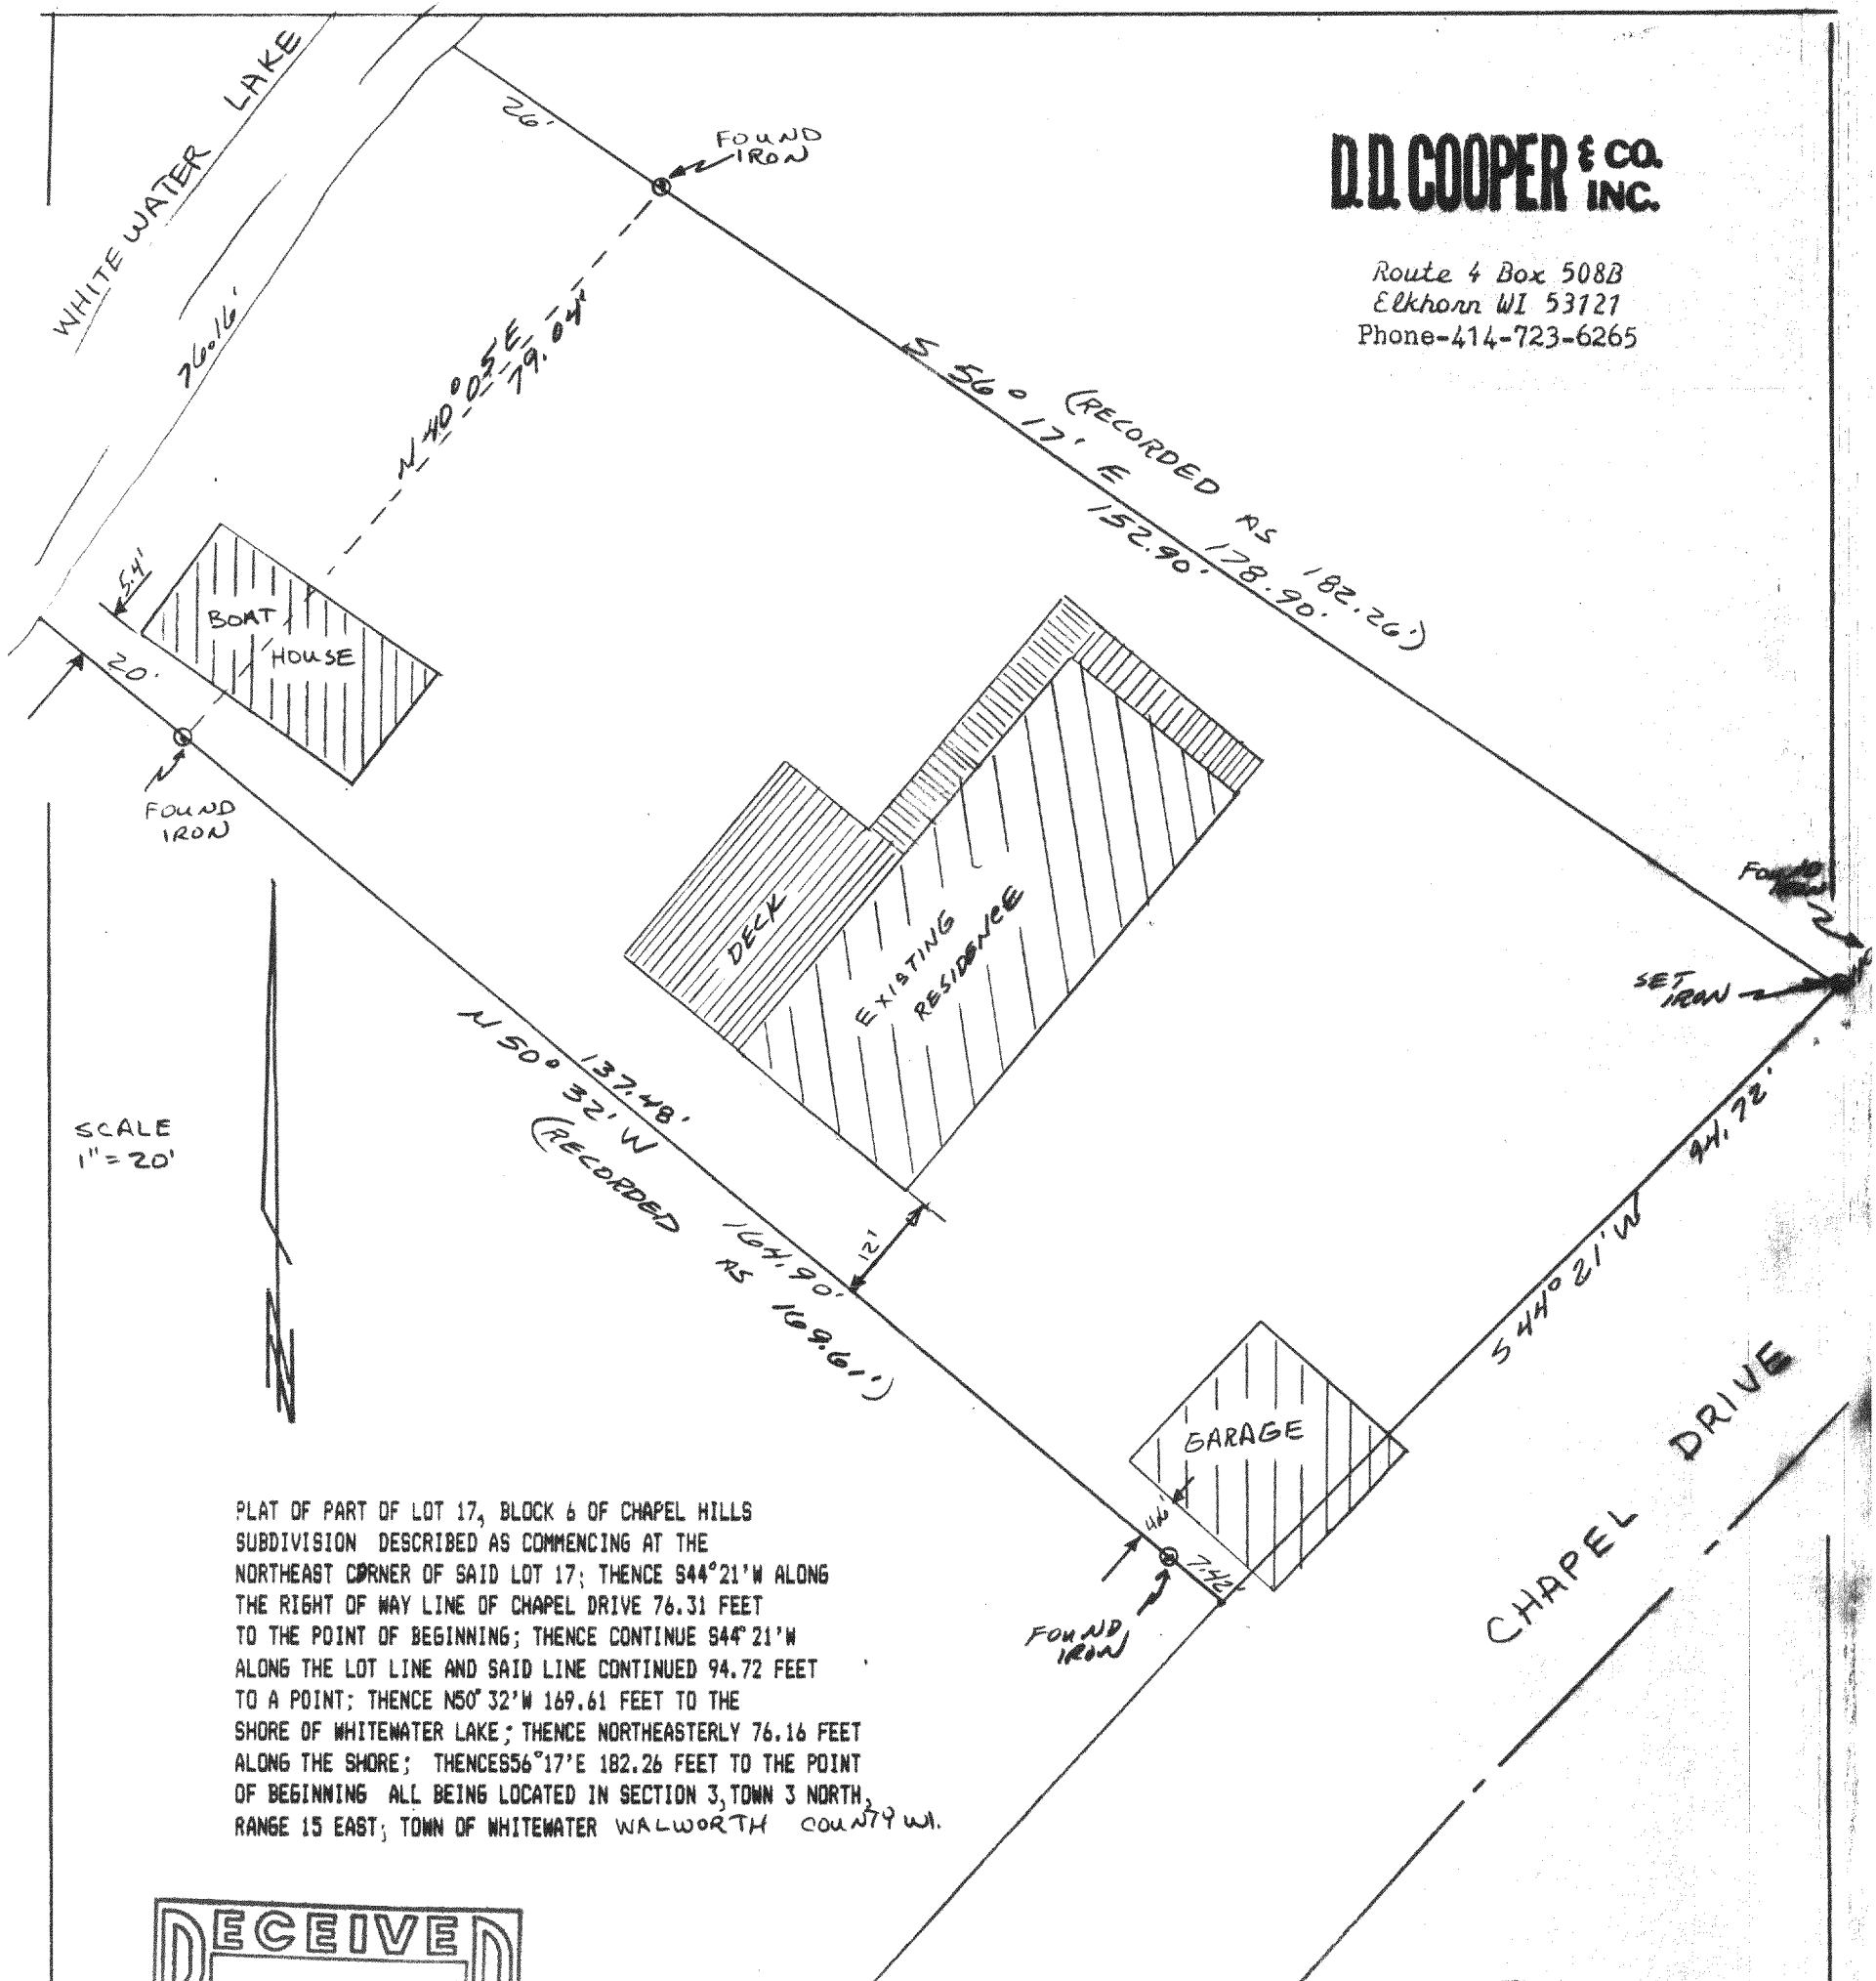

I, DANIEL D. COOPER, REGISTERED SURVEYOR, DO HEREBY CERTIFY THAT I HAVE SURVEYED THE PROPERTY DESCRIBED HEREON AND THAT THE MAP SHOWN HEREON IS A TRUE AND ACCURATE REPRESENTATION THEROF TO THE BEST OF MY PROFESSIONAL KNOWLEDGE AND BELIEF.

DATED THIS 20 DAY OF April, 1986

*Daniel D. Cooper*  
DANIEL D. COOPER, RLS NO. S-1464

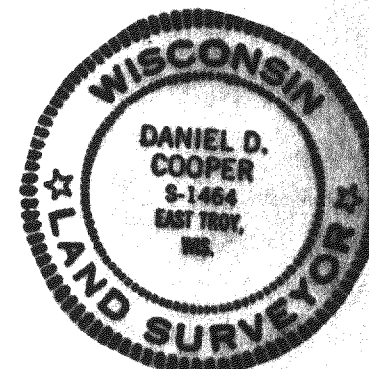

SURVEY ORDERED BY  
FIRST FINANCIAL

BEARING REFERENCE  
NORTHERLY LINE OF CHAPEL DRIVE ASSUMED  
TO BEAR S44 21'W AS PREVIOUSLY RECORDED

DRAWING NO. 2161