


DUNHAM SURVEYING, S.C.  
SURVEYING & SUBDIVIDING  
DELAVAN, WISCONSIN 53115

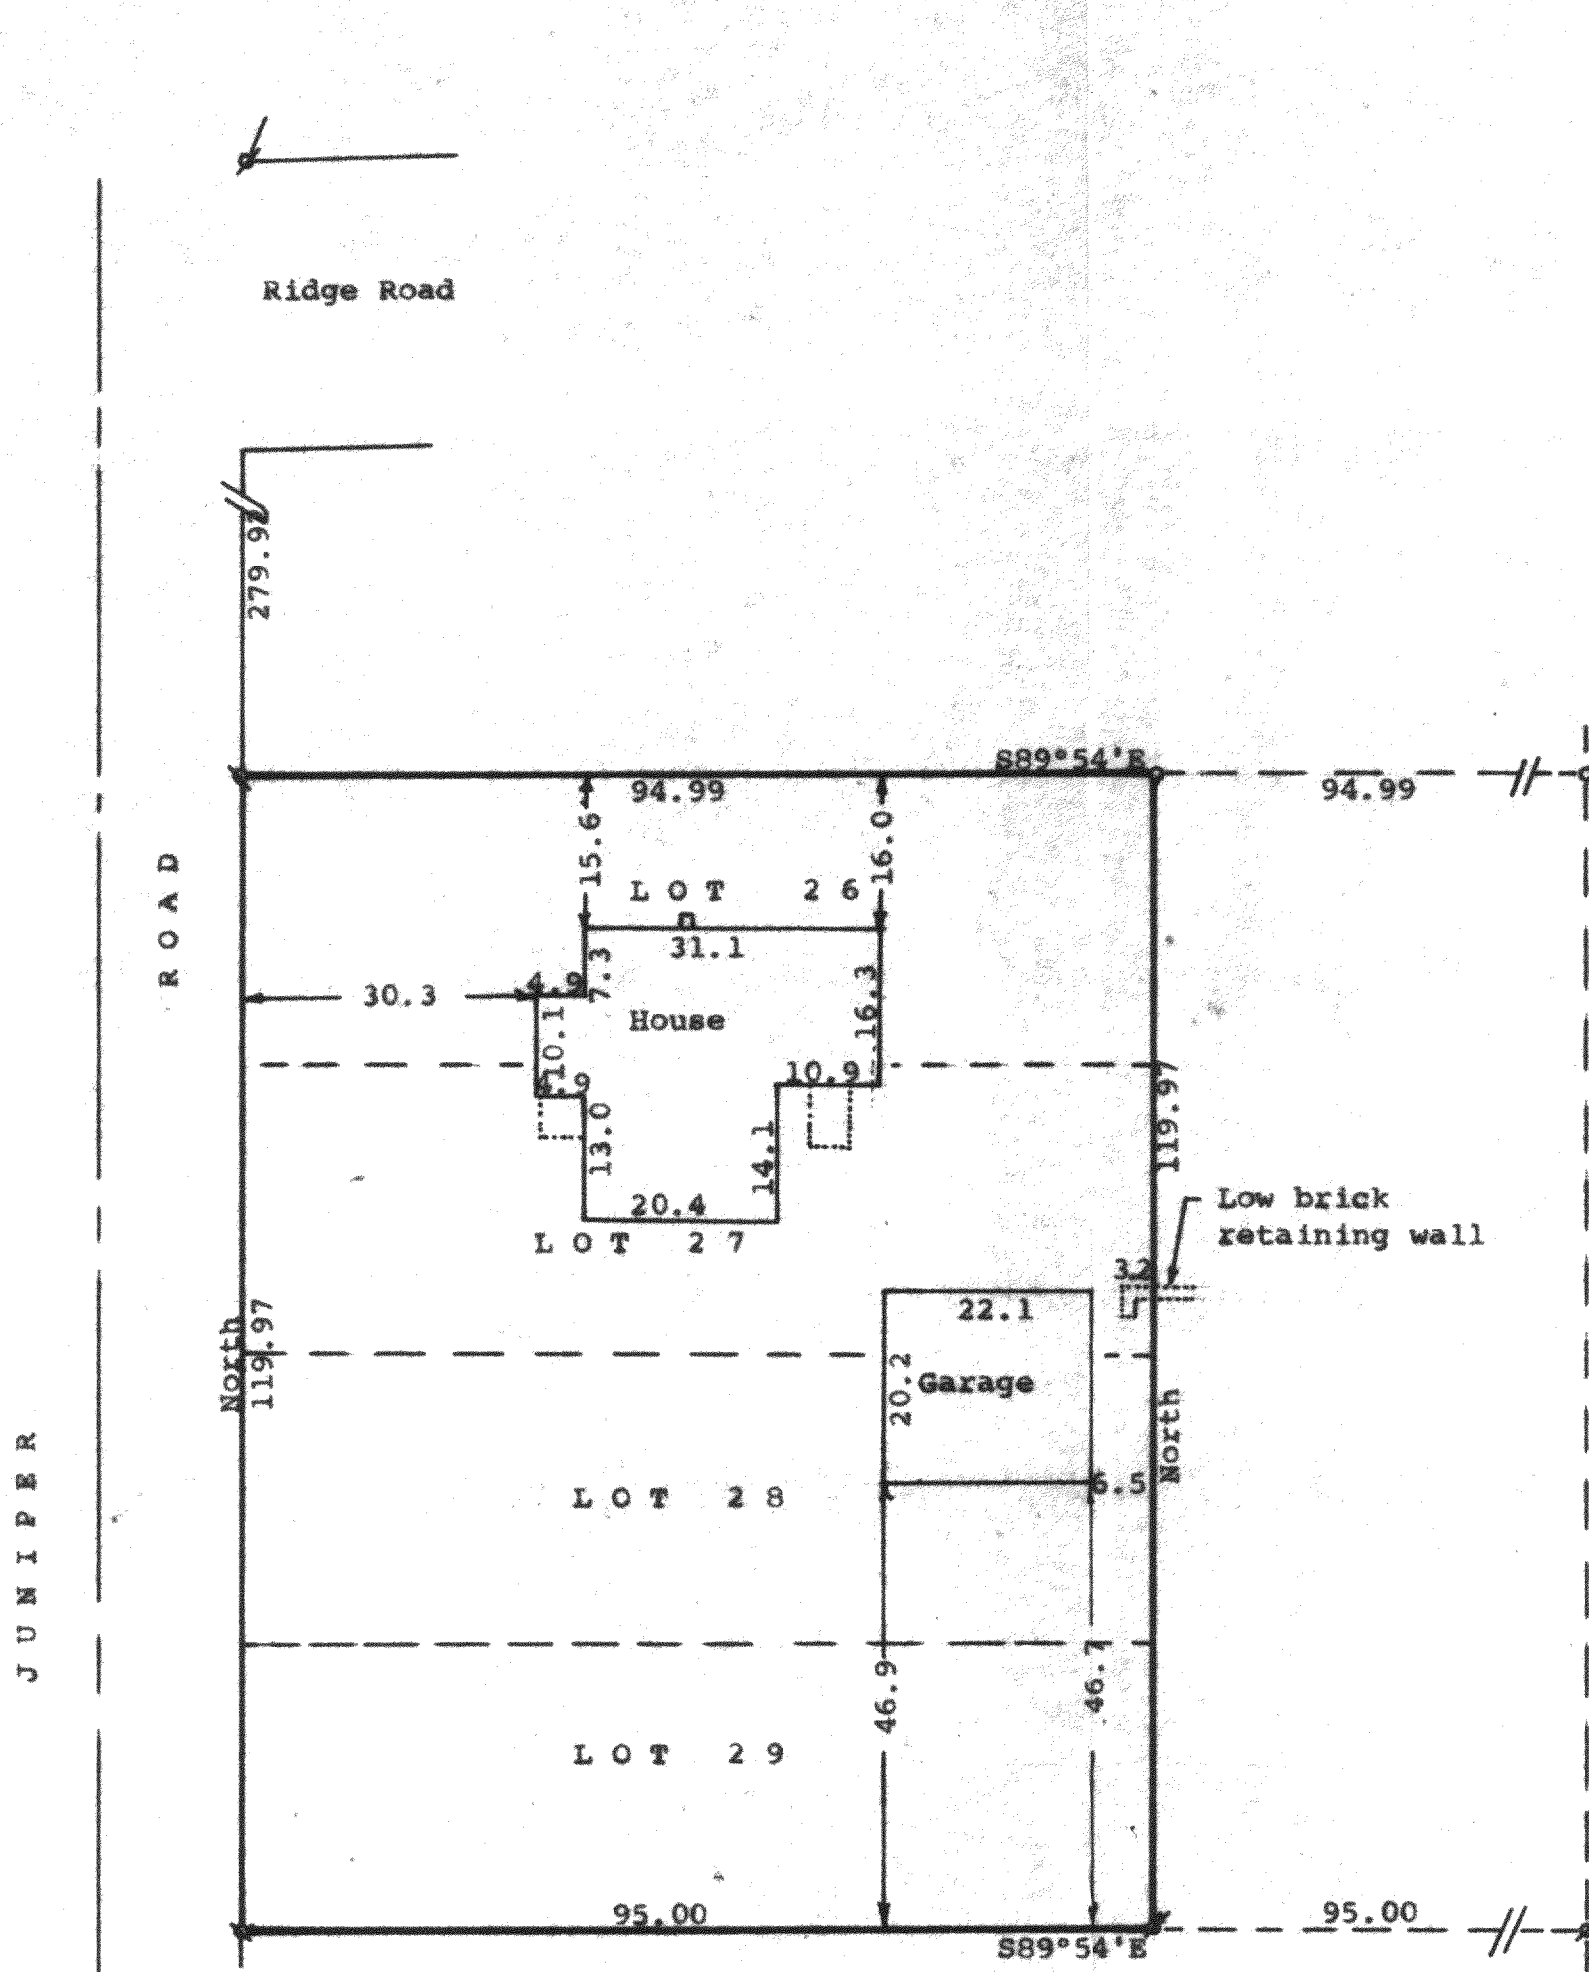

Scale - 1" = 20'  
 x = 1" Iron Pipe Found  
 o = 1/2" Iron Pipe Found  
 v = 3/4" X 24" Iron Pipe Set  
 Bearings are referenced to the east line of  
 Juniper Road with the assumed bearing of North  
 Survey ordered by: Century 21, Skandia Realty  
 312 South 7th Street  
 Delavan, WI. 53115

STATE OF WISCONSIN) SS  
 COUNTY OF WALWORTH)

I, George T. Dunham, Surveyor, certify that I have surveyed the  
 property described as follows:

Lots 26, 27, 28, and 29 in Block 17 of Skansen Swedish Tribune  
 News Subdivision, located in Section 9, T 3 N, R 15 E, Walworth  
 County, Wisconsin.

and that the plat shown hereon is a correct representation thereof and shows  
 the size and location of the property, its exterior boundaries, the location  
 of all visible structures and dimensions of all principal buildings thereon,  
 boundary fences, apparent easements, roadways and visible encroachments, if  
 any, and that I have surveyed the property hereon described according to the  
 official records, to the best of my knowledge and belief.

March 30, 1988

*George T. Dunham*  
 George T. Dunham, Surveyor

