


# ABELL SURVEYING & MAPPING


DELAVAN, WISCONSIN 53115

414-728-6737

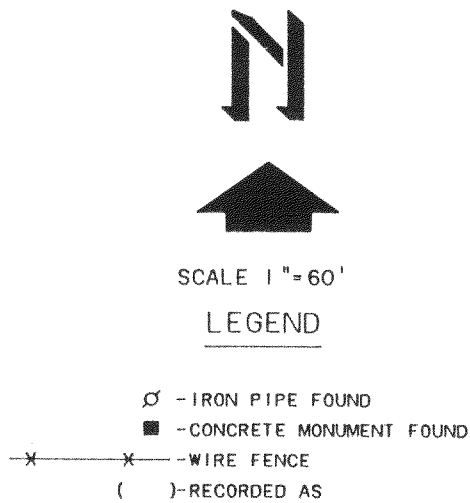


## PLAT OF SURVEY OF

LOT 1 OF CERTIFIED SURVEY MAP NO. 418,  
LOCATED IN THE NORTHEAST 1/4 OF SECTION  
12, T3N, R15E, WALWORTH COUNTY, WISCONSIN.

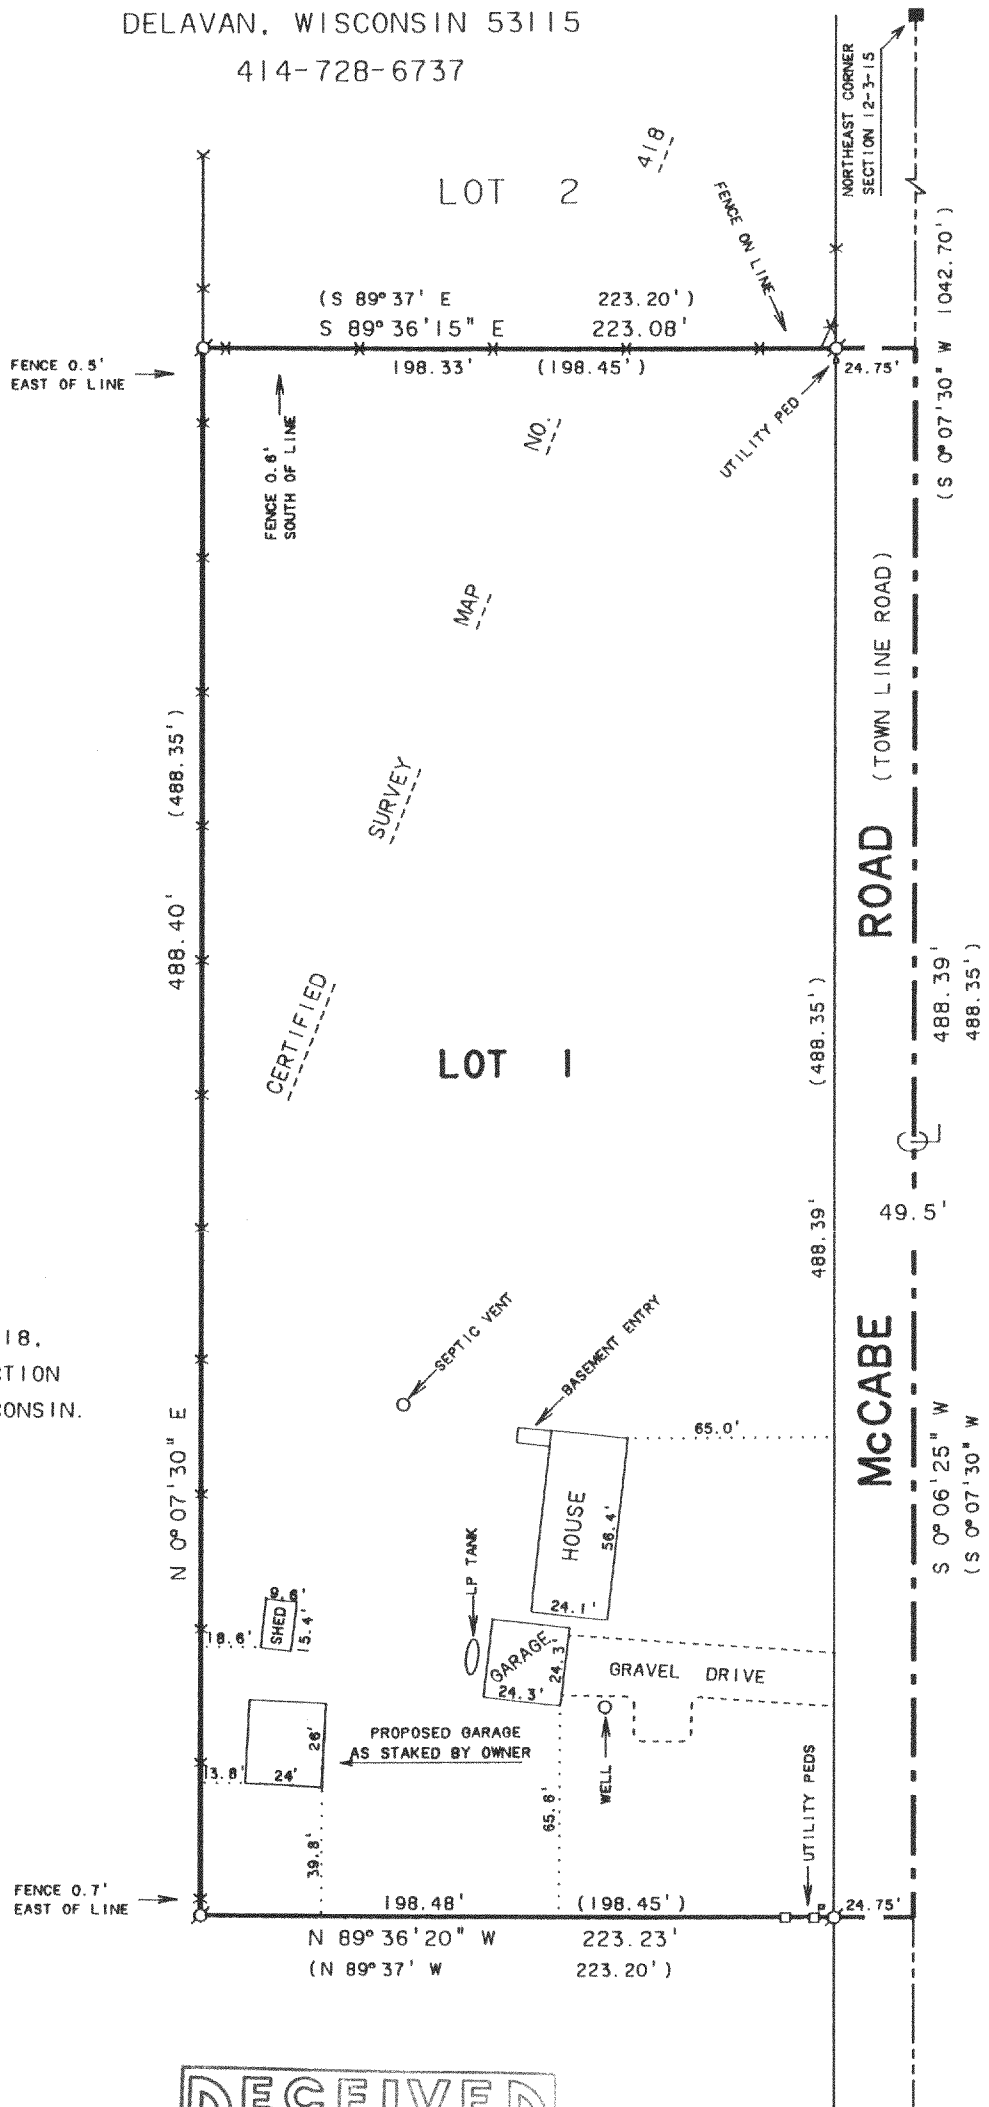

NOTE: BEARINGS ARE REFERENCED TO  
CERTIFIED SURVEY MAP NO. 418.

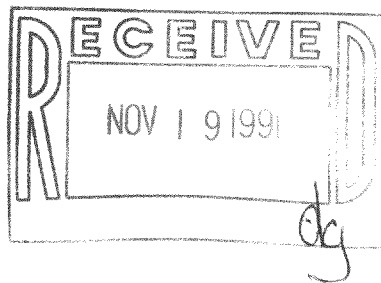

ORDERED BY: DAN McLEAN  
RT. 2 BOX 133B  
ELKHORN, WI. 53121

I, DAVID F. ABELL, DO HEREBY CERTIFY THAT I HAVE SURVEYED THE PROPERTY HEREON  
DESCRIBED ACCORDING TO THE OFFICAL RECORDS AND THAT THE PLAT HEREON IS A  
CORRECT REPRESENTATION OF THE PROPERTY LINES TO THE BEST OF MY KNOWLEDGE AND  
BELIEF

*David F. Abell*

DAVID F. ABELL  
WISCONSIN REGISTERED LAND SURVEYOR, S-1596

June 6, 1991

DATE JOB NUMBER - 91112

NOTE: THIS IS NOT A CERTIFIED COPY UNLESS SEALED.

315-319

CA418-1