
## HAROLD H. KOLB

REGISTERED PROFESSIONAL LAND SURVEYOR LAKE GENEVA, WISCONSIN

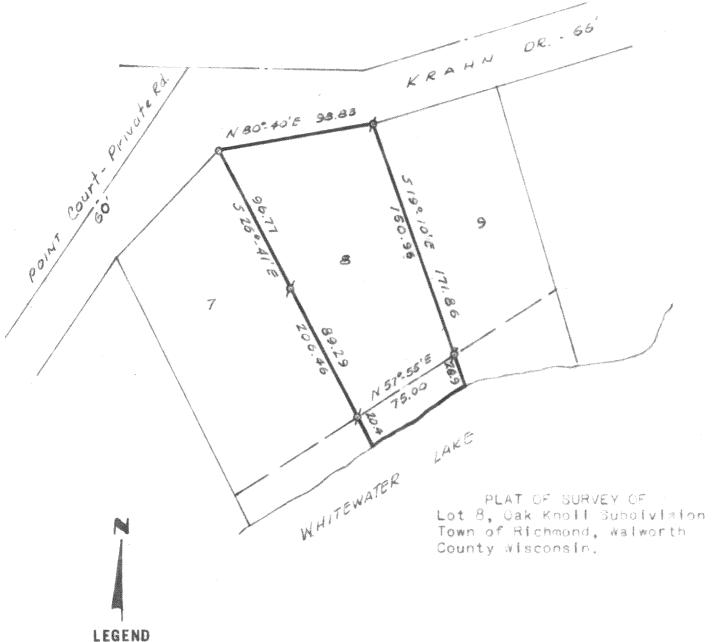

- Ø IRON PIPE FOUND
- O IRON PIPE PLACED
- CONCRETE MONUMENT

x - SPIKE SCQ/e-/": 60'

I, HAROLD H. KOLB, DO HEREBY CERTIFY THAT I HAVE SURVEYED THE PROPERTY HEREON DESCRIBED ACCORDING TO THE OFFICIAL RECORDS, AND THAT THE PLAT HEREON IS A CORRECT REPRESENTATION OF THE LOT LINES.

HAROLD H. KOLB

WISCONSIN REGISTERED LAND SURVEYOR, S-187


DATE OCTOBER4 1967

COK-8

315-38

## HAROLD H. KOLB

REGISTERED PROFESSIONAL LAND SURVEYOR LAKE GENEVA, WISCONSIN

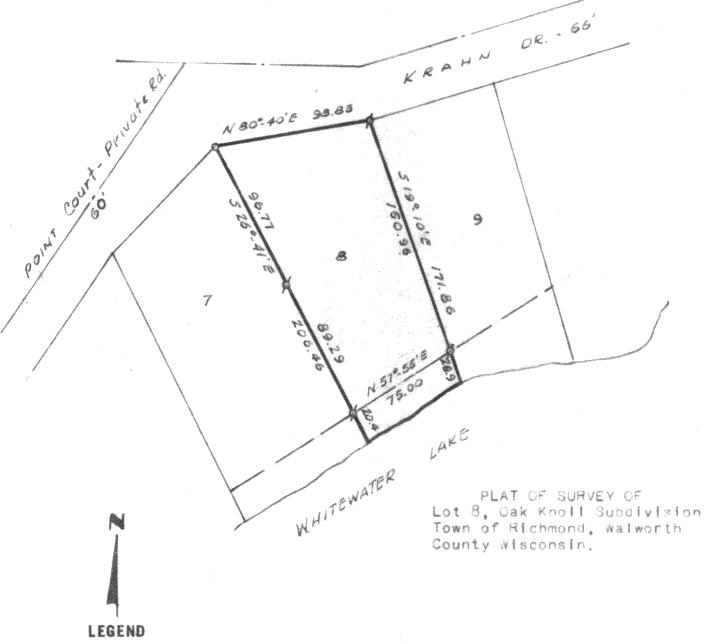

Ø - IRON PIPE FOUND

O - IRON PIPE PLACED

• - CONCRETE MONUMENT

x - SPIKE SCQ/e-/": 60'

I, HAROLD H. KOLB, DO HEREBY CERTIFY THAT I HAVE SURVEYED THE PROPERTY HEREON DESCRIBED ACCORDING TO THE OFFICIAL RECORDS, AND THAT THE PLAT HEREON IS A CORRECT REPRESENTATION OF THE LOT LINES.

HAROLD H. KOLB

WISCONSIN REGISTERED LAND SURVEYOR, S-187

DATE OCTOBERA 1967

COK-8