
TOPOGRAPHIC MAP LOT 10, BLOCK 6 OF CHAPEL HILLS SUBDIVISION LOCATED IN THE NE 1/4 OF SEC. 3, T. 3 N., R. 15 E. WALWORTH COUNTY, WISCONSIN

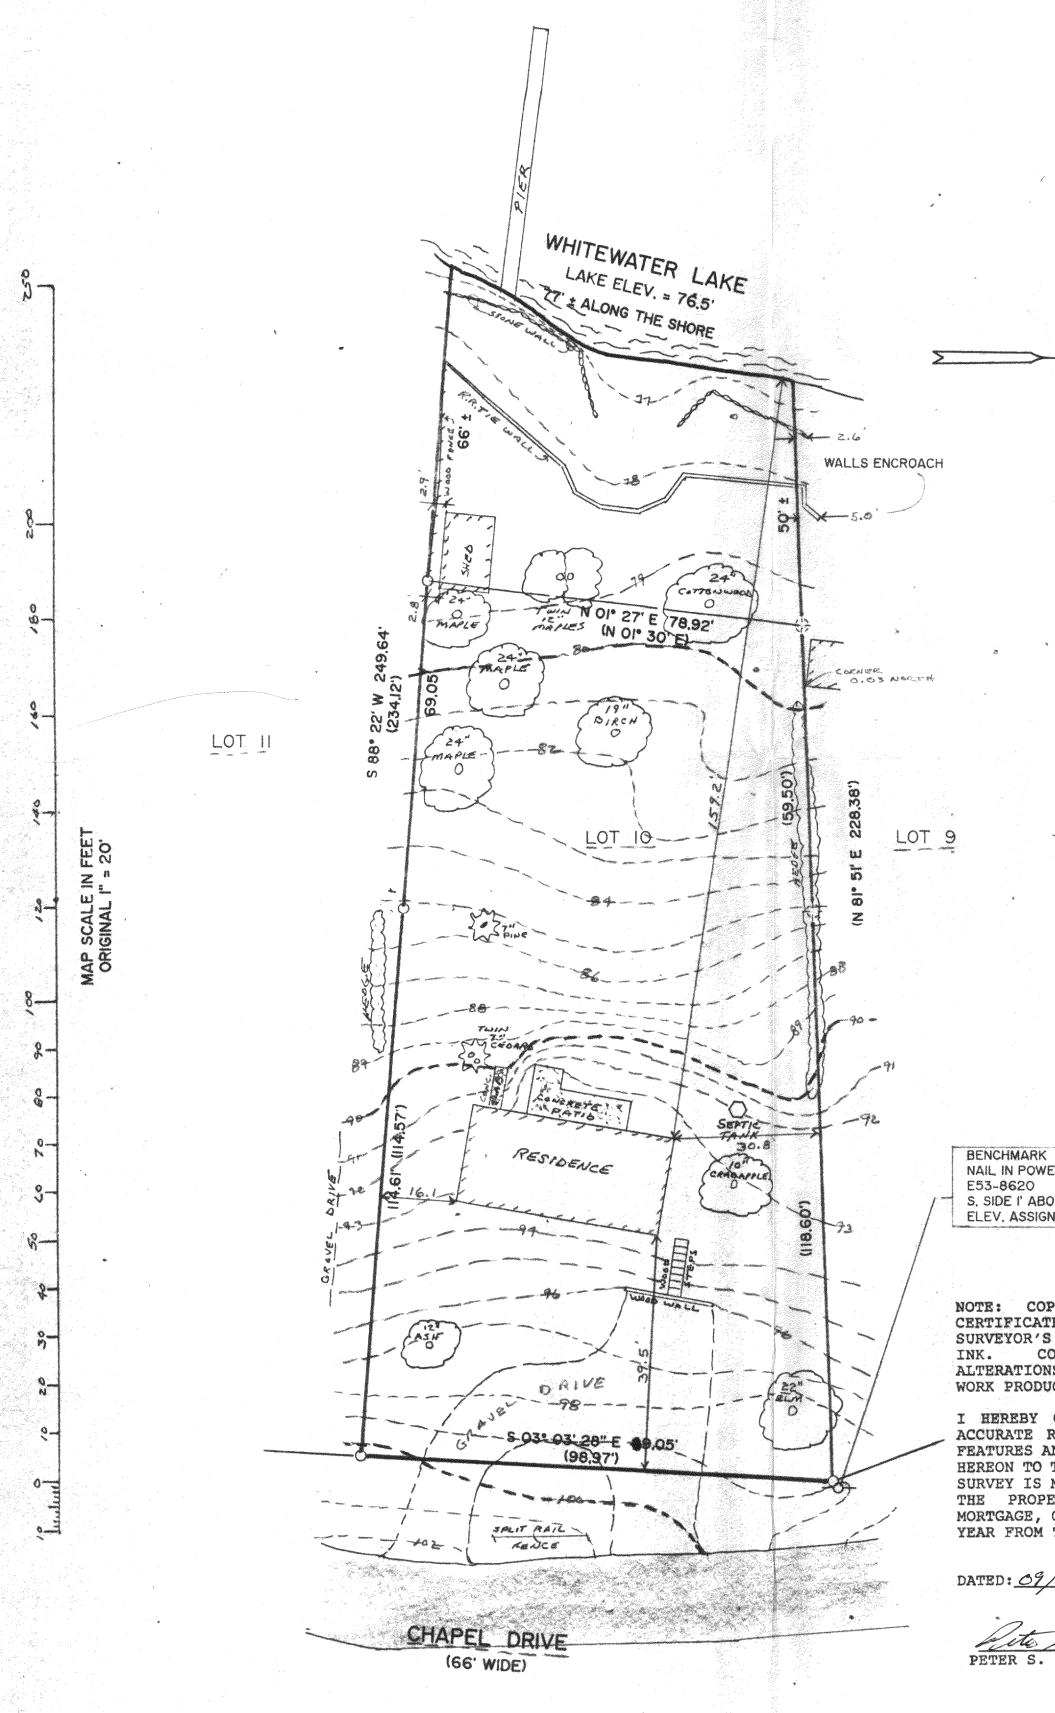

FARRIS, HANSEN (Engineering, Arch 7 Ridgway Cou ELKHORN, WI

PETER S. GORDON RLS 2101

MISCONS **GORDON** S-2101 ELKHORN,



O= FOUND IRON PIPE STAKE RECORD MONUMENT POSITION

RECORDED AS

LEGEND

ECEIVE OCT | 3 1993

NAIL IN POWER POLE S, SIDE I' ABOVE GROUND ELEV, ASSIGNED 100,00'

COPIES OF THIS MAP TO WHICH THE FOLLOWING CERTIFICATE WILL APPLY ARE BLUE LINE PRINTS SHOWING SURVEYOR'S ORIGINAL SEAL AND SIGNATURE IN BLACK INK. COPIES BY ANY OTHER MEANS MAY HAVE ALTERATIONS WHICH DO NOT REPRESENT THE SURVEYOR'S WORK PRODUCT.

I HEREBY CERTIFY THAT THIS PLAT IS A TRUE AND ACCURATE REPRESENTATION OF THE EXISTING PHYSICAL FEATURES AND TOPOGRAPHIC DETAIL OF THE PARCEL SHOWN HEREON TO THE BEST OF MY KNOWLEDGE AND BELIEF. THIS SURVEY IS MADE FOR THE USE OF THE PRESENT OWNERS OF THE PROPERTY, AND ALSO THOSE WHO PURCHASE, MORTGAGE, OR GUARANTEE THE TITLE THERETO WITHIN ONE YEAR FROM THE DATE HEREOF.

2383.93 09/03/93 SHEET

WORK ORDERED BY: RON O'HARA