


929 WILLIAMS STREET LAKE GENEVA, WISCONSIN 53147 414 248 3697



A FOUNDATION LOCATION ON LOT 3 OF CERTIFIED SURVEY MAP NO. 2225, LOCATED IN THE NORTH-WEST 1/4 OF SECTION 12, T3N, R15E, TOWN OF RICHMOND, WALWORTH COUNTY, WISCONSIN.

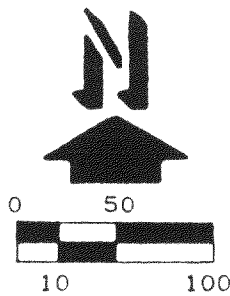


1'' = 100'

LEGEND

Ø - IRON PIPE FOUND  
 WWWW - NO ACCESS

I, HAROLD H. KOLB, DO HEREBY CERTIFY THAT I HAVE SURVEYED THE PROPERTY HEREON DESCRIBED ACCORDING TO THE OFFICIAL RECORDS AND THAT THE PLAT HEREON IS A CORRECT REPRESENTATION OF THE LOT LINES TO THE BEST OF MY KNOWLEDGE AND BELIEF.  
SURVEY NOT VALID UNLESS SURVEYOR'S SIGNATURE IS IN RED.

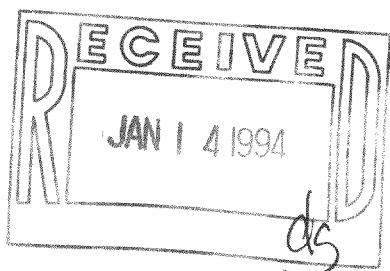

HAROLD H. KOLB

WISCONSIN REGISTERED LAND SURVEYOR, S. 187

DATE MAY 20, 1993

REVISÉD

REVISÉD

3-15-R-12-9A

CA 2225-1

315-409