


# PLAT OF SURVEY

LOT 3 AND THAT PART OF LOT 4, lying Northeasterly of a line drawn from the midpoint on the Southeasterly line to the midpoint of the Northwestern line all in Block 1, Richmond Heights, a subdivision located in the Northeast 1/4 of the Southeast 1/4, the Northwest 1/4 of the Southeast 1/4 and the Southwest 1/4 of the Southeast 1/4 of Section 3, Town 3 North, Range 15 East, Town of Richmond, County of Walworth, State of Wisconsin.

Surveyed for: Tlncher Realty  
Survey address: 7065 Chapel Drive

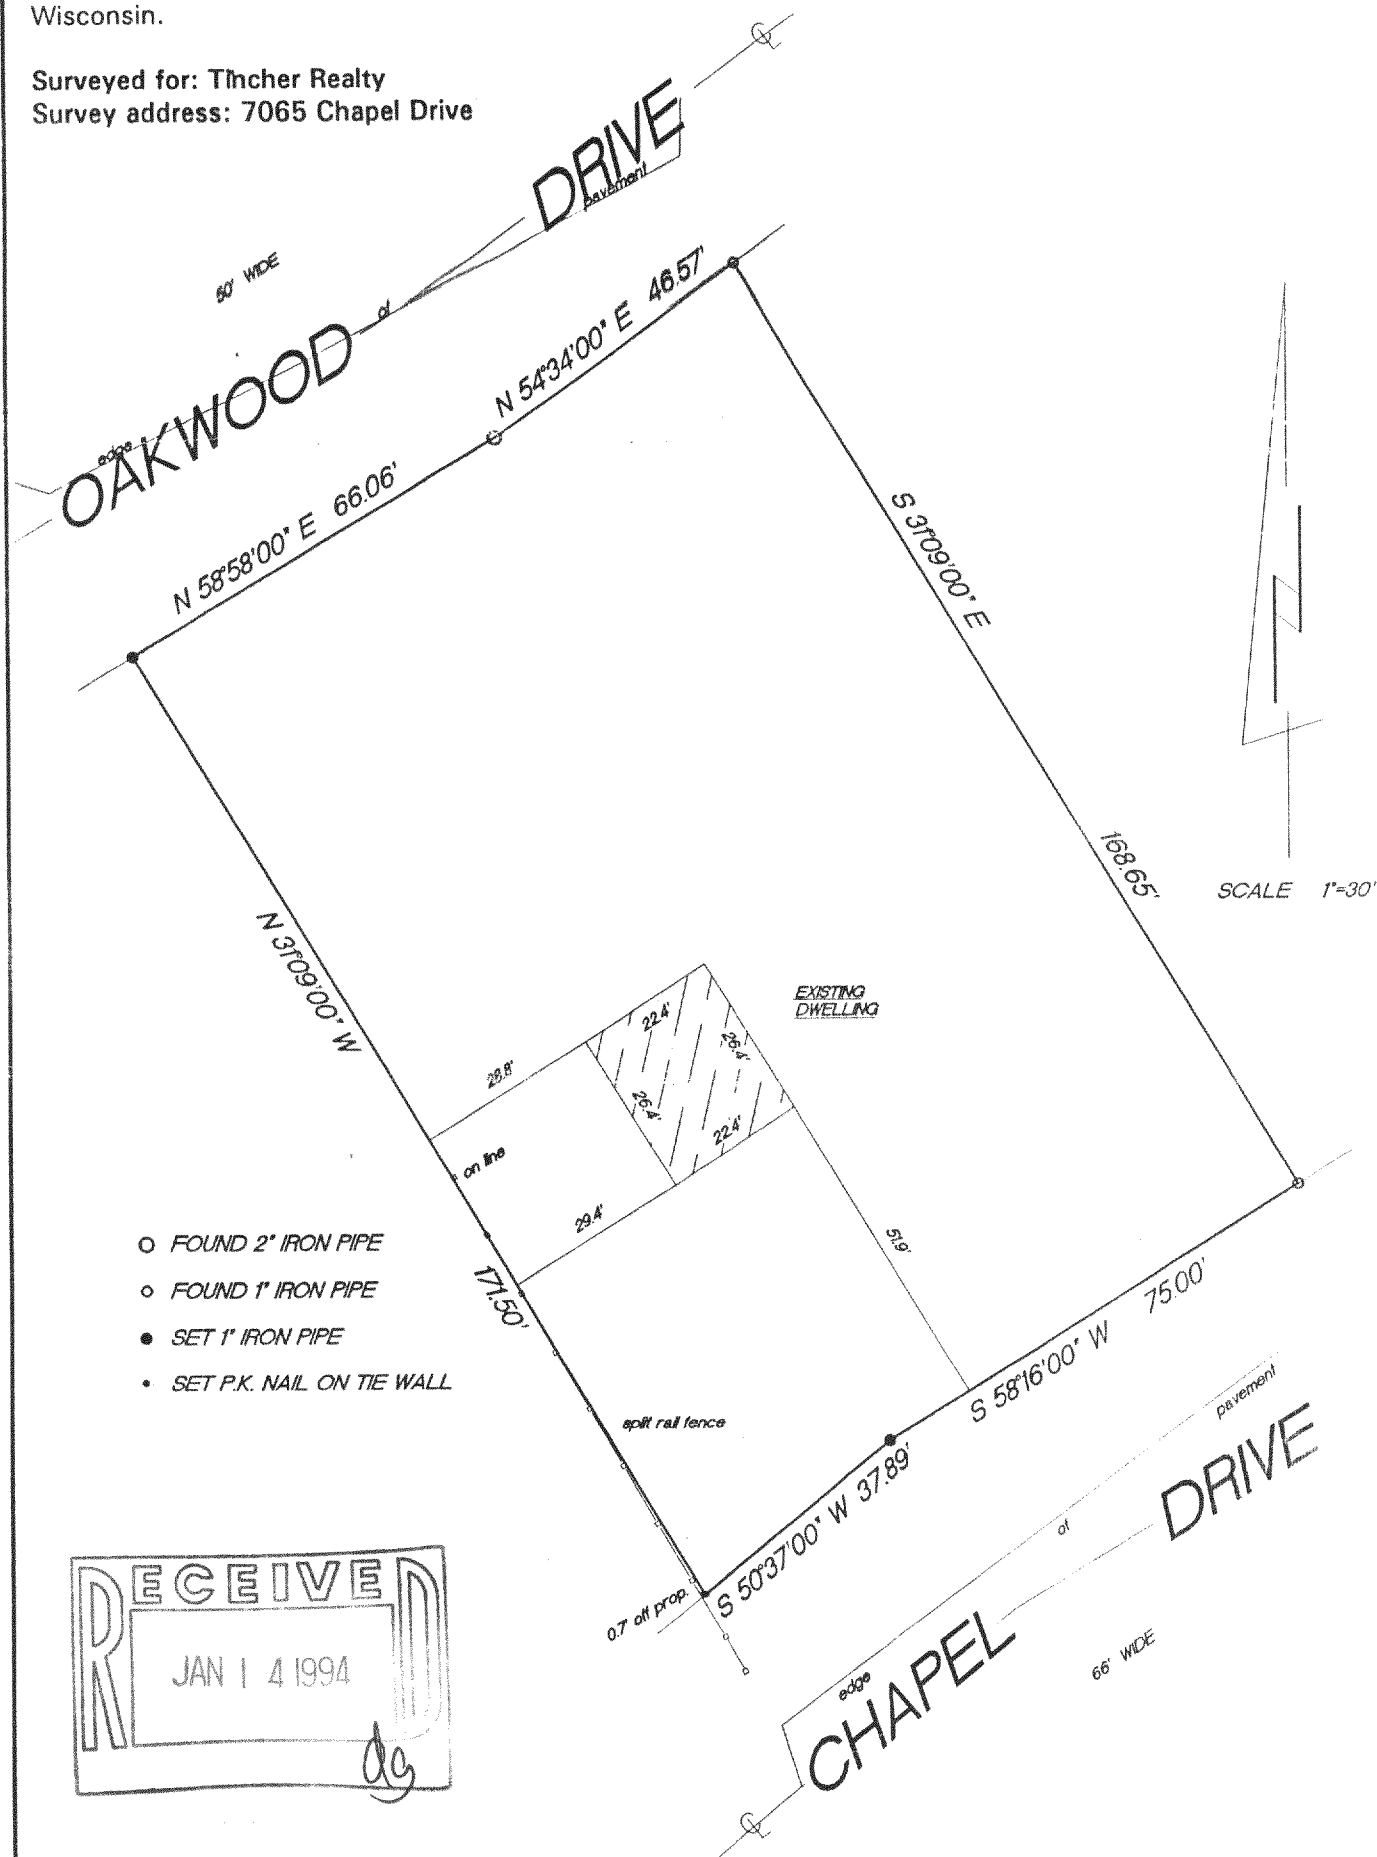


"I hereby certify that I have surveyed the above described property and that the above map is a true representation thereof and shows the size and location of the property, its exterior boundaries, the location of all visible structures and dimension of all principal buildings thereon, boundary fences, apparent easements, roadways and encroachments if any."

"This survey is made for the use of the present owners of the property, and also those who purchase, mortgage or guarantee the title thereto within one year from date hereof."

**KETTLE MORaine SURVEYING**  
W362 S10227 Lewin Lane  
Eagle Wisconsin 53119  
(414) 594-3484

Terrance E. Pisarek R.L.S.

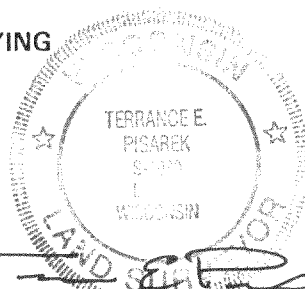

THIS IS NOT AN ORIGINAL SURVEY UNLESS THE SEAL IS HERE

11/1/93

DATE

TEP/SJB

FIELD WORK BY

TEP

DRAWN BY

93081

JOB NUMBER

CRH-3

315-411