

FARRIS, HANSEN & ASSOCIATES, INC.

7 RIDGEWAY COURT, P.O. BOX 437
ELKHORN, WISCONSIN 53121

PLAT OF SURVEY


PHONE: (414) 723-2098
FAX: (414) 723-5886

LOCATION: PARCEL 28 TIMBER TRAILS
PART OF THE NE 1/4, SEC. 2, T. 3 N., R. 15 E.
WALWORTH COUNTY, WI.
TAX KEY # 2-36

WORK ORDERED BY: PERRY MILLER
PO BOX 861
LAKE GENEVA, WI.

MAP LEGEND


- = IRON PIPE STAKE FOUND
- = IRON PIPE STAKE SET
- = IRON ROD STAKE FOUND
- = IRON ROD STAKE SET
- = CONCRETE MONUMENT FOUND
- (XXXXX) = RECORD DIMENSION
- = UTILITY CONTROL BOX

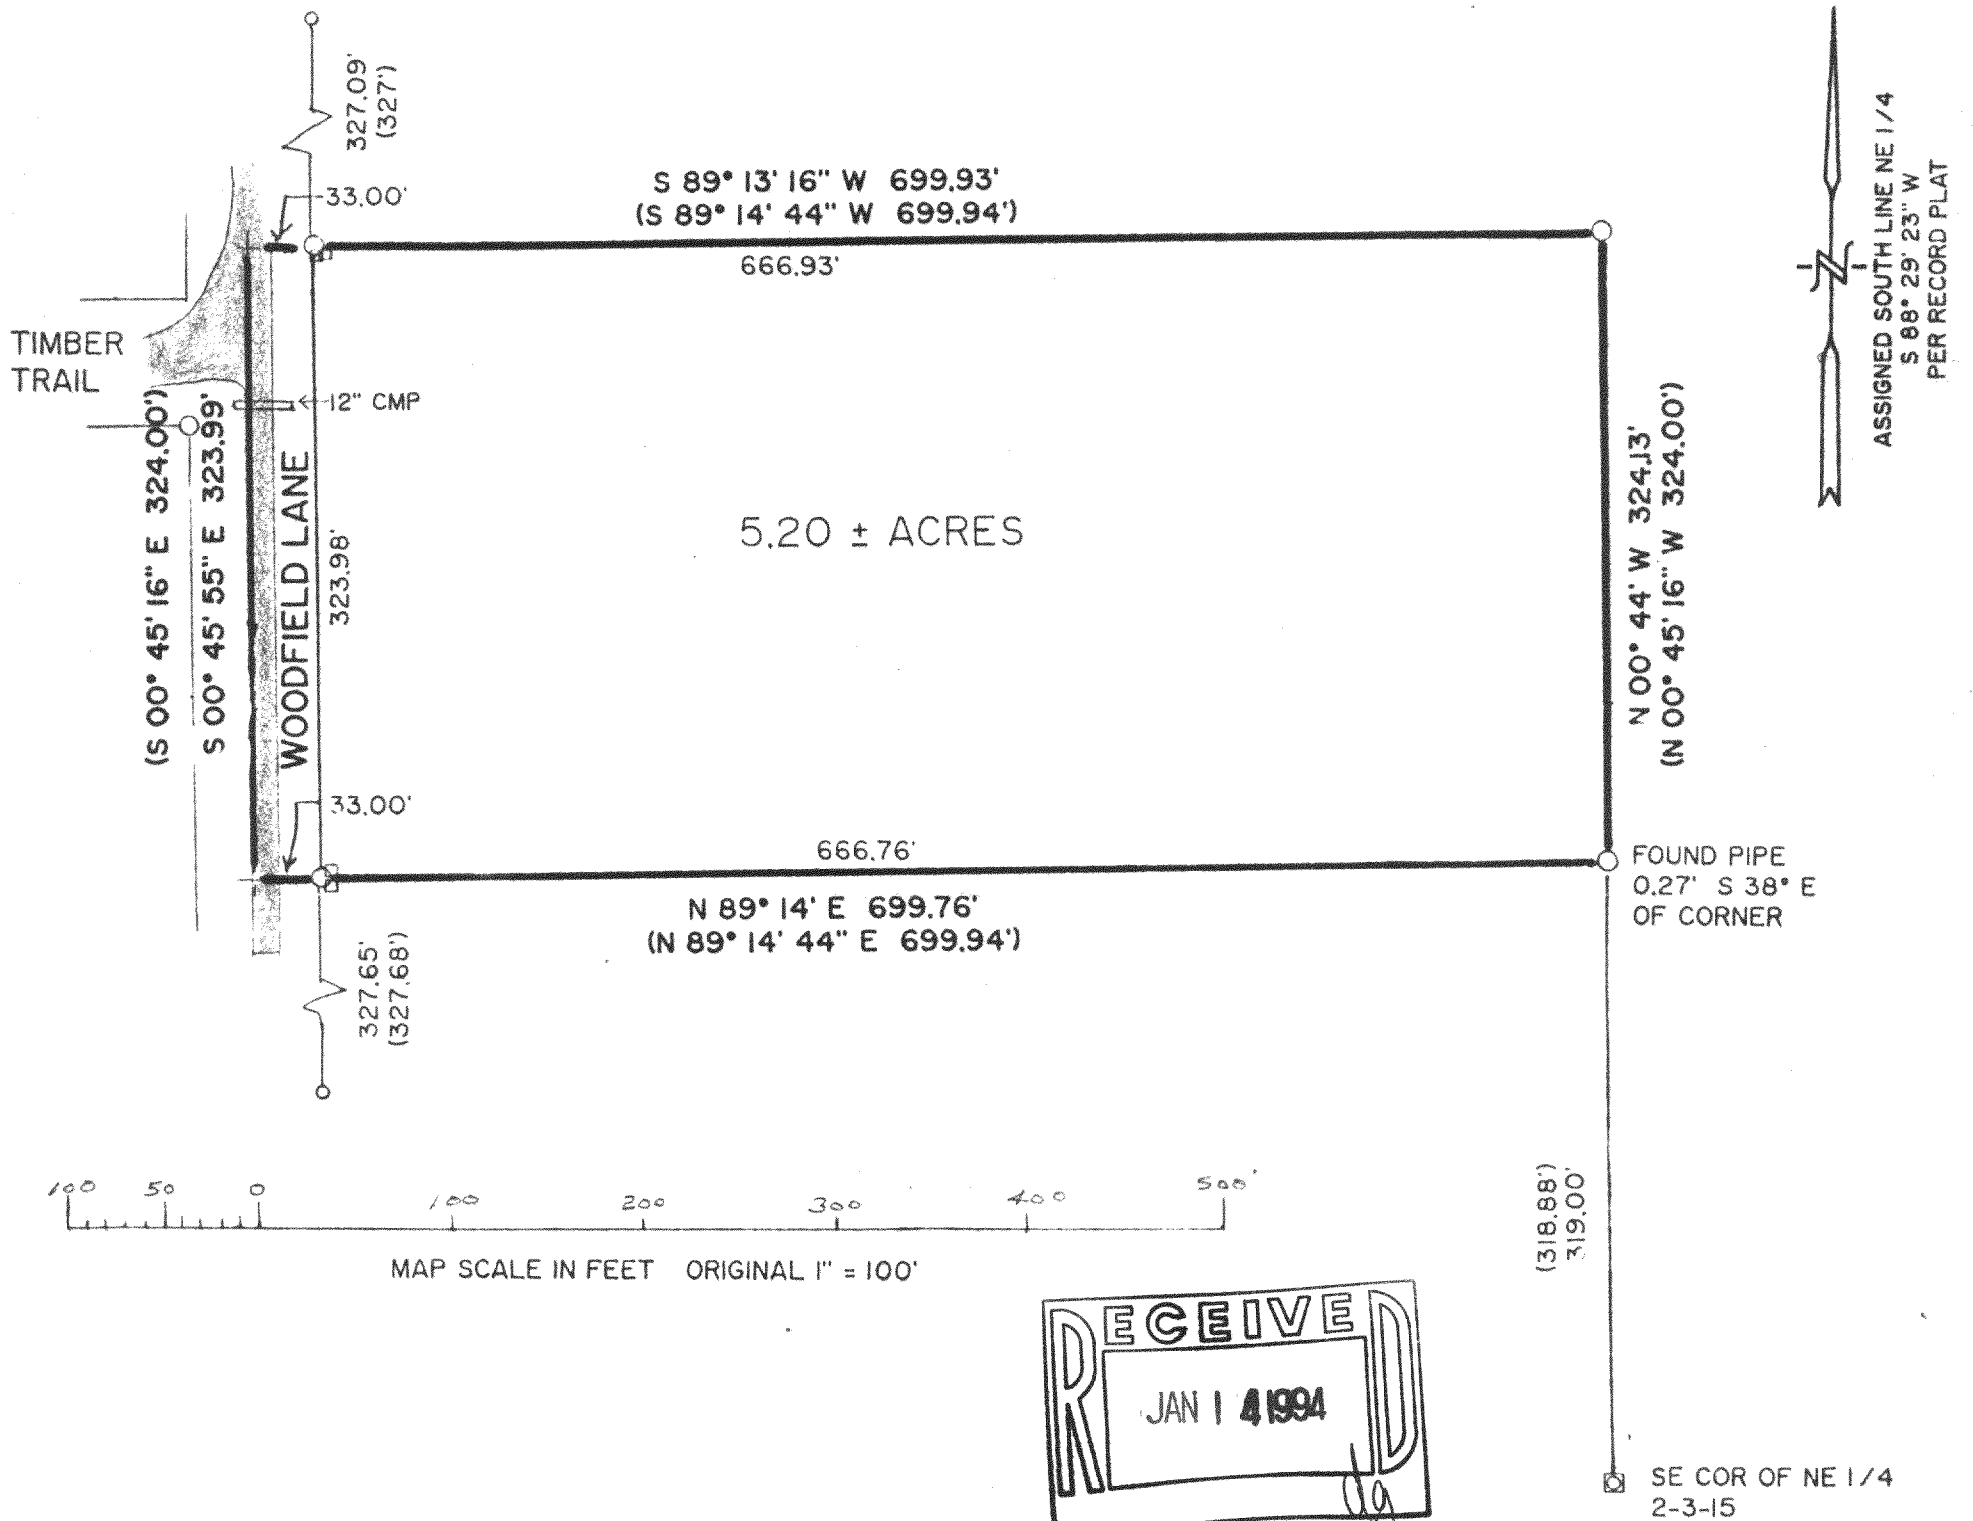

Parcel 28 - Timber Trails

That part of the Northeast 1/4 of Section 2, Town 3 North, Range 15 East, in the Town of Richmond, Walworth County, Wisconsin, bounded and described as follows:

Commencing at the Southeast corner of said 1/4 Section; thence N 0 deg 45' 16" W, along the East line of said 1/4 Section, 318.88 feet to the point of beginning; continuing thence N 0 deg 45' 16" W, along said East line 324.00 feet to a point; thence S 89 deg 14' 44" W, 699.94 feet to a point in the centerline of the road; thence S 0 deg 45' 16" E, along said centerline, 324.00 feet to a point; thence N 89 deg 14' 44" E, 699.94 feet to the point of beginning. Containing therein 5.2062 acres of land.

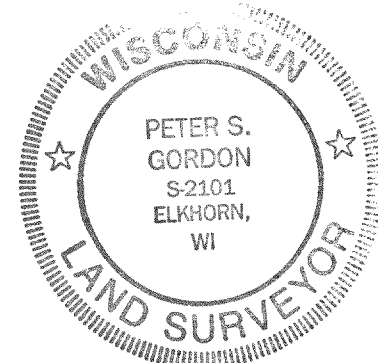

NOTE: COPIES OF THIS MAP TO WHICH THE FOLLOWING CERTIFICATE WILL APPLY ARE BLUE LINE PRINTS SHOWING SURVEYOR'S ORIGINAL SEAL AND SIGNATURE IN BLACK INK. COPIES BY ANY OTHER MEANS MAY HAVE ALTERATIONS WHICH DO NOT REPRESENT THE SURVEYOR'S WORK PRODUCT.

I HEREBY CERTIFY THAT THE ABOVE DESCRIBED PROPERTY HAS BEEN SURVEYED UNDER MY DIRECTION AND THAT THE ABOVE MAP IS A TRUE REPRESENTATION THEREOF AND SHOWS THE SIZE AND LOCATION OF THE PROPERTY AND ITS EXTERIOR BOUNDARIES. THIS SURVEY IS MADE FOR THE USE OF THE PRESENT OWNERS OF THE PROPERTY, AND ALSO THOSE WHO PURCHASE, MORTGAGE, OR GUARANTEE THE TITLE THERETO WITHIN ONE YEAR FROM THE DATE HEREOF.

DATED: 12/17/93

Peter S. Gordon

PROJECT NO. 3985

CR-2-36

315-420