


PLAT OF SURVEY

LOT 15, OAK KNOLL, located in the Southwest 1/4 of the Southeast 1/4 of section 34, Town 4 North, Range 15 East, and the Northwest 1/4 of the Northeast 1/4 of Section 3, Town 3 North, Range 15 East, Walworth County, Wisconsin.

Surveyed for: Tincher Realty

Survey address: 7482 Krahn Drive

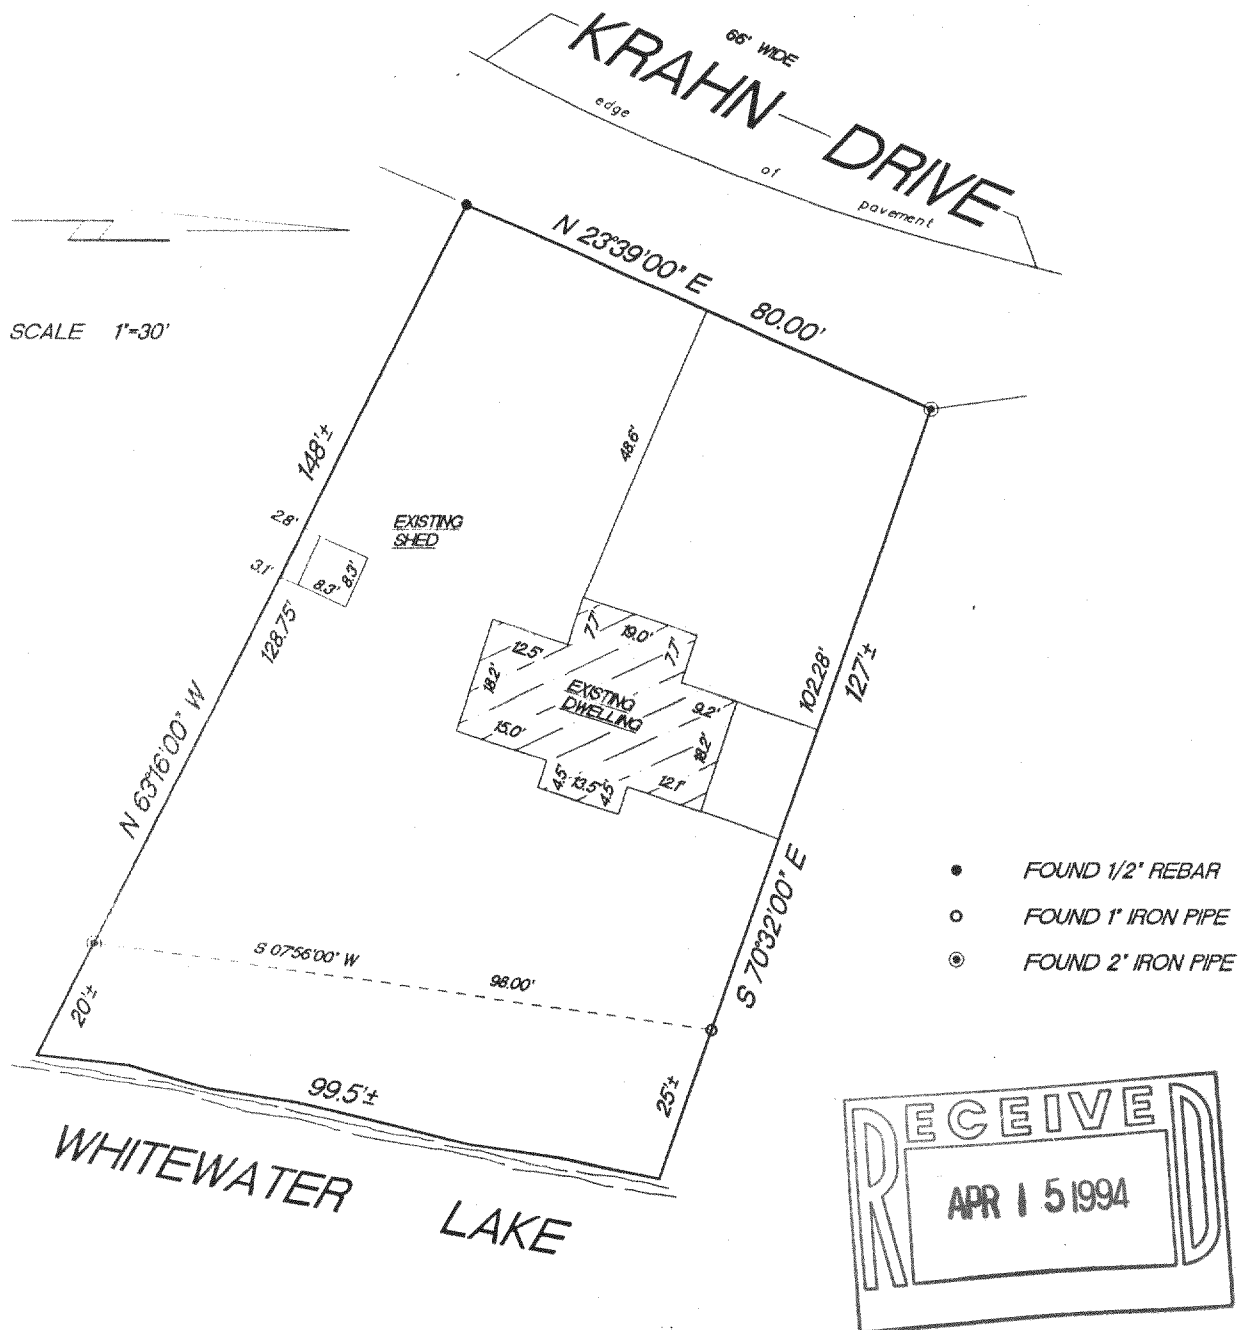


"I hereby certify that I have surveyed the above described property and that the above map is a true representation thereof and shows the size and location of the property, its exterior boundaries, the location of all visible structures and dimension of all principal buildings thereon, boundary fences, apparent easements, roadways and encroachments if any."

"This survey is made for the use of the present owners of the property, and also those who purchase, mortgage or guarantee the title thereto within one year from date hereof."

KETTLE MORaine SURVEYING
W362 S10227 Lewin Lane
Eagle Wisconsin 53119
(414) 594-3484

Terrance E. Pisarek R.L.S.

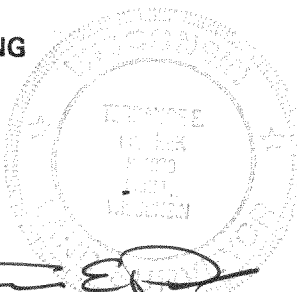

THIS IS NOT AN ORIGINAL SURVEY UNLESS THE SEAL IS RED.

4/1/94 DATE TEP/DRE FIELD WORK BY TEP DRAWN BY 94032 JOB NUMBER

COK-15

315-423