
PLAT OF SURVEY

LOTS 7-11 AND 24-28, BLOCK 9, FOREST BEACH SUBDIVISION, being a part of Section 9, Town 3 North. Range 15 East, Town of Richmond, Walworth, County, Wisconsin.

Surveyed for: Roger and Jenny Clark

Survey address: N6850 Lake Drive

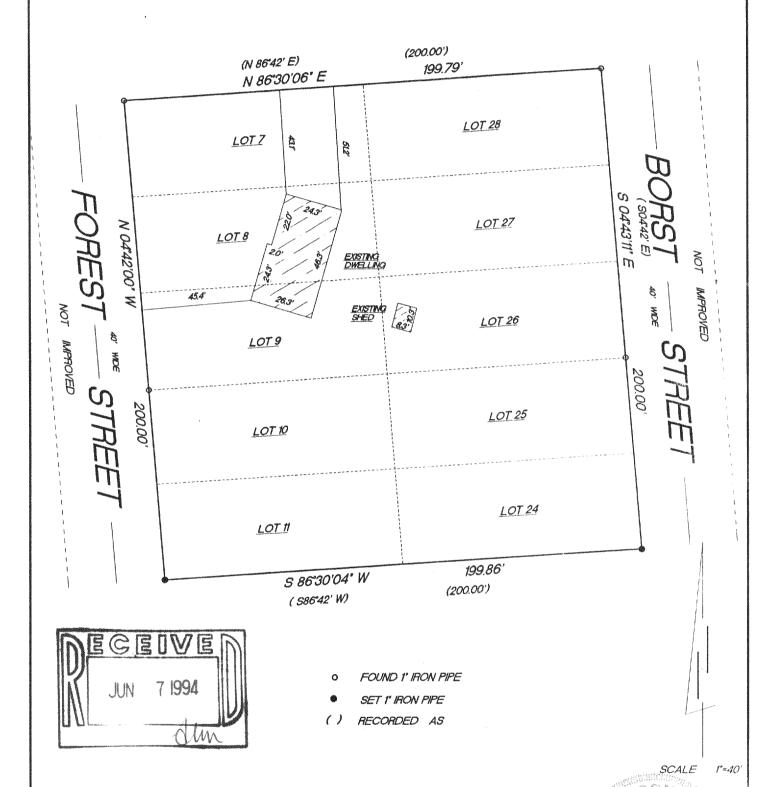

"I hereby certify that I have surveyed the above described property and that the above map is a true representation thereof and shows the size and location of the property, its exterior boundaries, the location of all visible structures and dimension of all principal buildings thereon, boundary fences, apparent easements, roadways and encroachments if any."

"This survey is made for the use of the present owners of the property, and also those who purchase, mortgage or guarantee the title thereto within one year from date hereof."

6/6/94

TEP/DRF

DATE FIELD WORK BY

W362 S10227 Lewin Lane Eagle Wisconsin 53119 (414) 594-3484

Terrance E. Pisarek R.L.S.

THIS IS NOT AN ORIGINAL SURVEY UNLESS THE SEAL IS RED.

TEP

94089

PISAREK

DRAWN BY

JOB NUMBER

CFB-SS CFB-S9 CFB-SSA CFB-60