
## ABELL SURVEYING & MAPPING DELAVAN, WISCONSIN 53115 414-728-6737

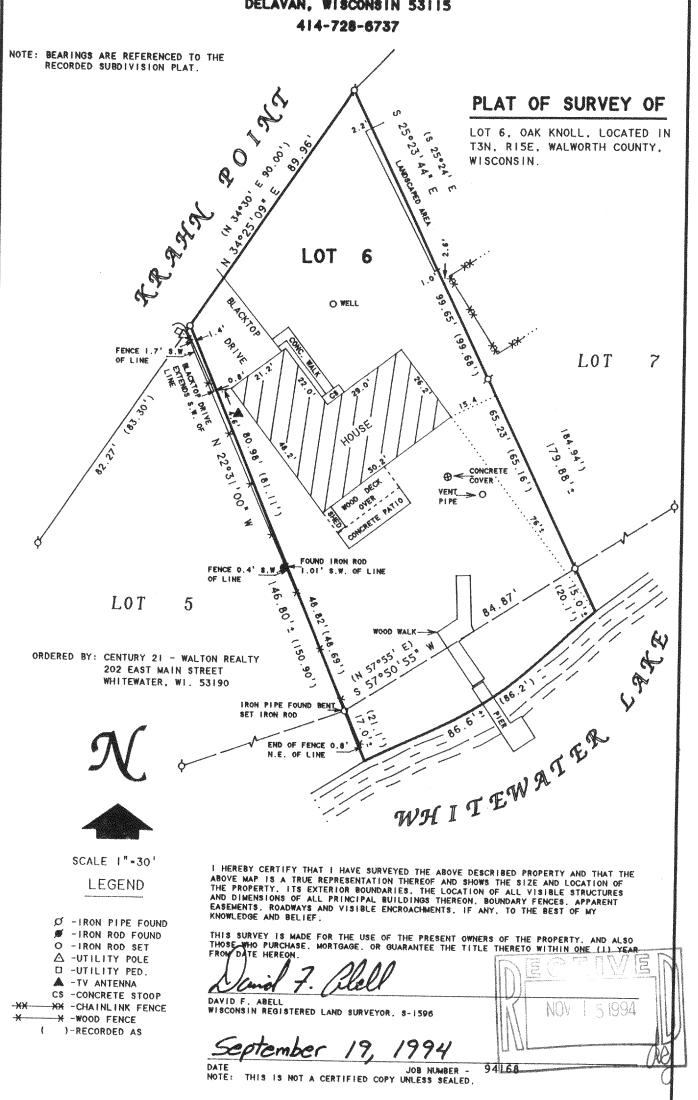

COK-Le