

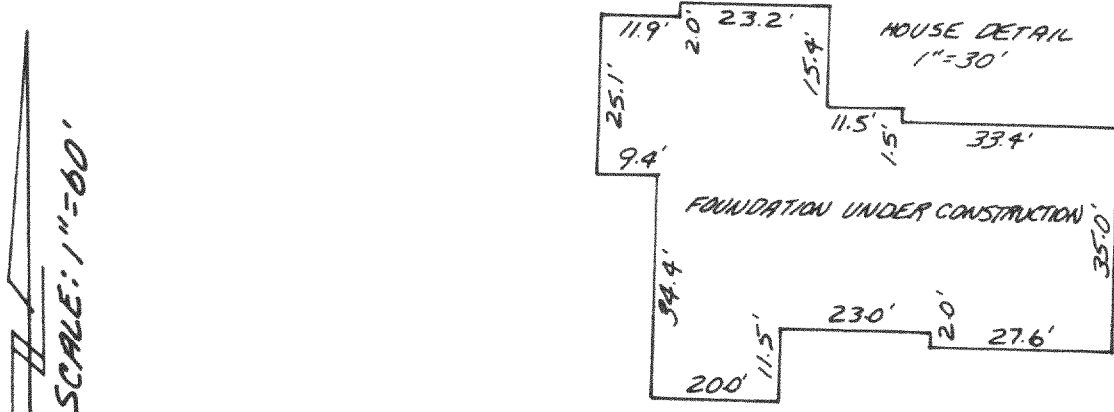


MORTGAGE INSPECTION


R.F. Sarko and Associates, Inc.  
Land Surveyors  
2919 University Avenue  
Madison, Wisconsin 53705

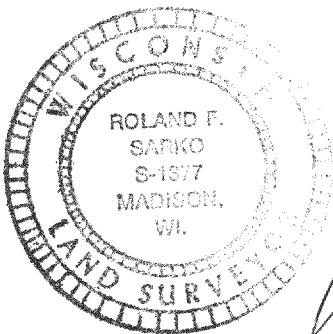

IROQUOIS TRAIL

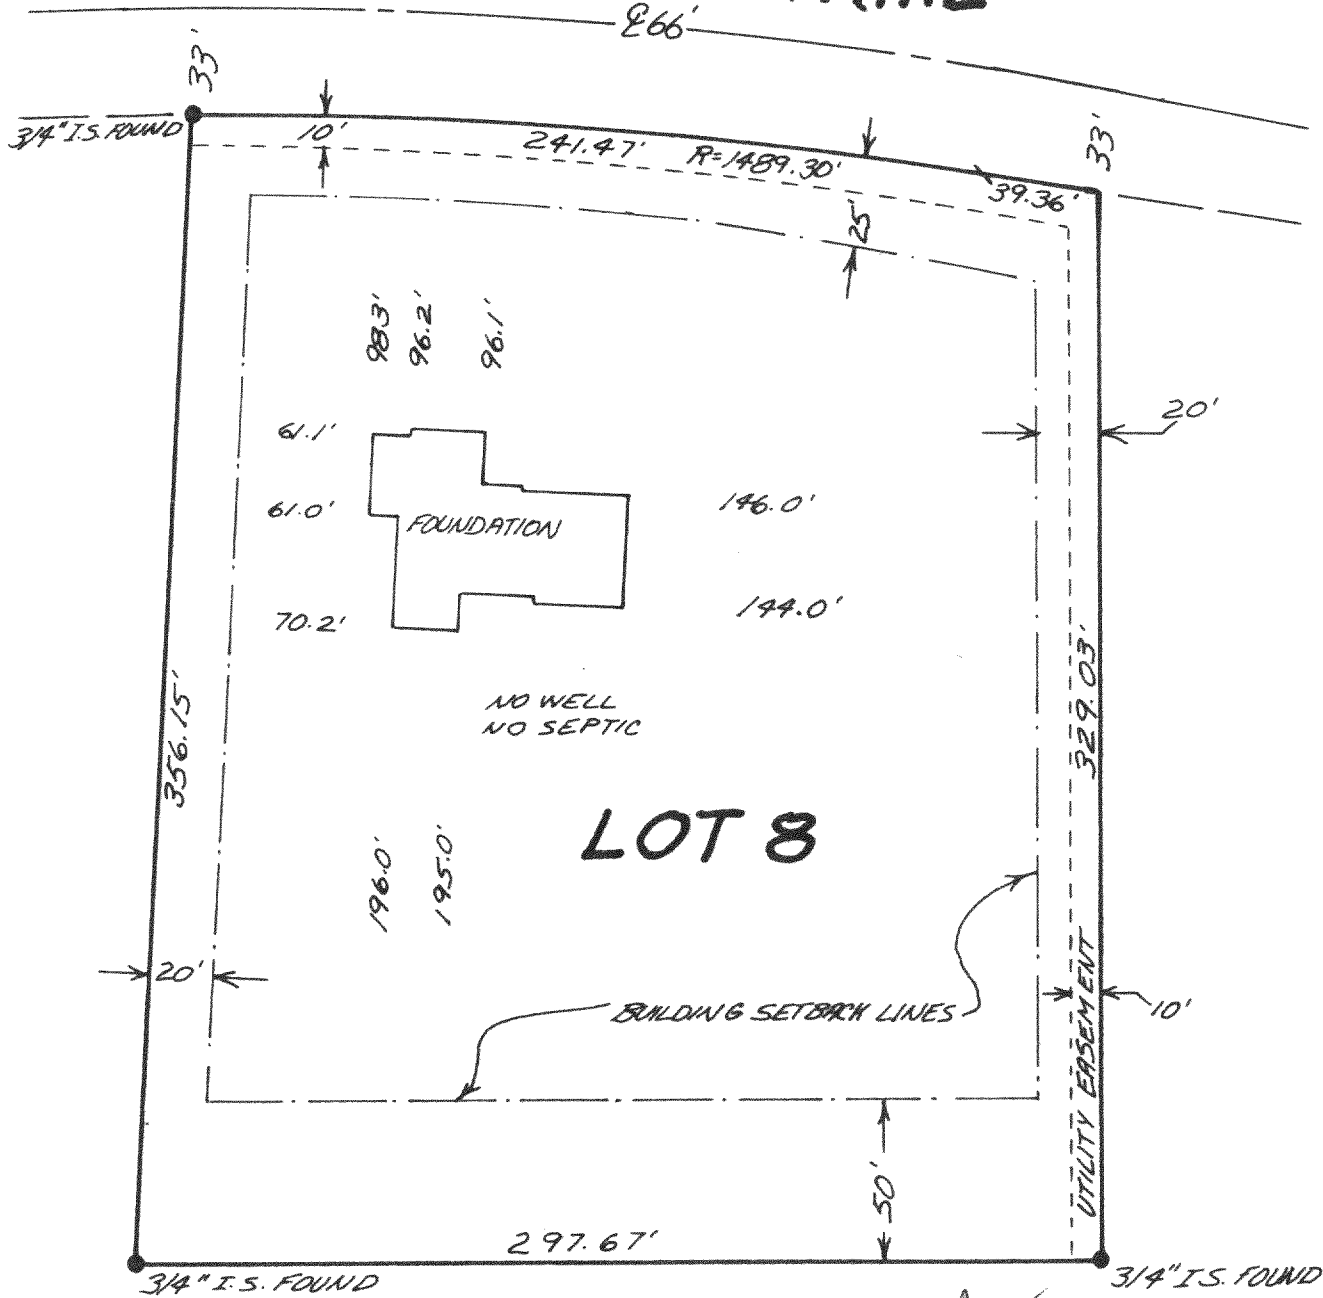

*Roland F. Sarko*  
1-27-95

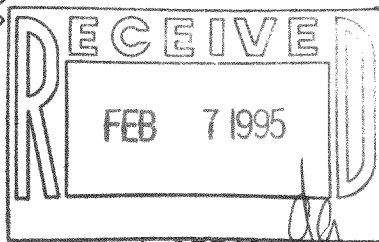

Map Number: 4-27741  
Job Number: 36500  
Page One of Two

**MORTGAGE INSPECTION**

R.F. Sarko and Associates, Inc.  
Land Surveyors  
2919 University Avenue  
Madison, Wisconsin 53705

**LEGAL DESCRIPTION OF PROPERTY INSPECTED:**

Lot 8, Meadowwood, Town of Richmond, Walworth County,  
Wisconsin.

**ADDRESS OF PROPERTY INSPECTED:**

W 7533 Iroquois Trail  
Delevan, Wisconsin

**INSPECTED FOR:**

Modern Abstract & Title  
P.O. Box 648  
Janesville, WI 53545

Attn: Carl

**CERTIFICATE:**

"I, Roland F. Sarko, Registered Land Surveyor in the State of Wisconsin, do hereby certify that I have inspected the above described property and that I have mapped the property according to the official records and that I have mapped the locations of all visible structures, the dimensions of all principal buildings, roadways, apparent easements and visible encroachments, if any. This mortgage inspection has been prepared in accordance with the requirements of Modern Abstract & Title and under an agreement between R.F. Sarko and Associates, Inc. and Modern Abstract & Title which excludes this mortgage inspection from all of the requirements of Section AE 7, per Section AE 7.01 (2), Wisconsin Administration Code, except Section AE 7.08, and therefore, this mortgage inspection does not comply with all of the requirements of Section AE 7. This mortgage inspection is made for the exclusive use of the present owners of the property and also those who purchase, mortgage or guarantee the title thereto within one year from date hereof and as to them we certify the accuracy of said mortgage inspection as shown."

Dated this 27th day of January, 1995.



Roland F. Sarko  
Wisconsin Registered Land Surveyor  
Number S-1377

