

**DUNHAM SURVEYING, S.C.**  
 SURVEYING & SUBDIVIDING  
 DELAVAN, WISCONSIN 53115



Scale - 1" = 60'  
 ∅ = Iron Pipe Found  
 ○ = Iron Pipe Set  
 Survey ordered by: Tincher Realty  
 514 West Main Street  
 Whitewater, WI 53190

STATE OF WISCONSIN)  
 COUNTY OF WALWORTH) SS



I, George T. Dunham, Surveyor, certify that I have surveyed the property described as follows:

The East line of Lot 2 of Certified Survey No. 350 recorded in Volume 2 of Certified Surveys on Page 129 in the Office of the Register of Deeds, Walworth County, Wisconsin, being a parcel of land located in the Northeast 1/4 of the Northwest 1/4 of Section 16, T 3 N, R 15 E, Walworth County, Wisconsin, and also stakes were set along each side of the centerline of the private road in said Certified Survey No. 350, located 6 feet from said centerline.

and that the plat shown hereon is a correct representation thereof and shows the location of the iron pipes set and those found from the survey made in March 1974

Survey June 1, 10, & 14, 1993

*George T. Dunham*  
 George T. Dunham, Surveyor

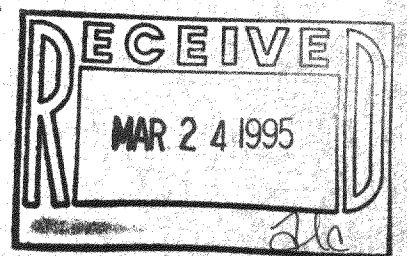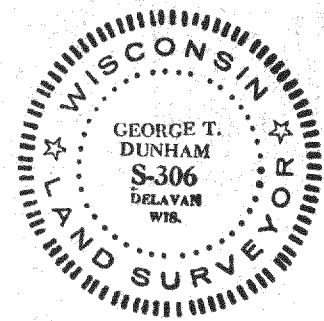

CA-350-1  
 CA-350-2  
 315-479