FARRIS, HANSEN & ASSOCIATES, INC.


ENGINEERING, ARCHITECTURE, SURVEYING 7 RIDGWAY COURT - P.O.BOX 437, ELKHORN, WISCONSIN 53121 PHONE: (414) 723-2098 FAX: (414) 723-5886

> PLAT OF SURVEY LOT 8 OF PINE EDGE A SUBDIVISION LOCAATED IN PART OF THE SOUTH 1/2 OF THE NE 1/4 OF SECTION 16 TOWN 3 NORTH, RANGE 15 EAST WALWORTH COUNTY, WISCONSIN




\$ 86.

WORK ORDERED BY: STEVE KRAHN C/O WALTON REALTY 202 E. MAIN ST. WHITEWATER, WI. 53190

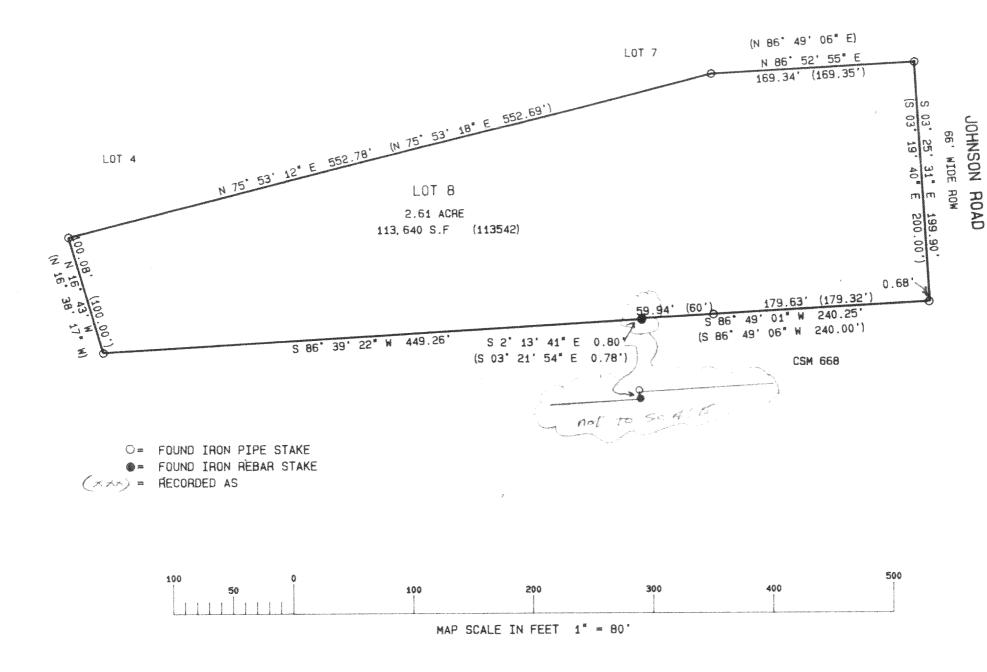

NOTE: COPIES OF THIS MAP TO WHICH THE FOLLOWING CERTIFICATE WILL APPLY ARE BLUE LINE PRINTS SHOWING SURVEYOR'S ORIGINAL SEAL AND SIGNATURE IN BLACK INK. COPIES BY ANY OTHER MEANS MAY HAVE ALTERATIONS WHICH DO NOT REPRESENT THE SURVEYOR'S WORK PRODUCT.

I HEREBY CERTIFY THAT THE ABOVE DESCRIBED PROPERTY HAS BEEN SURVEYED UNDER MY DIRECTION AND THAT THE ABOVE MAP IS A TRUE REPRESENTATION THEREOF AND SHOWS THE SIZE AND LOCATION OF THE PROPERTY AND ITS EXTERIOR BOUNDARIES. THIS SURVEY IS MADE FOR THE USE OF THE PRESENT OWNERS OF THE PROPERTY, AND ALSO THOSE WHO PURCHASE, MORTGAGE, OR GUARANTEE THE TITLE THERETO WITHIN ONE YEAR FROM THE DATE HEREOF.

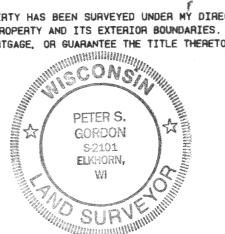

PROJ 3787.96

SHEET 1 OF 1