


STATE OF WISCONSIN)
 COUNTY OF WALWORTH) SS

I George T. Dunham, Surveyor, certify that I have surveyed the property described as follows,
 Lot 11 of Oak Knoll, a subdivision located in Section 34, T 4 N, R 15 E, and Section 3, T 3 N, R 15 E, Walworth County, Wisconsin,
 and that the above plat is an accurate survey and a true representation thereof and correctly shows the exterior boundary lines and location of buildings on said property and the correct measurements thereof.
 June 19, 1973

George T. Dunham
 George T. Dunham, Surveyor

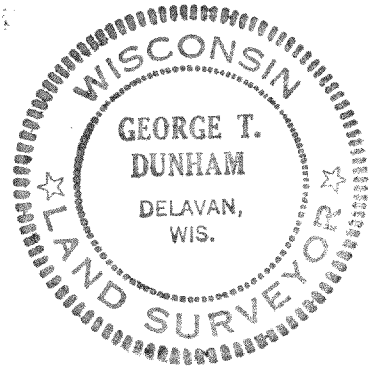

CDK - 11