


RECEIVED  
SEP 17 1997

# ABELL SURVEYING & MAPPING

1140 SEQUOIA STREET • DELAVAN, WISCONSIN 53115  
414-728-6737

PINE EDGE SUBDIVISION

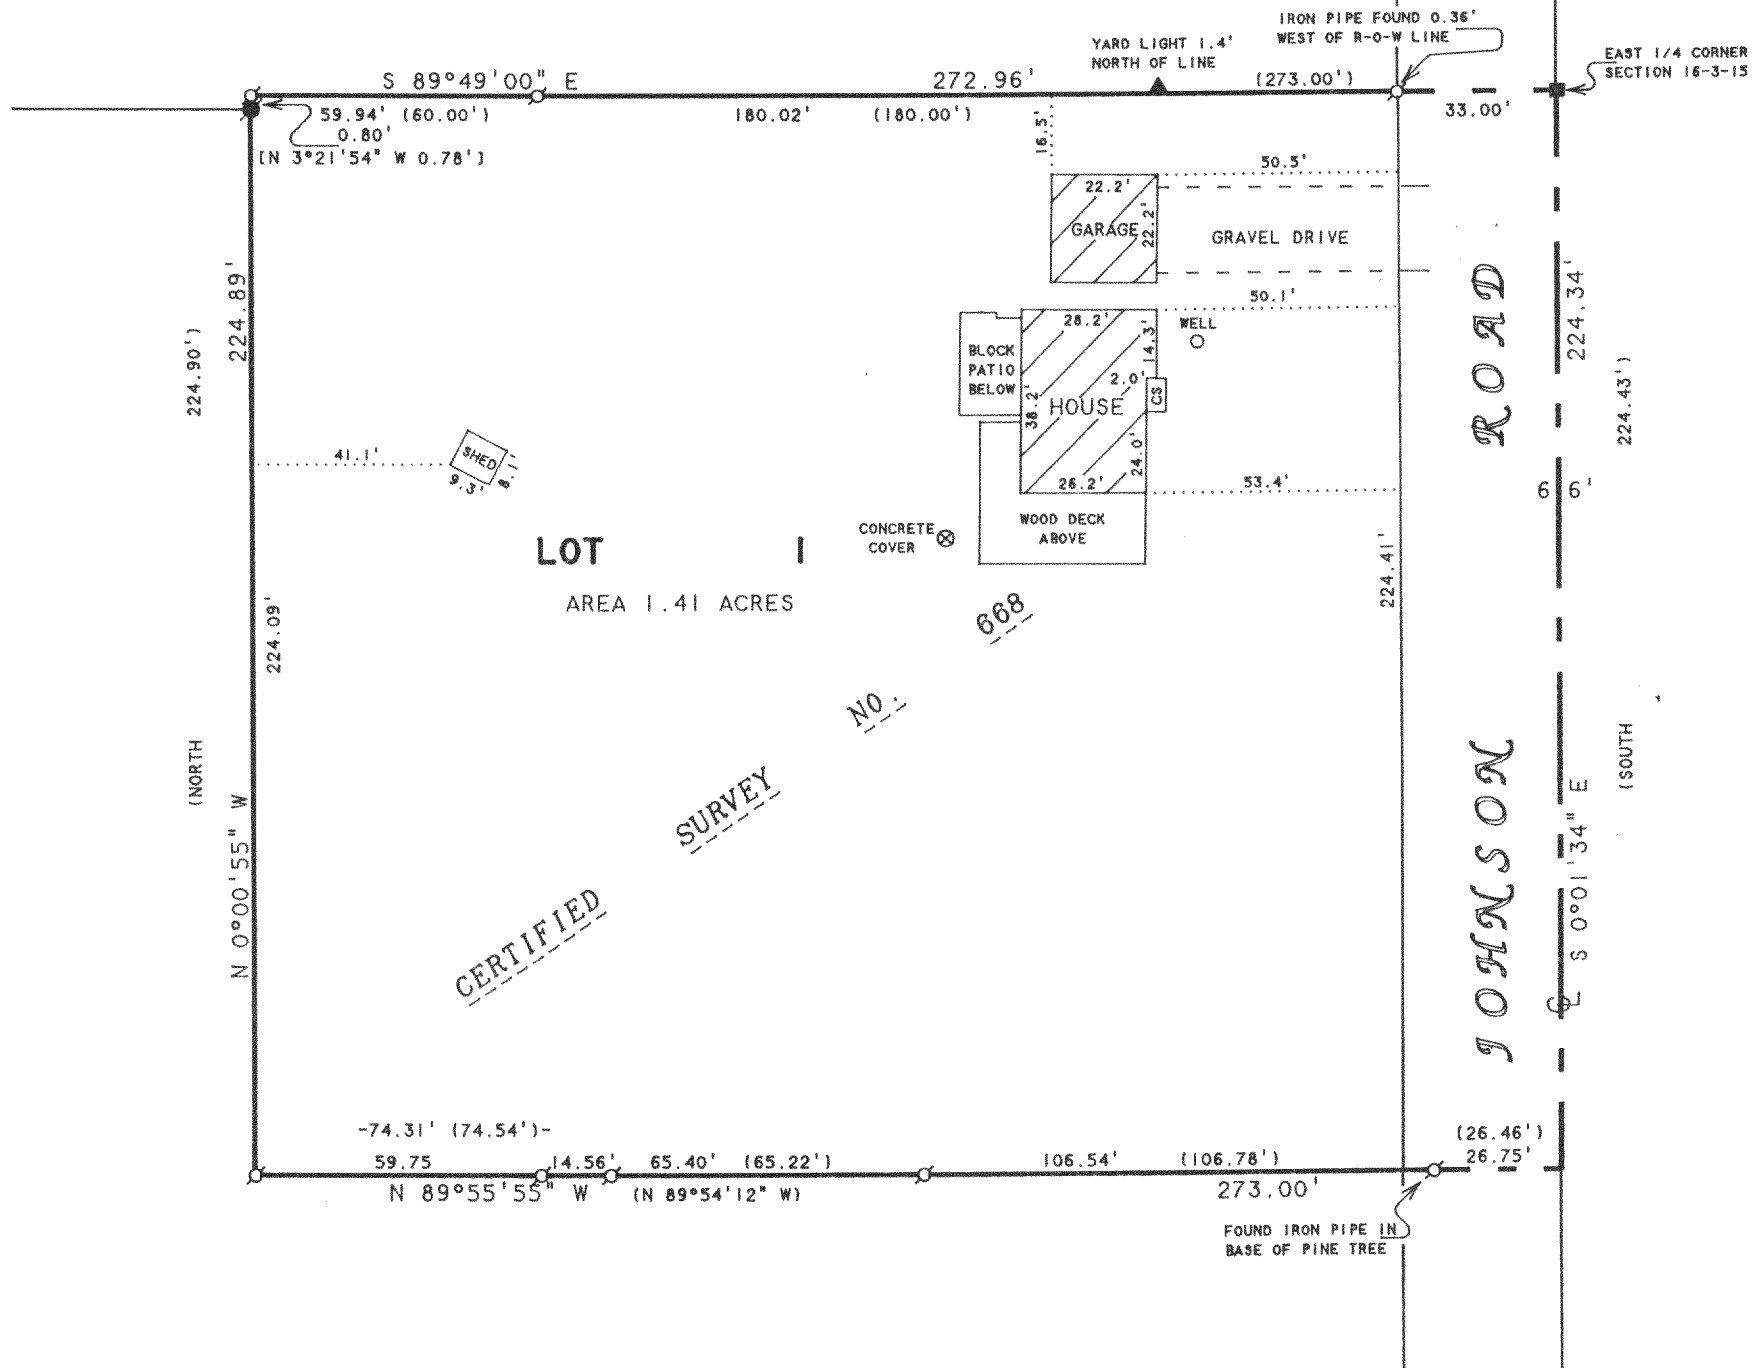

NOTE: BEARINGS ARE REFERENCED TO  
CERTIFIED SURVEY MAP NO. 668.

ORDERED BY: PROFESSIONAL REALTY  
1155 E. GENEVA STREET  
DELAVAN, WI 53115

## PLAT OF SURVEY OF

LOT 1, CERTIFIED SURVEY NO. 668, LOCATED IN THE NORTHEAST 1/4  
OF THE SOUTHEAST 1/4 OF SECTION 16, T3N, R15E, WALWORTH  
COUNTY, WISCONSIN.

N



SCALE 1"=40'

### LEGEND

- - IRON PIPE FOUND
- - IRON BAR FOUND
- CS - CONCRETE STOOP
- ( ) - RECORDED AS ON PLAT OF PINE EDGE SUBDIVISION
- ( ) - RECORDED AS

I HEREBY CERTIFY THAT I HAVE SURVEYED THE ABOVE DESCRIBED PROPERTY AND THAT THE ABOVE MAP IS A TRUE REPRESENTATION THEREOF AND SHOWS THE SIZE AND LOCATION OF THE PROPERTY, ITS EXTERIOR BOUNDARIES, THE LOCATION OF ALL VISIBLE STRUCTURES AND DIMENSIONS OF ALL PRINCIPAL BUILDINGS THEREON, BOUNDARY FENCES, APPARENT EASEMENTS, ROADWAYS AND VISIBLE ENCROACHMENTS, IF ANY, TO THE BEST OF MY KNOWLEDGE AND BELIEF.

THIS SURVEY IS MADE FOR THE USE OF THE PRESENT OWNERS OF THE PROPERTY, AND ALSO THOSE WHO PURCHASE, MORTGAGE, OR GUARANTEE THE TITLE THERETO WITHIN ONE (1) YEAR FROM DATE HEREON.

*David F. Abell*

DAVID F. ABELL  
WISCONSIN REGISTERED LAND SURVEYOR, S-1596

May 15, 1997

DATE: May 15, 1997 JOB NUMBER - 97085  
NOTE: THIS IS NOT A CERTIFIED COPY UNLESS SEALED.

CA-668-1  
315-599