

ABELL SURVEYING & MAPPING

DELAVER, WISCONSIN 53115

414-728-6737

LOT 11

LOT 12

LOT 33

LOT 32

LOT 31



SCALE 1"=30'

LEGEND

○ - IRON PIPE FOUND
() - RECORDED AS

NOTE: BEARINGS ARE REFERENCED TO THE
RECORDED SUBDIVISION PLAT.

ORDERED BY: TINCHER REAL ESTATE
514 W. MAIN STREET
WHITEWATER, WI 53190

RECERTIFIED: SEPTEMBER 23, 1997
ORDERED BY: JEFF BELLA
510 40TH PLACE
KENOSHA, WI 53140

I HEREBY CERTIFY THAT I HAVE SURVEYED THE ABOVE DESCRIBED PROPERTY AND THAT THE
ABOVE MAP IS A TRUE REPRESENTATION THEREOF AND SHOWS THE SIZE AND LOCATION OF
THE PROPERTY, ITS EXTERIOR BOUNDARIES, THE LOCATION OF ALL VISIBLE STRUCTURES
AND DIMENSIONS OF ALL PRINCIPAL BUILDINGS THEREON, BOUNDARY FENCES, APPARENT
EASEMENTS, ROADWAYS AND VISIBLE ENCROACHMENTS, IF ANY, TO THE BEST OF MY
KNOWLEDGE AND BELIEF.

THIS SURVEY IS MADE FOR THE USE OF THE PRESENT OWNERS OF THE PROPERTY, AND ALSO
THOSE WHO PURCHASE, MORTGAGE, OR GUARANTEE THE TITLE THERETO WITHIN ONE (1) YEAR
FROM DATE HEREON.

David F. Abell

DAVID F. ABELL
WISCONSIN REGISTERED LAND SURVEYOR, S-1596


September 23, 1997

DATE: JOB NUMBER - 92029
NOTE: THIS IS NOT A CERTIFIED COPY UNLESS SEALED.

BLOCK

CHAPEL

DRIVE

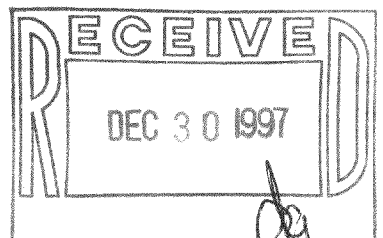

PLAT OF SURVEY OF

LOT 32, BLOCK 1 OF RICHMOND HEIGHTS,
LOCATED IN T3N, R15E, WALWORTH COUNTY
WISCONSIN.

CRH-29

315-6116