
PLAT OF SURVEY

LOTS 13, 14 AND THE EASTERLY 1/2 OF LOT 15, BLOCK 1, RICHMOND HEIGHTS, being a Subdivision located in the Northeast 1/4 of the Southeast 1/4, the Northwest 1/4 of the Southeast 1/4 and the Southwest 1/4 of the Southeast 1/4 of Section 3, Town 3 North, Range 15 East, Walworth County, Wisconsin.

Surveyed for: Century 21, Walton Realty

Survey address: N7024 Oakwood Road

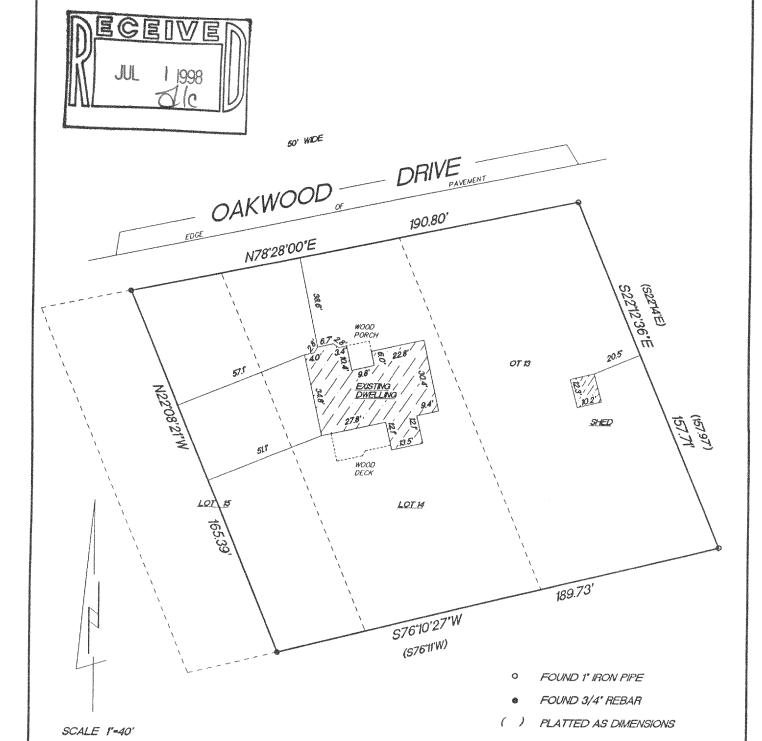

"I hereby certify that I have surveyed the above described property and that the above map is a true representation thereof and shows the size and location of the property, its exterior boundaries, the location of all visible structures and dimension of all principal buildings thereon, boundary fences, apparent easements, roadways and encroachments if any."

"This survey is made for the use of the present owners of the property, and also those who purchase, mortgage or guarantee the title thereto within one year from date hereof."

6/23/98 TEP/DW DATE FIELD WORK BY



W362 S10227 Lewin Lane Eagle, Wisconsin 53119 Terrance E.Pisarek R.L.S.

(414) 594-3484

fax (414) 594-5904

THIS IS NOT AN ORIGINAL SURVEY UNLESS THE SEAL IS RED.

TEP 98140 DRAWN BY JOB NUMBER