
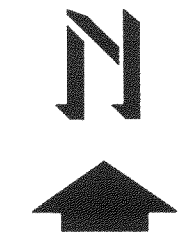


ABELL SURVEYING & MAPPING

DELAVER, WISCONSIN 53115


414-728-6737

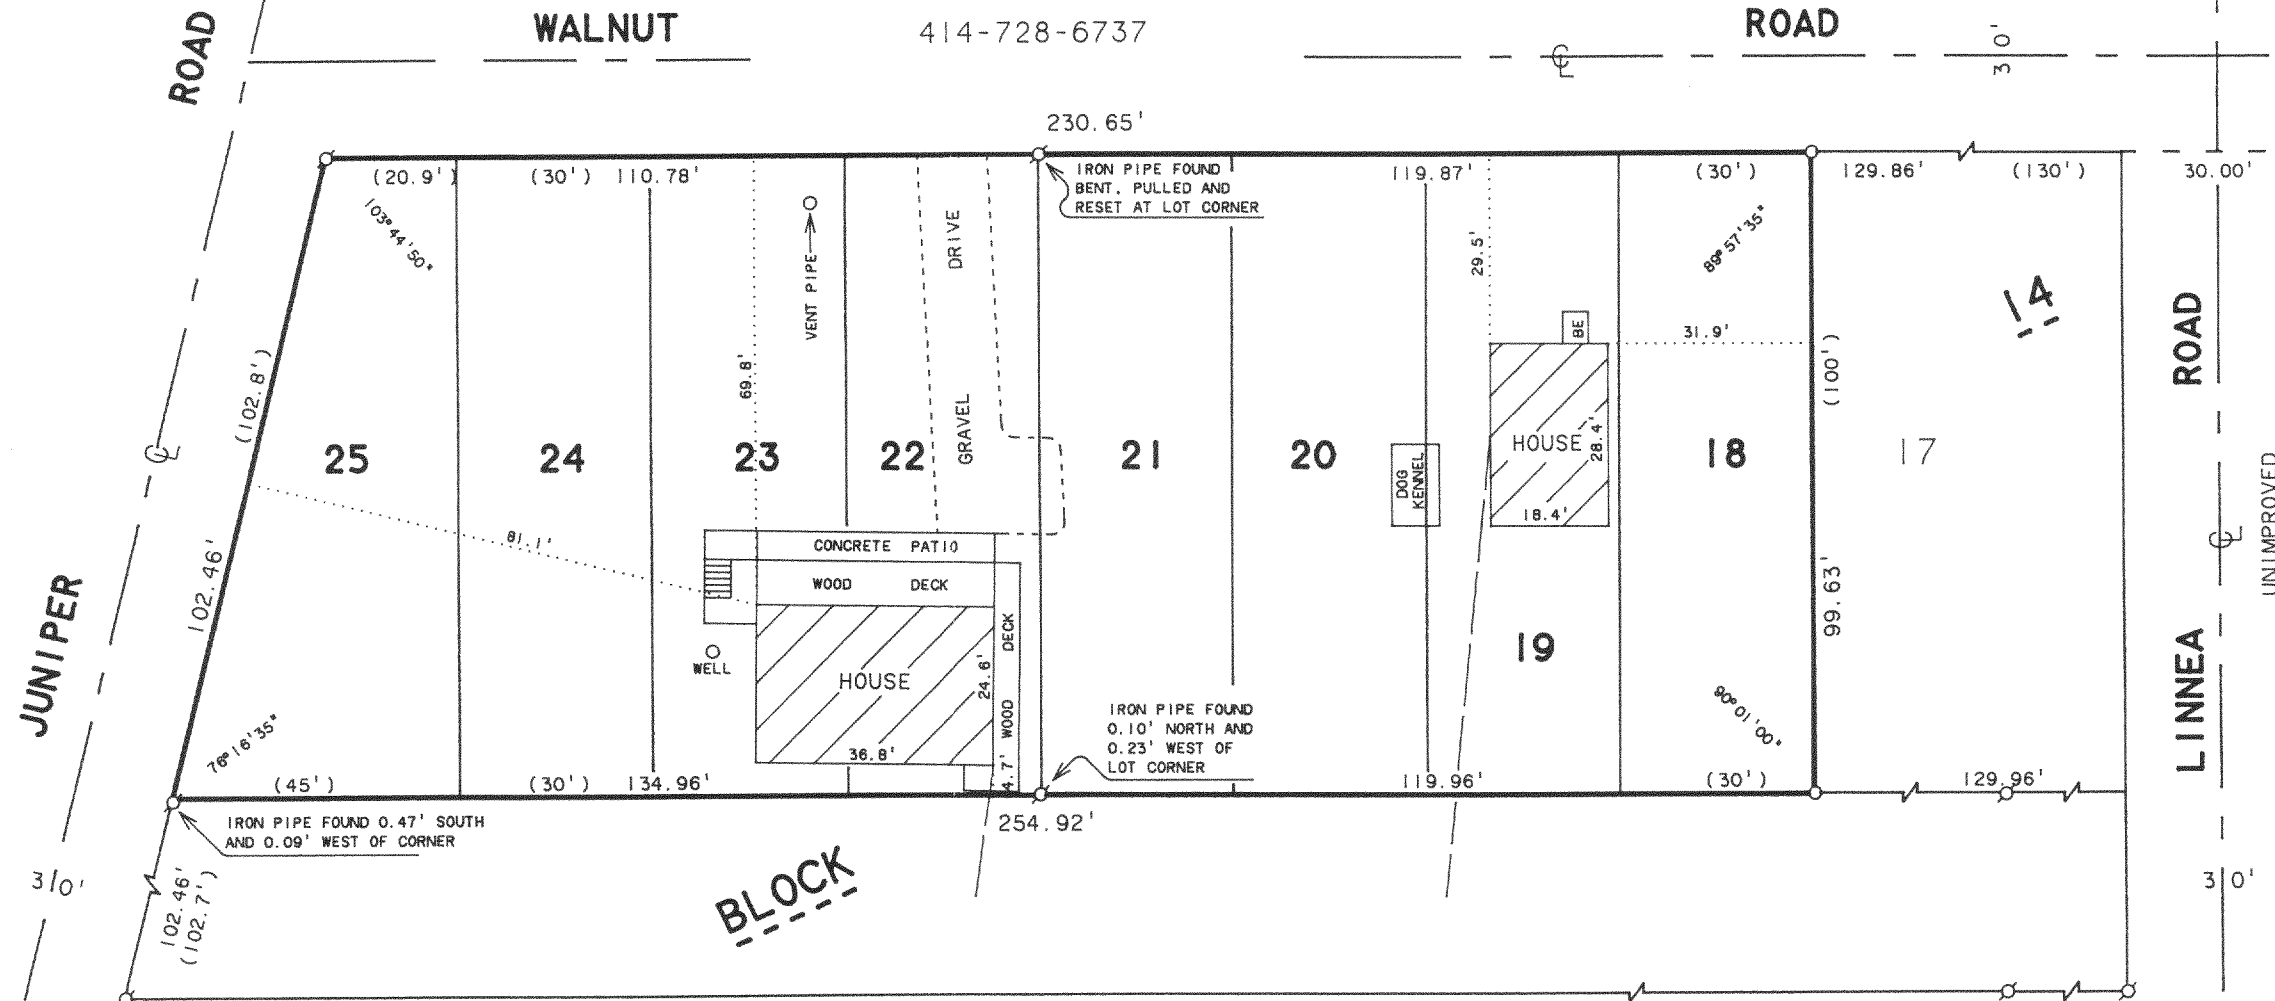

SCALE 1"=30'

LEGEND

- Ø - IRON PIPE FOUND
- - IRON PIPE SET, Found 12/14/98
- BE - BASEMENT ENTRY
- - OVERHEAD UTILITY LINES
- () - RECORDED AS

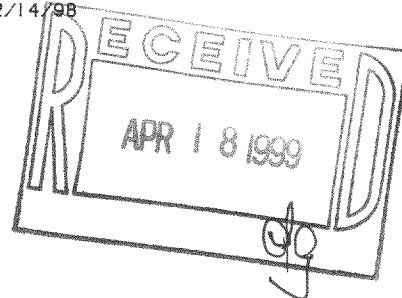

ORDERED BY: KEN SCHELL
RT 1 BOX 242
DELAVER, WI. 53115

PLAT OF SURVEY OF

LOT 18-25, BLOCK 14, SKANSENS SWEDISH
TRIBUNE NEWS SUBDIVISION, LOCATED IN
T3N, R1E, WALWORTH COUNTY, WISCONSIN.

RECERTIFIED: DECEMBER 14, 1998
ORDERED BY: COLDWELL BANKER - GENEVA REALTY
838 MAIN STREET
LAKE GENEVA, WI 53147

I HEREBY CERTIFY THAT I HAVE SURVEYED THE ABOVE DESCRIBED PROPERTY AND THAT THE ABOVE MAP IS A TRUE REPRESENTATION THEREOF AND SHOWS THE SIZE AND LOCATION OF THE PROPERTY, ITS EXTERIOR BOUNDARIES, THE LOCATION OF ALL VISIBLE STRUCTURES AND DIMENSIONS OF ALL PRINCIPAL BUILDINGS THEREON, BOUNDARY FENCES, APPARENT EASEMENTS, ROADWAYS AND VISIBLE ENCROACHMENTS, IF ANY, TO THE BEST OF MY KNOWLEDGE AND BELIEF.

THIS SURVEY IS MADE FOR THE USE OF THE PRESENT OWNERS OF THE PROPERTY, AND ALSO THOSE WHO PURCHASE, MORTGAGE, OR GUARANTEE THE TITLE THERETO WITHIN ONE (1) YEAR FROM DATE HEREON.

David F. Abell

DAVID F. ABELL
WISCONSIN REGISTERED LAND SURVEYOR, S-1596

August 26, 1992

DATE: August 26, 1992 JOB NUMBER - 92192
NOTE: THIS IS NOT A CERTIFIED COPY UNLESS SEALED.

CS-231
CS-233
CS-235

315-655