


TERRITORIAL ROAD

**ABELL
SURVEYING & MAPPING**

1140 SEQUOIA STREET • DELAVAN, WISCONSIN 53115
414-728-6737

NOTE: BEARINGS ARE REFERENCED TO CERTIFIED SURVEY MAP NO. 2114.

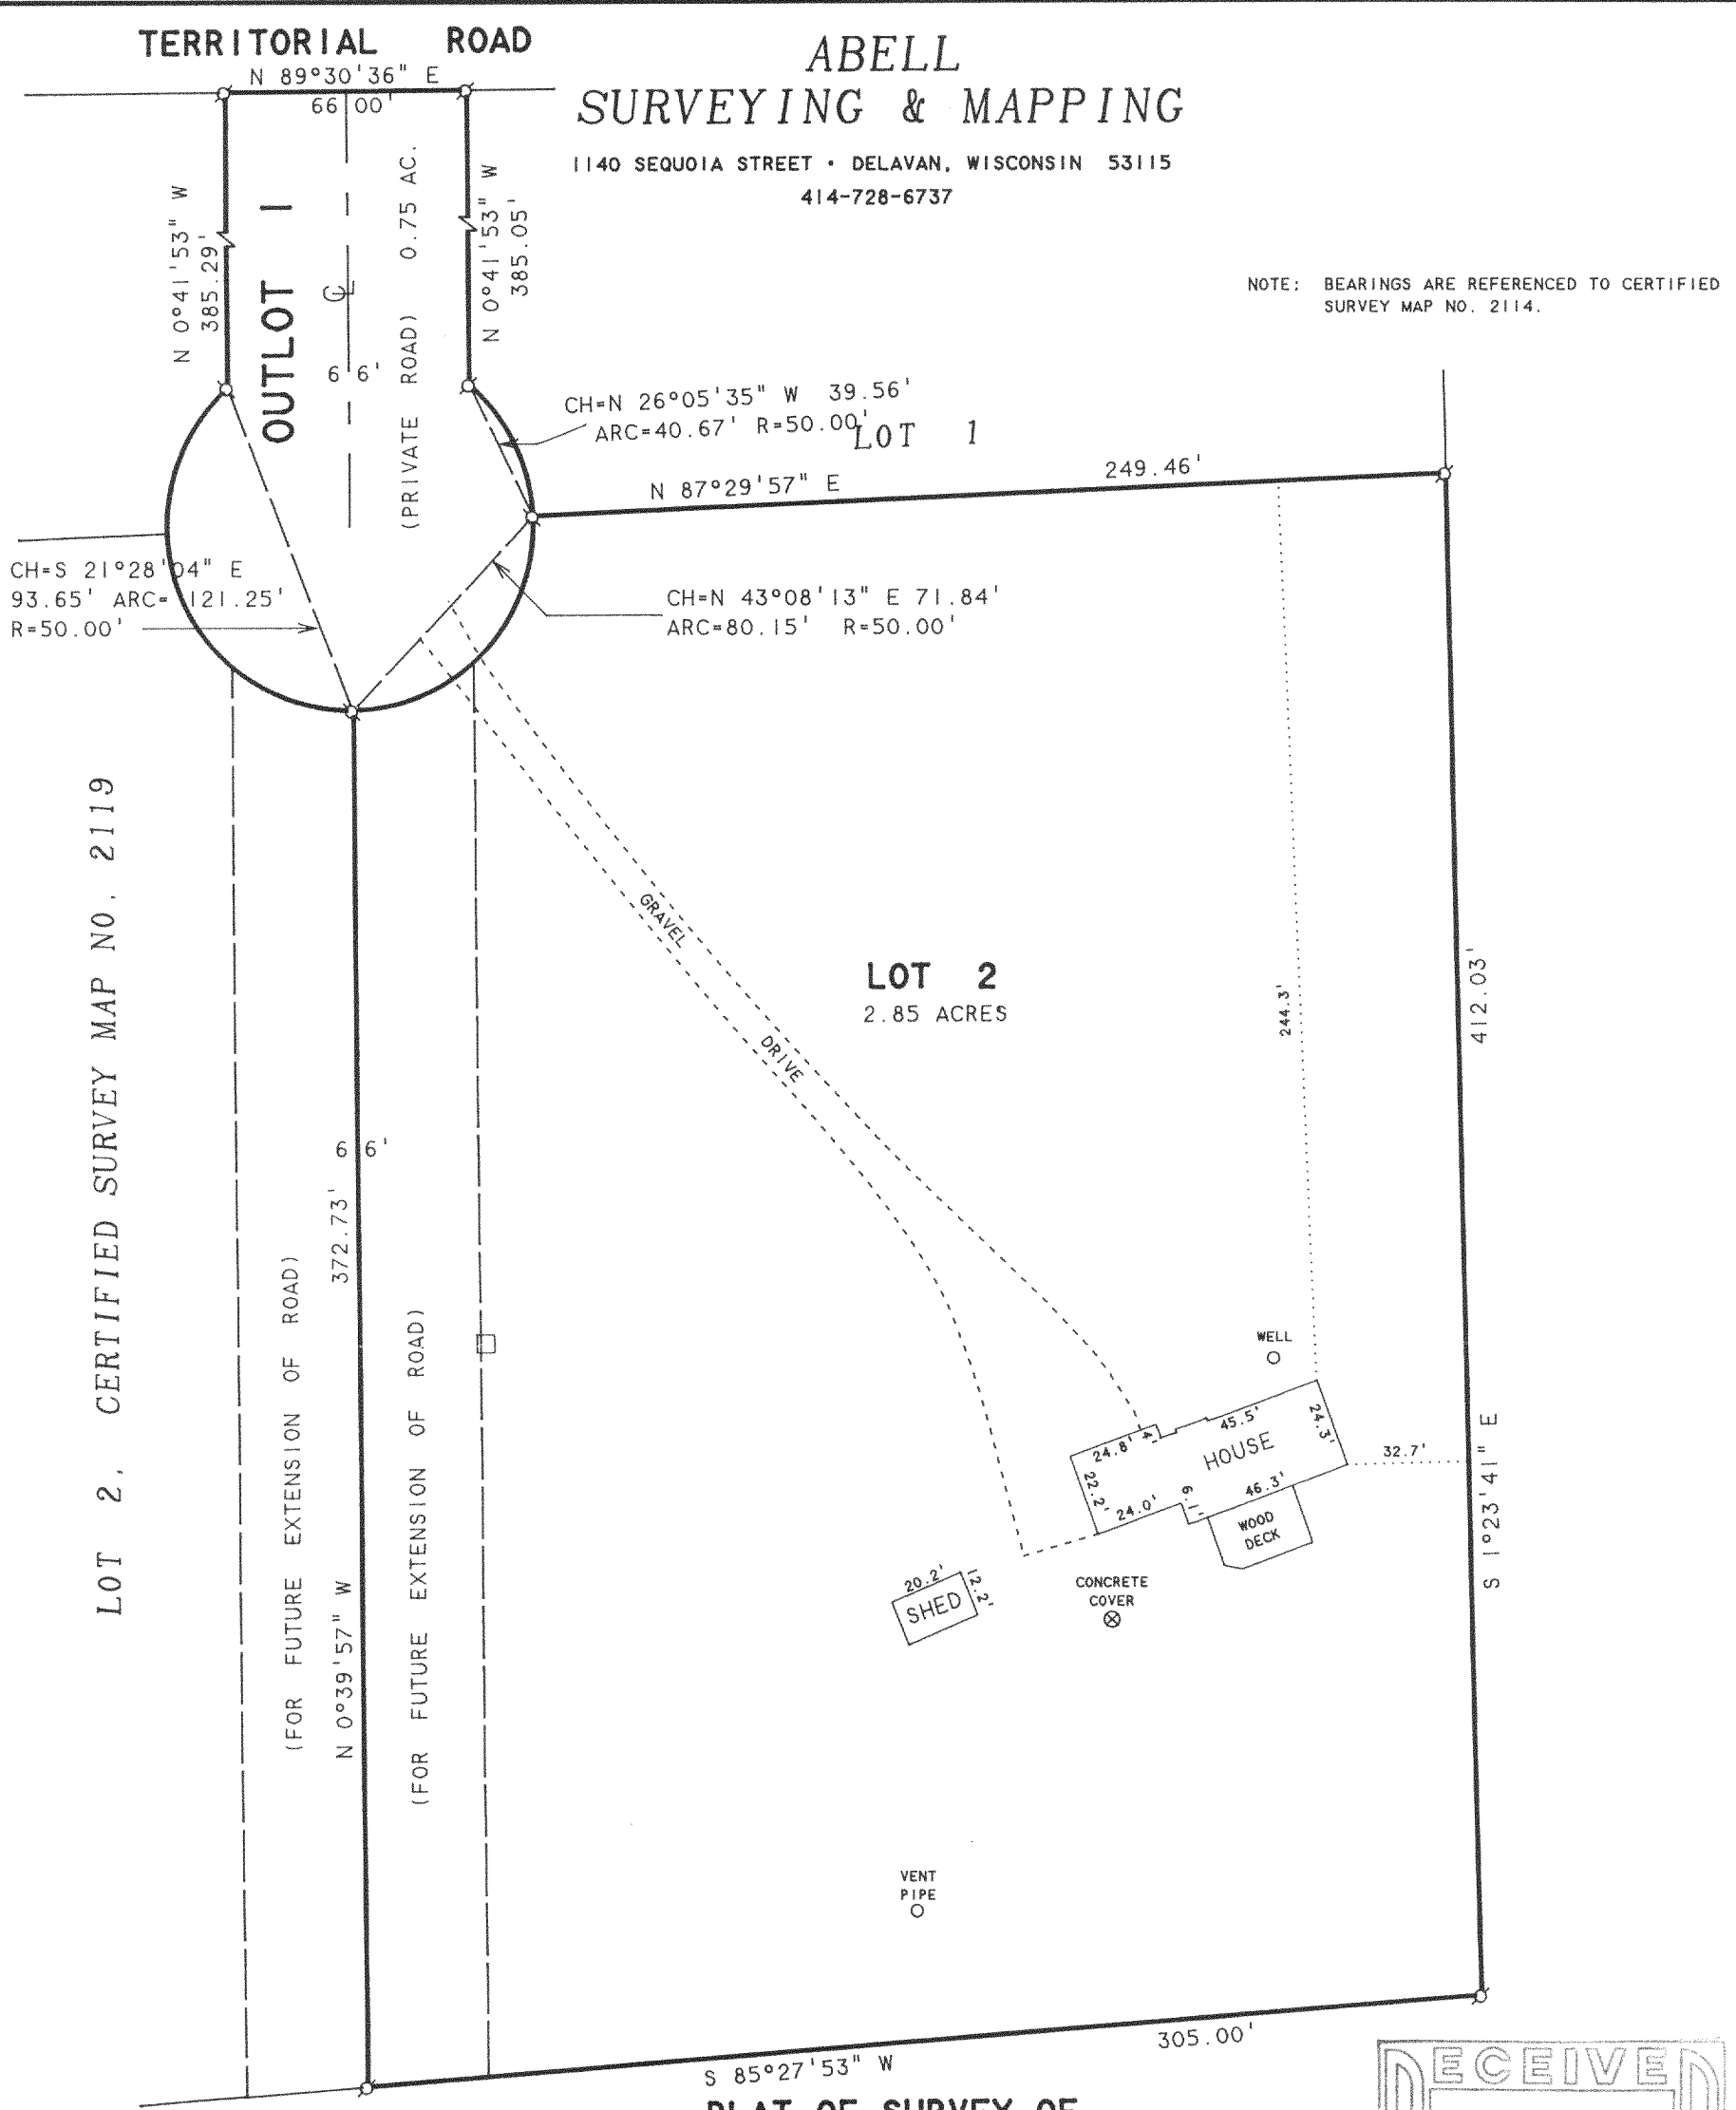


LOT 2, CERTIFIED SURVEY MAP NO. 2119

PLAT OF SURVEY OF

LOT 2 AND 1/2 INTEREST IN OUTLOT 1 OF CERTIFIED SURVEY MAP NO. 2114, LOCATED IN THE NORTHWEST 1/4 OF THE NORTHWEST 1/4 OF SECTION 11, T3N, R15E, WALWORTH COUNTY, WISCONSIN.

ORDERED BY: WHISPERING OAKS REALTY
P.O. BOX 16
ELKHORN, WI 53121

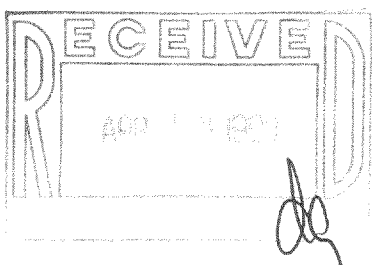

SCALE 1"=50'

LEGEND

- ⊗ - IRON PIPE FOUND
- - UTILITY PED.
- () - RECORDED AS

I HEREBY CERTIFY THAT I HAVE SURVEYED THE ABOVE DESCRIBED PROPERTY AND THAT THE ABOVE MAP IS A TRUE REPRESENTATION THEREOF AND SHOWS THE SIZE AND LOCATION OF THE PROPERTY, ITS EXTERIOR BOUNDARIES, THE LOCATION OF ALL VISIBLE STRUCTURES AND DIMENSIONS OF ALL PRINCIPAL BUILDINGS THEREON, BOUNDARY FENCES, APPARENT EASEMENTS, ROADWAYS AND VISIBLE ENCROACHMENTS, IF ANY, TO THE BEST OF MY KNOWLEDGE AND BELIEF.

THIS SURVEY IS MADE FOR THE USE OF THE PRESENT OWNERS OF THE PROPERTY, AND ALSO THOSE WHO PURCHASE, MORTGAGE, OR GUARANTEE THE TITLE THERETO WITHIN ONE (1) YEAR FROM DATE HEREON.

David F. Abell

DAVID F. ABELL
WISCONSIN REGISTERED LAND SURVEYOR, S-1596

March 3, 1999

REVISED: 3/5/99

DATE: _____ JOB NUMBER - 92006A
NOTE: THIS IS NOT A CERTIFIED COPY UNLESS SEALED.


CA-2114-2

315-657

**ABELL
SURVEYING & MAPPING**
1140 SEQUOIA STREET • DELAVAN, WISCONSIN 53115
414-728-6737

NOTE: BEARINGS ARE REFERENCED TO CERTIFIED SURVEY MAP NO. 2114.


LOT 2, CERTIFIED SURVEY MAP NO. 2119

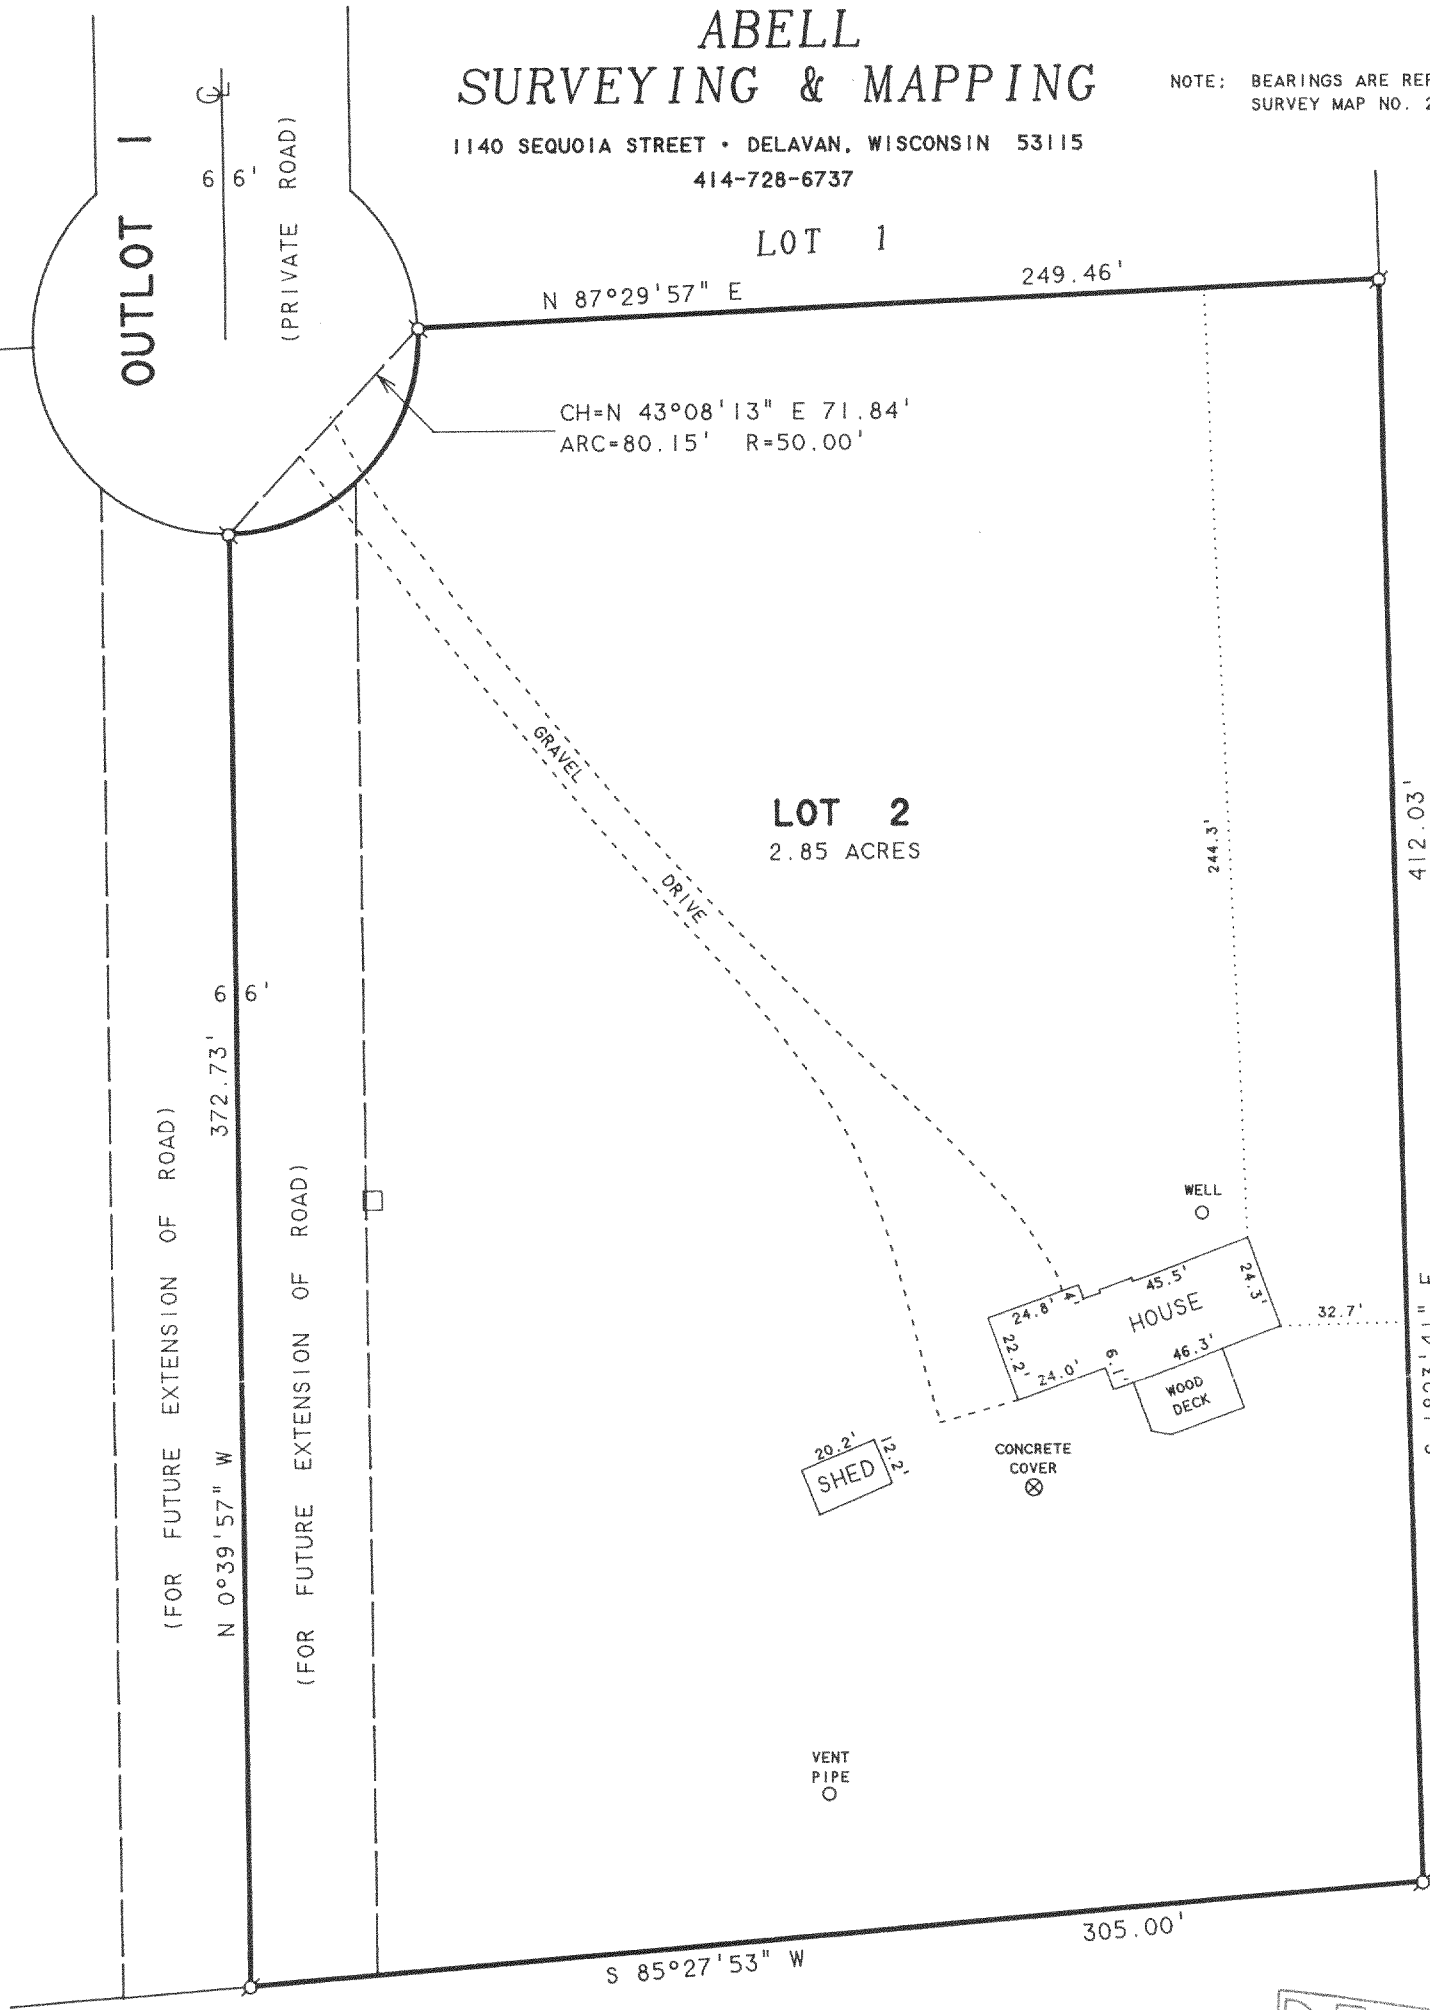

PLAT OF SURVEY OF

LOT 2, CERTIFIED SURVEY MAP NO. 2114, LOCATED IN THE NORTHWEST 1/4 OF THE NORTHEAST 1/4 OF SECTION 11, T3N, R15E, WALWORTH COUNTY, WISCONSIN.

ORDERED BY: WHISPERING OAKS REALTY
P.O. BOX 16
ELKHORN, WI 53121

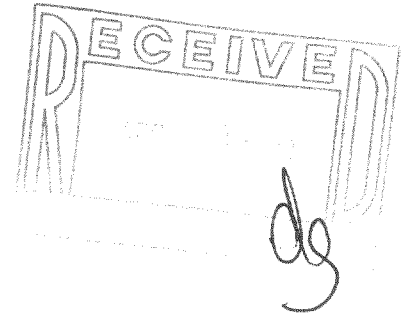

SCALE 1"=50'

LEGEND

- ⊙ - IRON PIPE FOUND
- - UTILITY PED.
- () - RECORDED AS

I HEREBY CERTIFY THAT I HAVE SURVEYED THE ABOVE DESCRIBED PROPERTY AND THAT THE ABOVE MAP IS A TRUE REPRESENTATION THEREOF AND SHOWS THE SIZE AND LOCATION OF THE PROPERTY, ITS EXTERIOR BOUNDARIES, THE LOCATION OF ALL VISIBLE STRUCTURES AND DIMENSIONS OF ALL PRINCIPAL BUILDINGS THEREON, BOUNDARY FENCES, APPARENT EASEMENTS, ROADWAYS AND VISIBLE ENCROACHMENTS, IF ANY, TO THE BEST OF MY KNOWLEDGE AND BELIEF.

THIS SURVEY IS MADE FOR THE USE OF THE PRESENT OWNERS OF THE PROPERTY, AND ALSO THOSE WHO PURCHASE, MORTGAGE, OR GUARANTEE THE TITLE THERETO WITHIN ONE (1) YEAR FROM DATE HEREON.

David F. Abell

DAVID F. ABELL
WISCONSIN REGISTERED LAND SURVEYOR, S-1596

March 3, 1999

DATE: _____ JOB NUMBER - 92006A
NOTE: THIS IS NOT A CERTIFIED COPY UNLESS SEALED.