


# PLAT OF SURVEY

LOT 2 AND OUTLOT 1 OF CERTIFIED SURVEY MAP No. 2566  
 LOCATED IN THE SOUTHEAST 1/4 AND THE NORTHEAST 1/4 OF THE  
 SOUTHWEST 1/4 OF SECTION 4, TOWN 3 NORTH, RANGE 15 EAST,  
 TOWN OF RICHMOND, WALWORTH COUNTY, WISCONSIN

PREPARED FOR:  
**BRITT & MICHELLE MINTON**  
 N7550 EAST LAKESHORE DRIVE  
 WHITEWATER, WISCONSIN




BEARING BASE: AS RECORDED  
 ON CERTIFIED SURVEY  
 MAP No. 2566

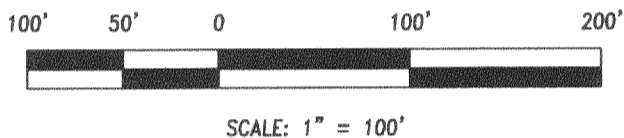

- LEGEND**
- ⊙ - FOUND IRON REBAR
  - ⊕ - FOUND COUNTY MONUMENT
  - ( ) - RECORDED AS

LOT 1

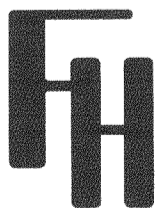

**FARRIS, HANSEN & ASSOC. INC.**  
 ENGINEERS • SURVEYORS • ARCHITECTS


7 Ridgway Court  
 P.O. Box 437  
 Elkhorn, WI. 53121  
 Tel. 414-723-2098  
 Fax. 414-723-5886  
 Proj No. 5345  
 Date: 08/13/99

UNPLATTED LANDS

LOT 2  
 6.76 ACRES

UNPLATTED LANDS

PROPOSED DWELLING  
 (SEE DETAIL)

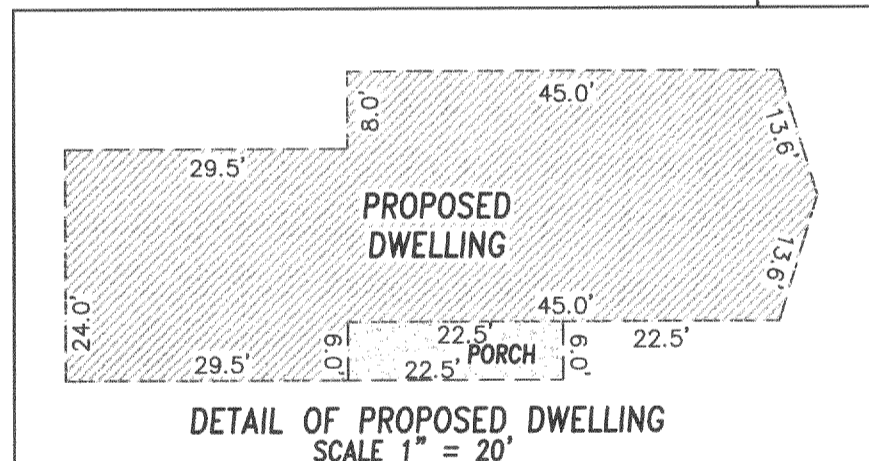


NOTE: COPIES OF THIS MAP TO WHICH THE FOLLOWING CERTIFICATE WILL APPLY ARE PRINTS SHOWING SURVEYOR'S ORIGINAL SEAL AND SIGNATURE IN RED INK. COPIES BY ANY OTHER MEANS MAY HAVE ALTERATIONS WHICH DO NOT REPRESENT THE SURVEYOR'S WORK PRODUCT.

I HEREBY CERTIFY THAT THE ABOVE DESCRIBED PROPERTY HAS BEEN SURVEYED UNDER MY DIRECTION AND THAT THE ABOVE MAP IS A TRUE REPRESENTATION THEREOF AND SHOWS THE SIZE AND LOCATION OF THE PROPERTY AND ITS EXTERIOR BOUNDARIES. THIS SURVEY IS MADE FOR THE USE OF THE PRESENT OWNERS OF THE PROPERTY, AND ALSO THOSE WHO PURCHASE, MORTGAGE, OR GUARANTEE THE TITLE THERETO WITHIN ONE YEAR FROM THE DATE HEREOF.

DATED: AUGUST 13, 1999

*Randal J. Mathwick*  
 RANDAL J. MATHWICK

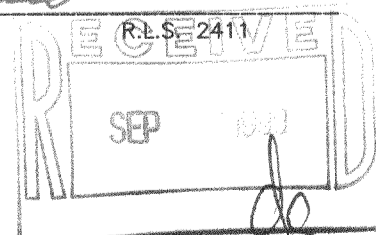

**TERRITORIAL**  
 SOUTH LINE

SOUTH 1/4 CORNER  
 SECT. 4-3-15

ROAD (66' WIDE)




CA-2566-2  
 315-669

# FARRIS, HANSEN & ASSOCIATES, INC.

ENGINEERING — ARCHITECTURE — SURVEYING  
 7 RIDGWAY COURT — P.O. BOX 437 — ELKHORN, WISCONSIN 53121  
 PHONE: (262) 723-2098 FAX: (262) 723-5886

ADDENDUM TO PLAT OF SURVEY DONE BY  
**RANDAL J. MATHWICK — AUGUST 1999**  
 LOT 2 AND OUTLOT 1 OF CERTIFIED SURVEY MAP NO. 2566  
 TOWN OF RICHMOND, WALWORTH COUNTY, WISCONSIN

— WORK ORDERED BY —  
 BRITT & MICHELLE MINTON  
 N.7550 EAST LAKESHORE DRIVE  
 WHITEWATER, WISCONSIN

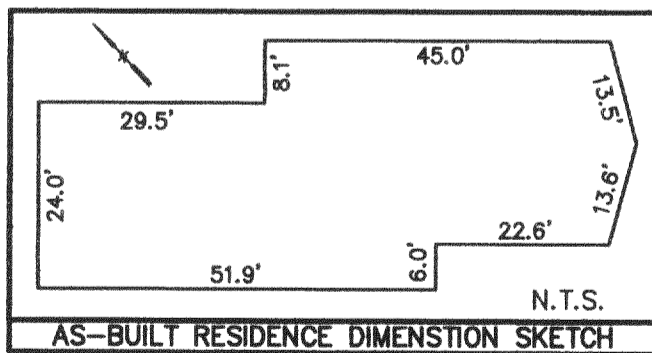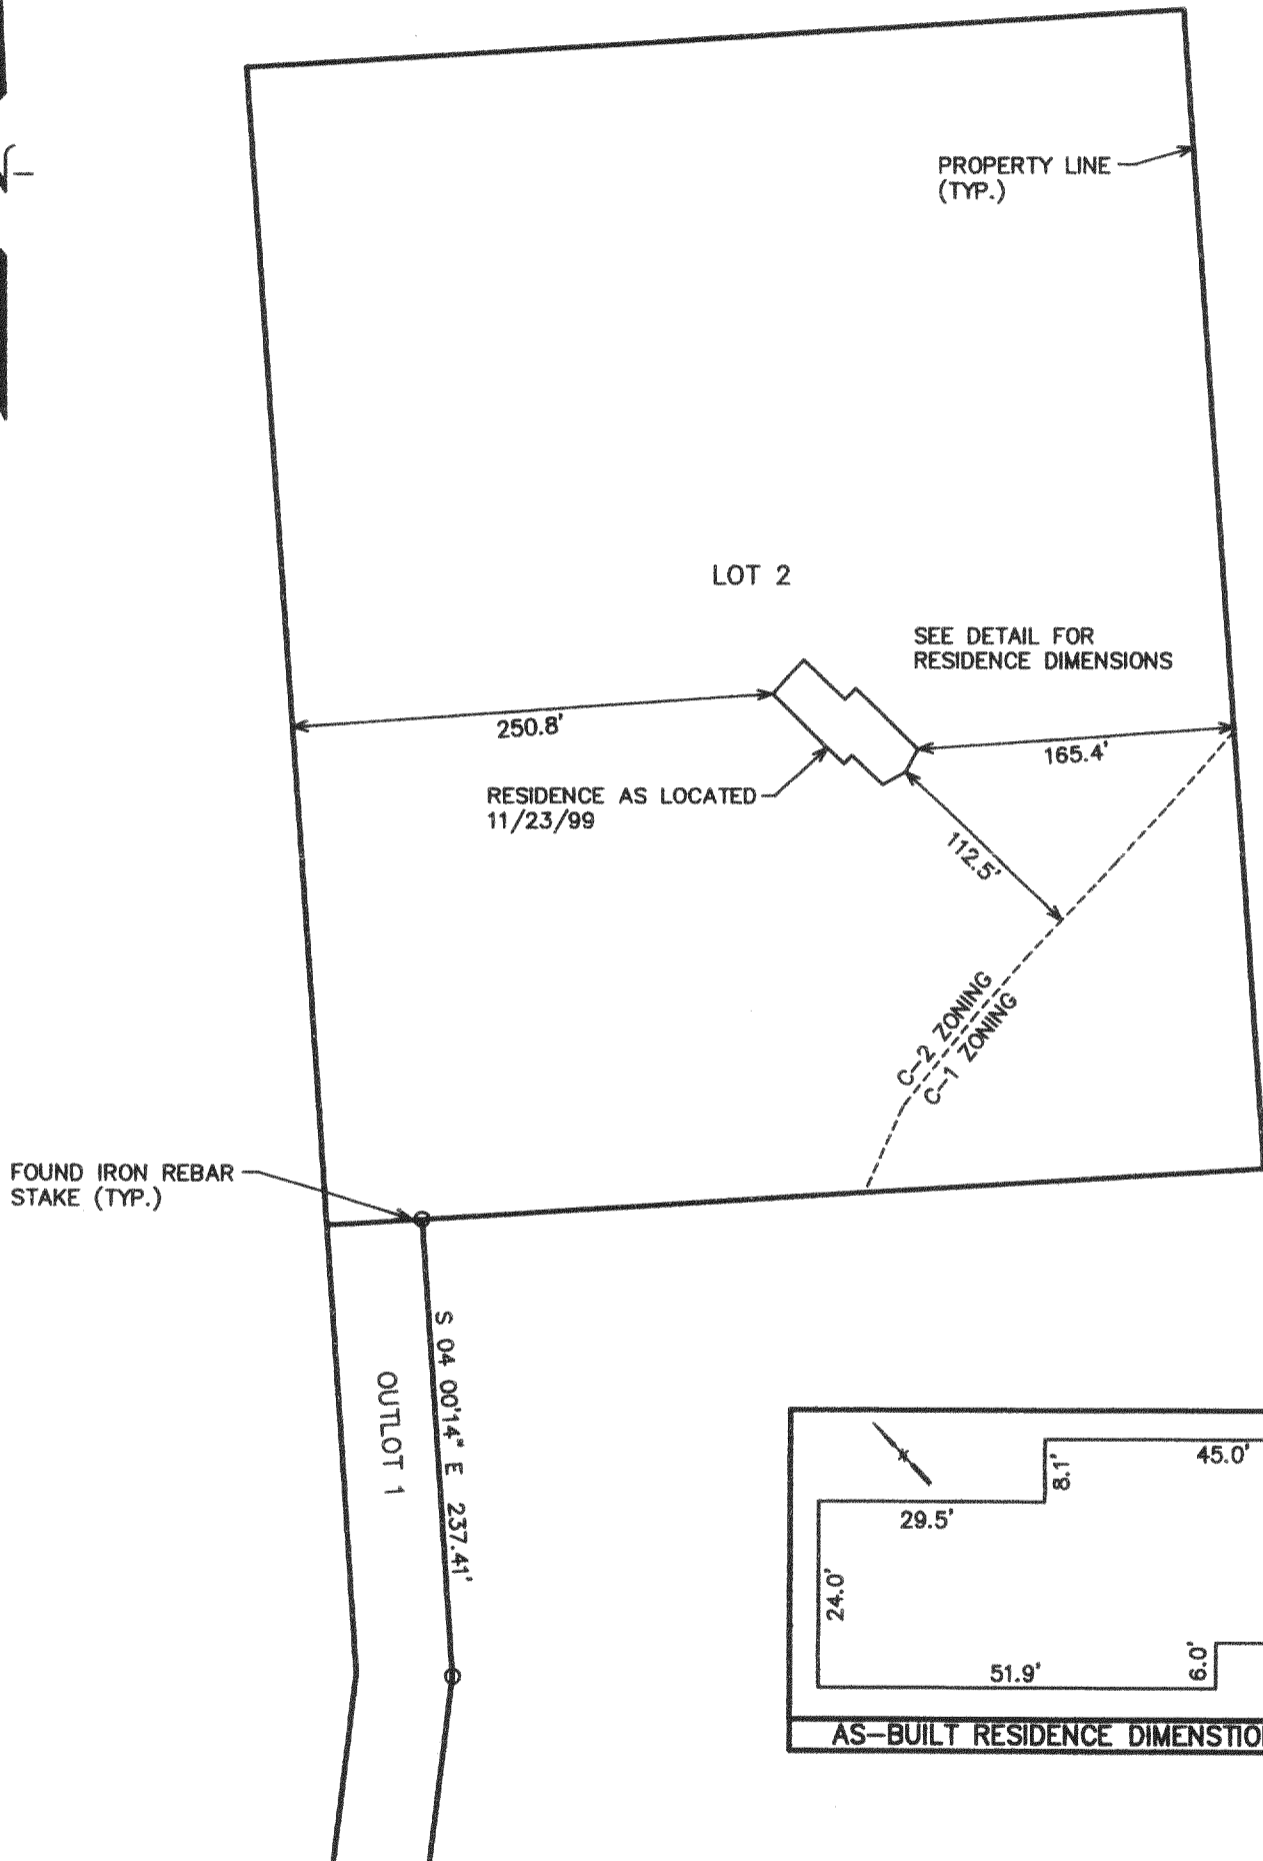
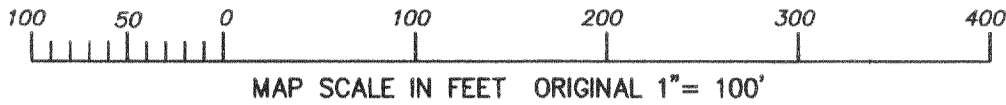


NOTE: COPIES OF THIS MAP TO WHICH THE FOLLOWING CERTIFICATE WILL APPLY SHOW THE SURVEYOR'S ORIGINAL SEAL AND SIGNATURE IN RED INK. COPIES BY ANY OTHER MEANS MAY HAVE ALTERATIONS WHICH DO NOT REPRESENT THE SURVEYOR'S WORK PRODUCT.

I HEREBY CERTIFY THAT THIS PLAT IS A TRUE AND ACCURATE REPRESENTATION OF THE LOCATION OF THE ASBUILT RESIDENCE IN RELATION TO THE MONUMENTS FOUND AND SHOWN REPRESENTING THE NORTHERLY MOST CORNERS ON THE EAST LINE OF OUTLOT 1 OF CERTIFIED SURVEY MAP NO. 2566 TO THE BEST OF MY PROFESSIONAL KNOWLEDGE AND BELIEF. NOTE THIS IS NOT A PLAT OF SURVEY AS DEFINED IN CHAPTER A-E 7 OF WISCONSIN ADMINISTRATIVE CODE

DATED: 11/29/99

*Peter S. Gordon*  
 PETER S. GORDON RLS 2101

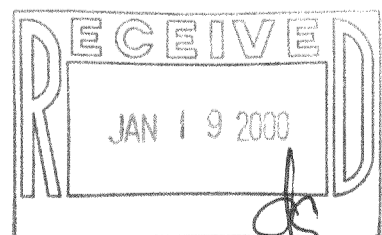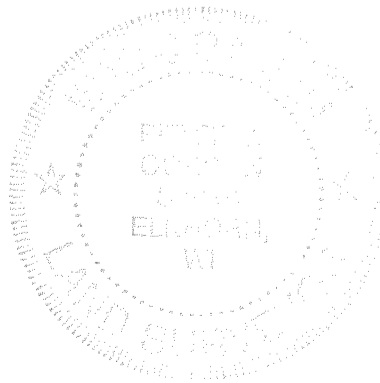


PROJECT: 5345  
 DATE: 11/29/99  
 SHEET 1 OF 1

315-669


# PLAT OF SURVEY

LOT 2 AND OUTLOT 1 OF CERTIFIED SURVEY MAP No. 2566  
 LOCATED IN THE SOUTHEAST 1/4 AND THE NORTHEAST 1/4 OF THE  
 SOUTHWEST 1/4 OF SECTION 4, TOWN 3 NORTH, RANGE 15 EAST,  
 TOWN OF RICHMOND, WALWORTH COUNTY, WISCONSIN

PREPARED FOR:  
**BRITT & MICHELLE MINTON**  
 N7550 EAST LAKESHORE DRIVE  
 WHITEWATER, WISCONSIN

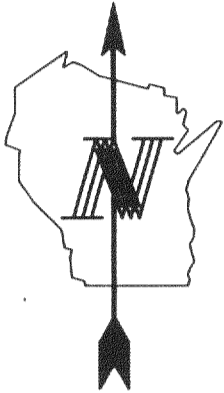

BEARING BASE: AS RECORDED  
 ON CERTIFIED SURVEY  
 MAP No. 2566

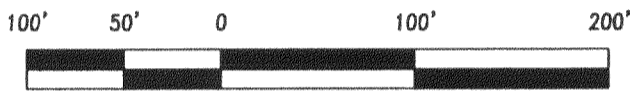

SCALE: 1" = 100'



- LEGEND**
- ⊙ - FOUND IRON REBAR
  - ⊕ - FOUND COUNTY MONUMENT
  - ( ) - RECORDED AS



**FARRIS, HANSEN & ASSOC. INC.**  
 ENGINEERS • SURVEYORS • ARCHITECTS

7 Ridgway Court  
 P.O. Box 437  
 Elkhorn, WI. 53121  
 Tel. 414-723-2098  
 Fax. 414-723-5886  
 Proj No. 5345  
 Date: 08/13/99

LOT 1

**TERRITORIAL** SOUTH LINE  
 50.00' S 86°38'20" W  
 525.00' 4-3-15



OUTLOT 1 0.89 ACRES  
 N 06°57'18" E 443.57'  
 S 06°57'18" W 443.59'

UNPLATTED LANDS

LOT 2  
 6.76 ACRES

PROPOSED DWELLING  
 (SEE DETAIL)

UNPLATTED LANDS

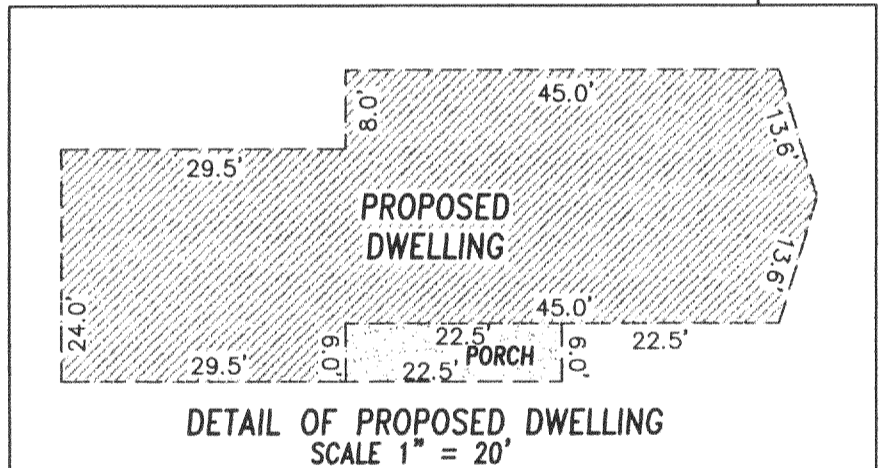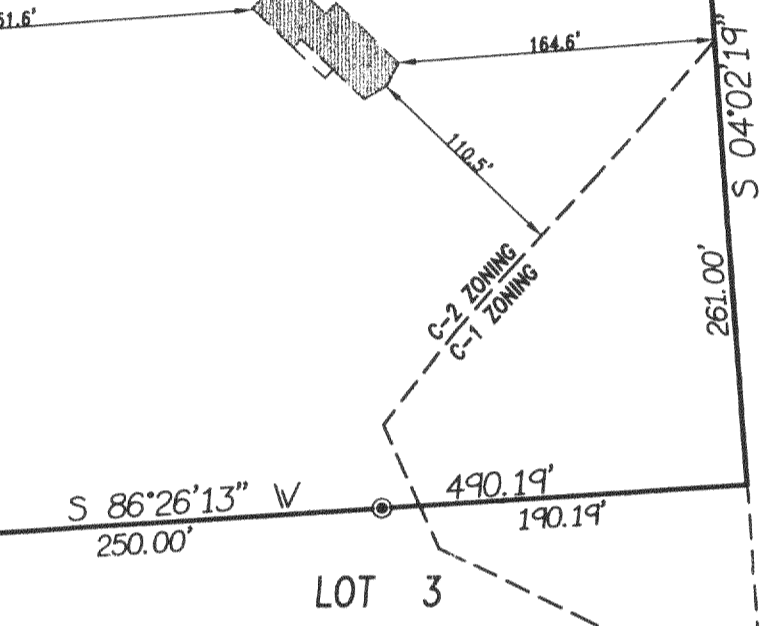


NOTE: COPIES OF THIS MAP TO WHICH THE FOLLOWING CERTIFICATE WILL APPLY ARE PRINTS SHOWING SURVEYOR'S ORIGINAL SEAL AND SIGNATURE IN RED INK. COPIES BY ANY OTHER MEANS MAY HAVE ALTERATIONS WHICH DO NOT REPRESENT THE SURVEYOR'S WORK PRODUCT.

I HEREBY CERTIFY THAT THE ABOVE DESCRIBED PROPERTY HAS BEEN SURVEYED UNDER MY DIRECTION AND THAT THE ABOVE MAP IS A TRUE REPRESENTATION THEREOF AND SHOWS THE SIZE AND LOCATION OF THE PROPERTY AND ITS EXTERIOR BOUNDARIES. THIS SURVEY IS MADE FOR THE USE OF THE PRESENT OWNERS OF THE PROPERTY, AND ALSO THOSE WHO PURCHASE, MORTGAGE, OR GUARANTEE THE TITLE THERETO WITHIN ONE YEAR FROM THE DATE HEREOF.


DATED: AUGUST 13, 1999

*Randal J. Mathwick*  
 RANDAL J. MATHWICK

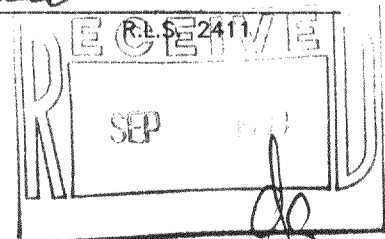

SOUTH 1/4 CORNER  
 SECT. 4-3-15

ROAD (66' WIDE)

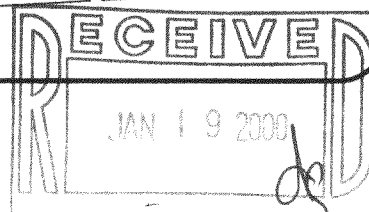

CA-2566-2  
 315-1069