



GEORGE T. DUNHAM
SURVEYING & SUBDIVIDING
DELAVER, WISCONSIN

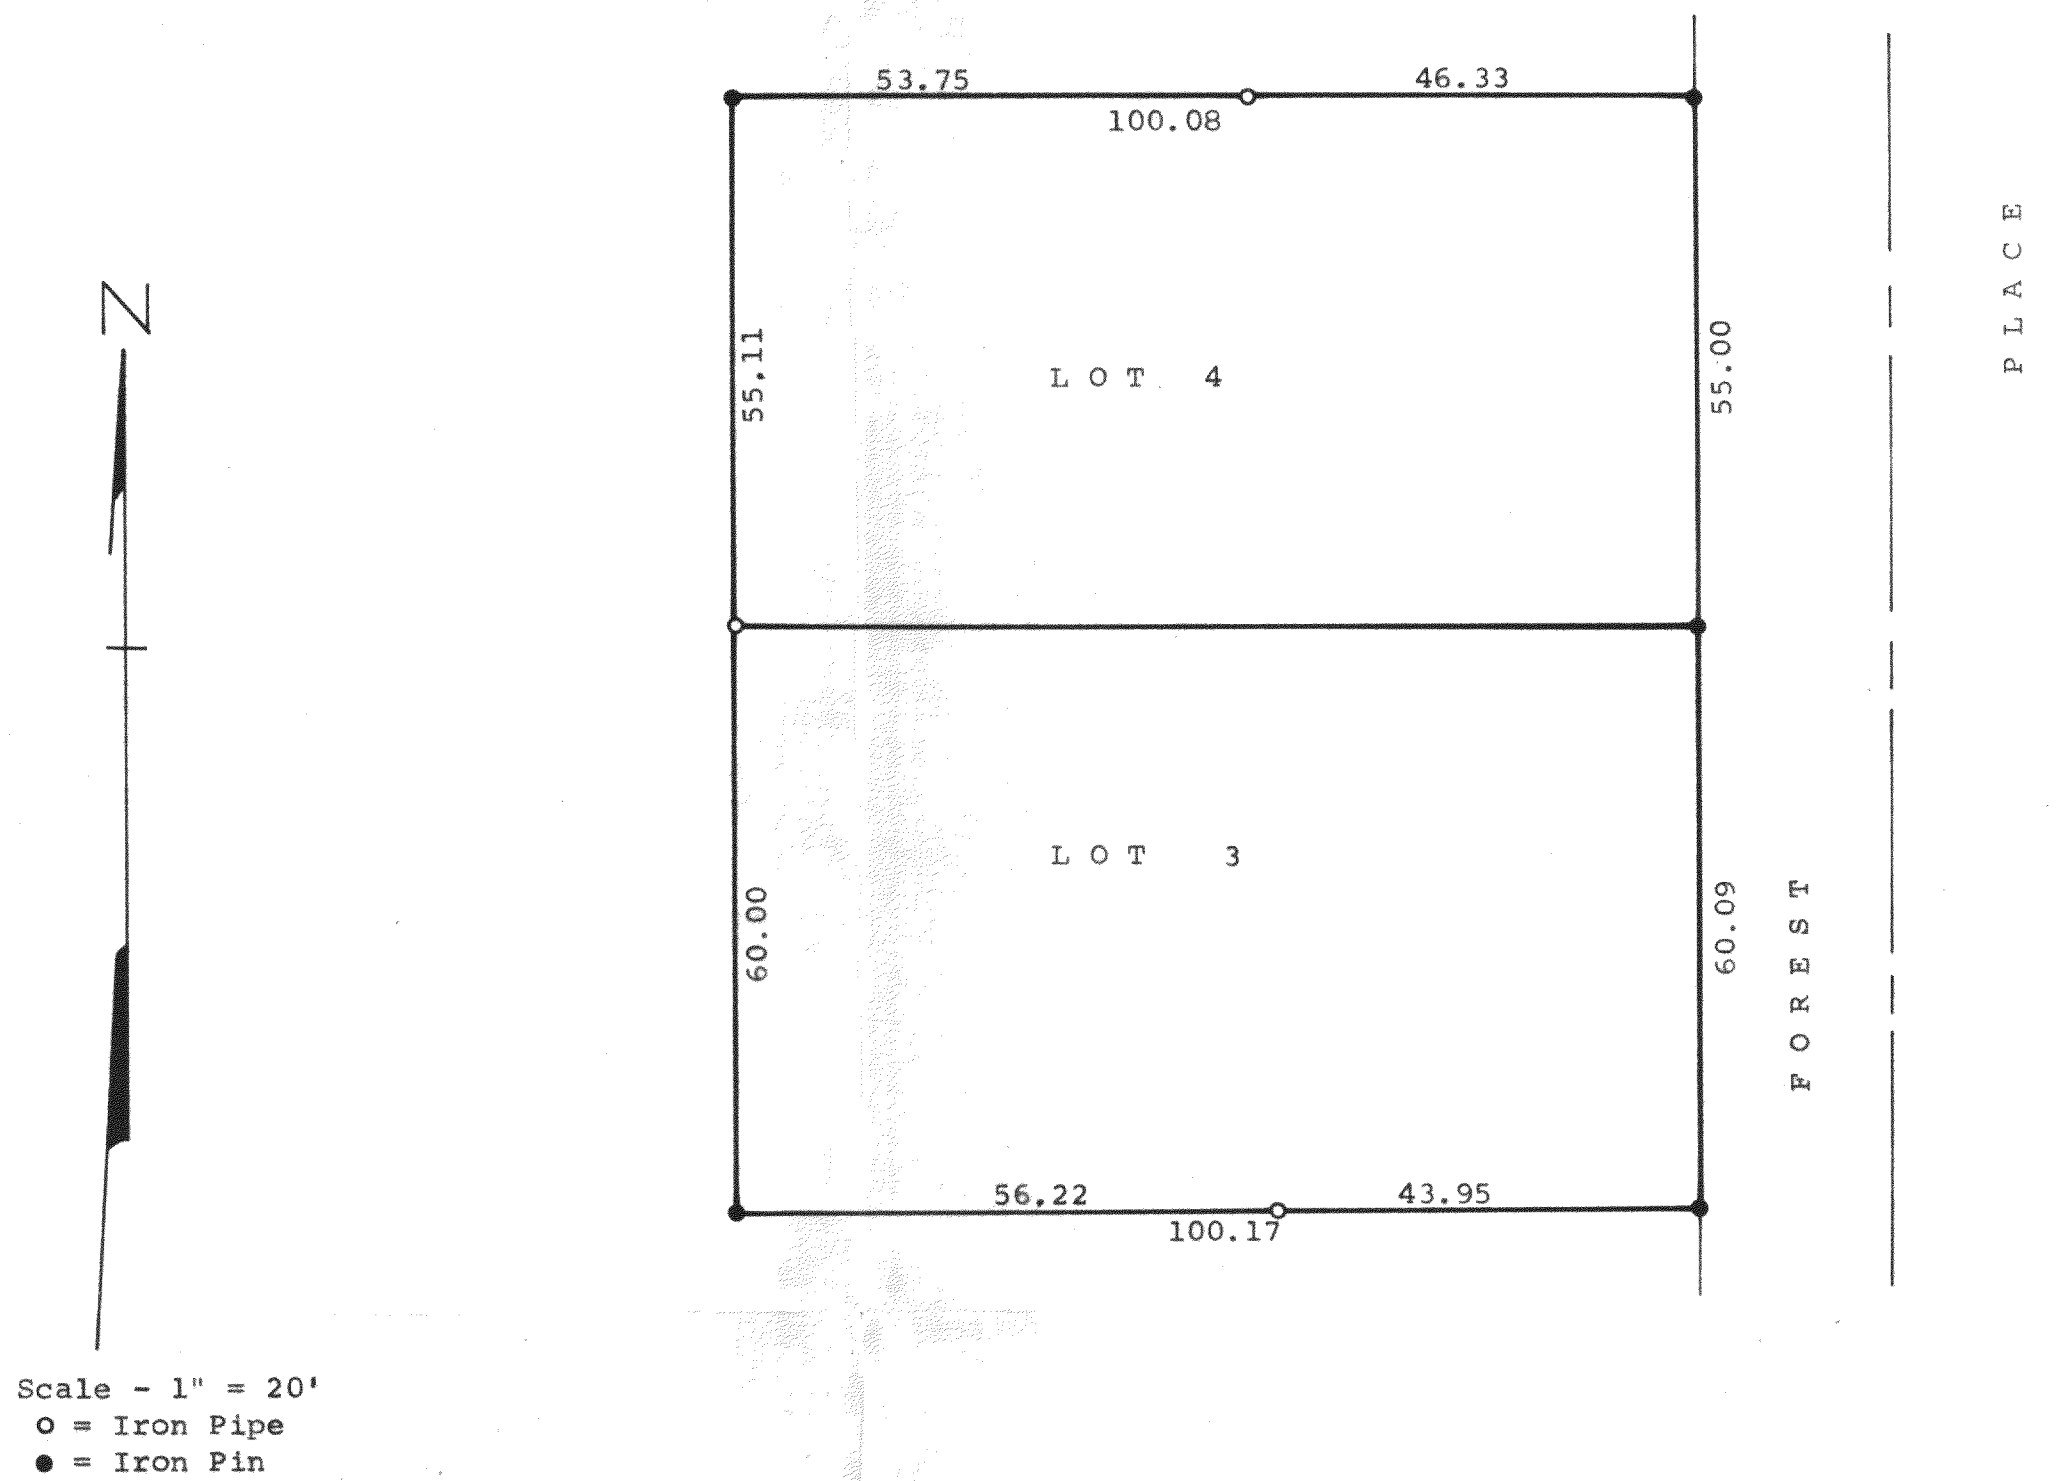

Plat of survey of Lots 3 and 4, Block "D" of Crystal Bowl,
a subdivision located in the SE $\frac{1}{4}$ of SW $\frac{1}{4}$ of Section 12 and
the NE $\frac{1}{4}$ of NW $\frac{1}{4}$ of Section 13, all in T 3 N, R 15 E, Walworth
County, Wisconsin.
April 22, 1974

George T. Dunham
George T. Dunham, Surveyor

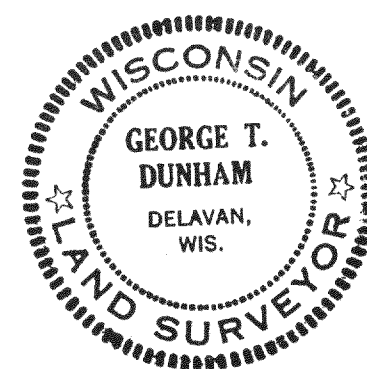

CCR-74
11-75