
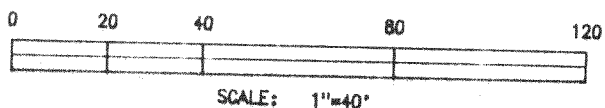


PLAT OF SURVEY

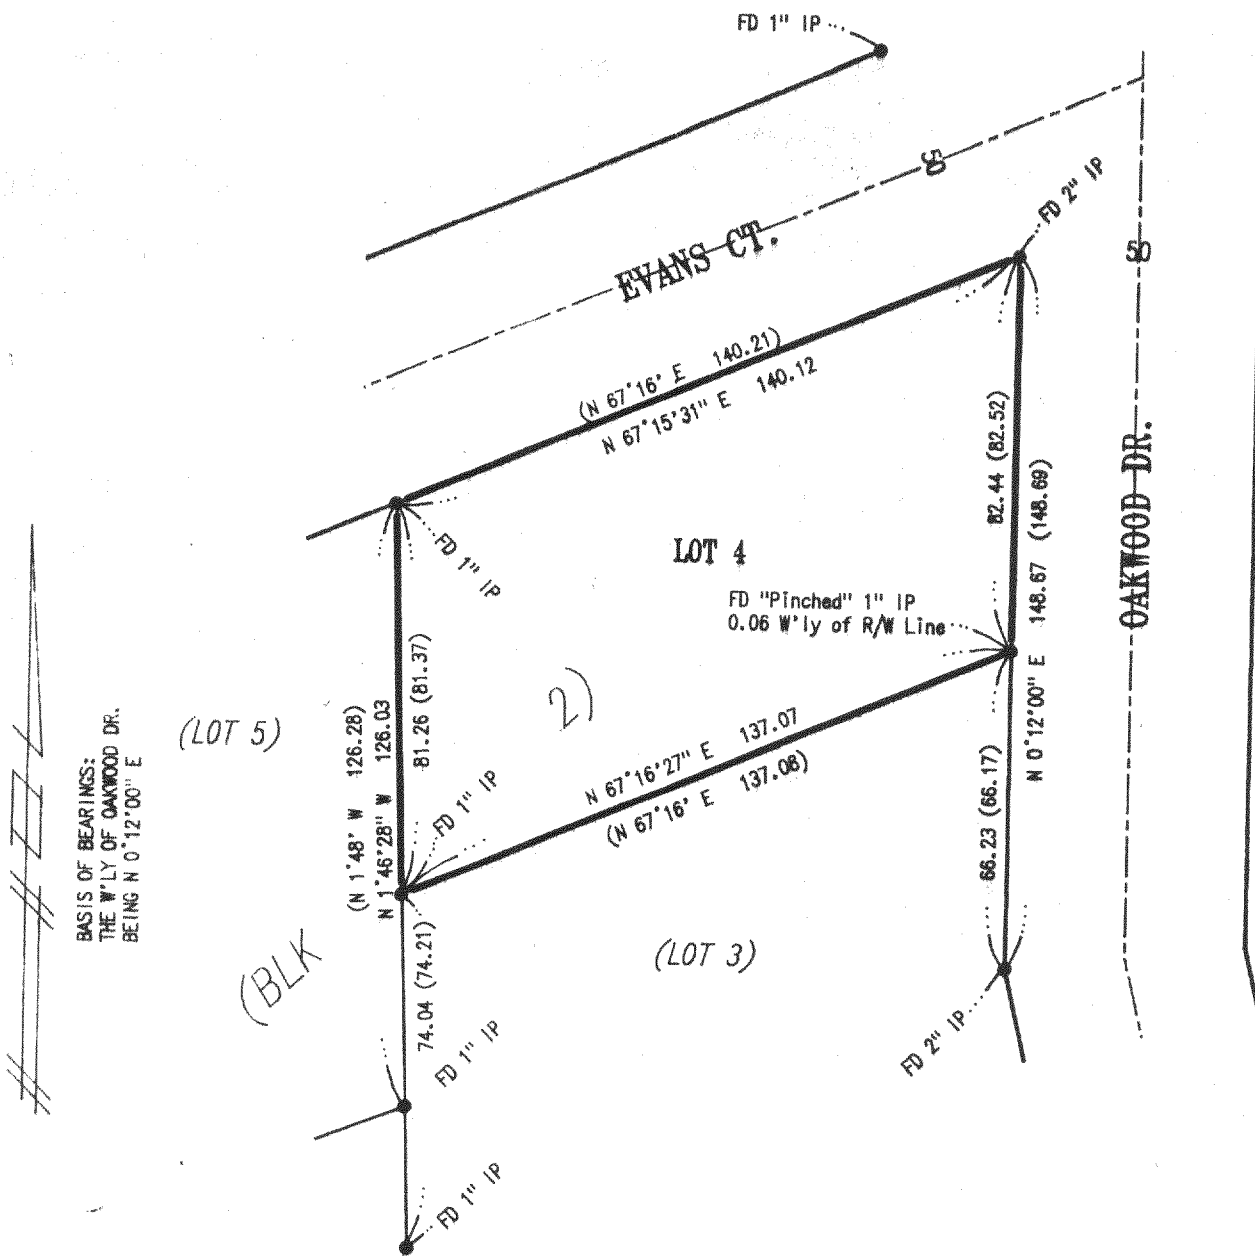

LEGAL DESCRIPTION:

IN THE SW 1/4, SE 1/4, SEC. 3, T3N, R15E
TOWN OF RICHMOND, WALWORTH CO., WI.

LOT 4, BLOCK 2, RICHMOND HEIGHTS

SURVEYOR'S CERTIFICATE



I, JAMES K. LANGONE, REGISTERED LAND SURVEYOR, CERTIFY THAT
I HAVE SURVEYED THE PROPERTY DESCRIBED HEREON AND THAT THIS
PLAT IS A TRUE AND CORRECT REPRESENTATION OF THE BOUNDARIES
THEREOF.

DATE: 6/19/99

JAMES K. LANGONE
REGISTERED LAND SURVEYOR, S-1347

NOTES:

- () — Indicates Record Data
- — Indicates Mnt. FD. as Noted

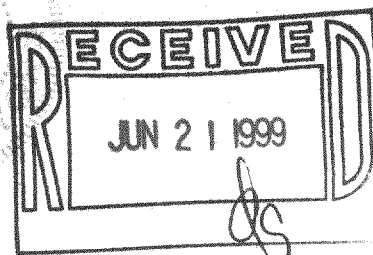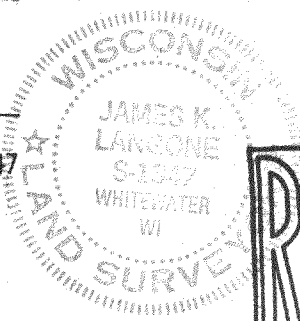

JN: 99-130
6/19/99

315-673
CRH-40