


LOTS 1,2,3 AND 4, BLOCK 20, OF SKANSEN SWEDISH TRIBUNE-NEWS SUBDIVISION located in Section 9, Town 3 North, Range15 East, Walworth County Wisconsin.

Survey address: W8716 Cherry Road

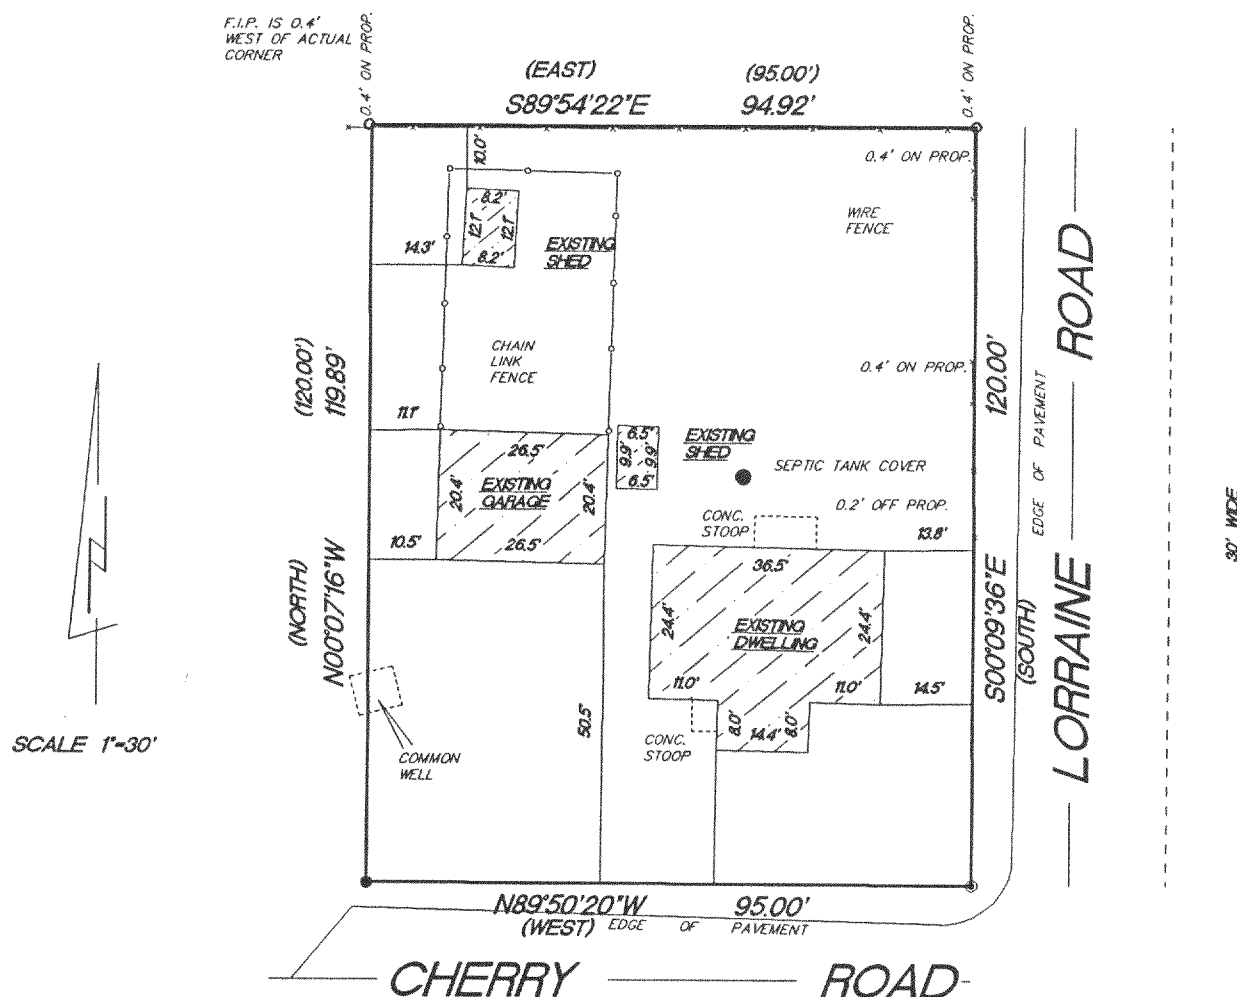

- FOUND 3/4" IRON PIPE
- SET 1" IRON PIPE
- ◎ SET SPIKE
- () RECORDED AS DIMENSIONS

"This survey is made for the use of the present owners of the property, and also those who purchase, mortgage or guarantee the title thereto within one year from date hereof."

W356 S9050 Godfrey Lane
P.O. Box 357
Eagle WI. 53119

(414) 594-3484
fax (414) 594-5904

THIS IS NOT AN ORIGINAL SURVEY UNLESS THE SEAL IS RED.

10/28/99
DATE

TEP/DW
FIELD WORK BY

TEP
DRAWN BY

99274
JOB NUMBER

CS-338

315-690