



PLAT OF SURVEY  
 LOT 1 OF CERTIFIED SURVEY MAP NO. 1504

REC. VOL. 7, PG. 98, DOC. NO. 130731

PART OF THE SE 1/4 SECTION 11  
 TOWN 3 NORTH, RANGE 18 EAST  
 WALWORTH COUNTY, WISCONSIN

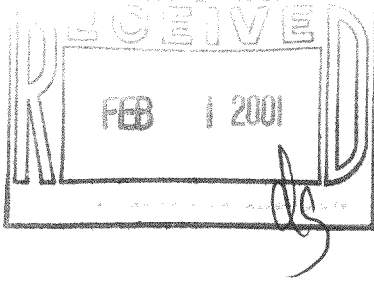

FOUND GOV'T MON.  
 TOP BROKEN OFF  
 EAST 1/4 CORNER  
 11-3-18

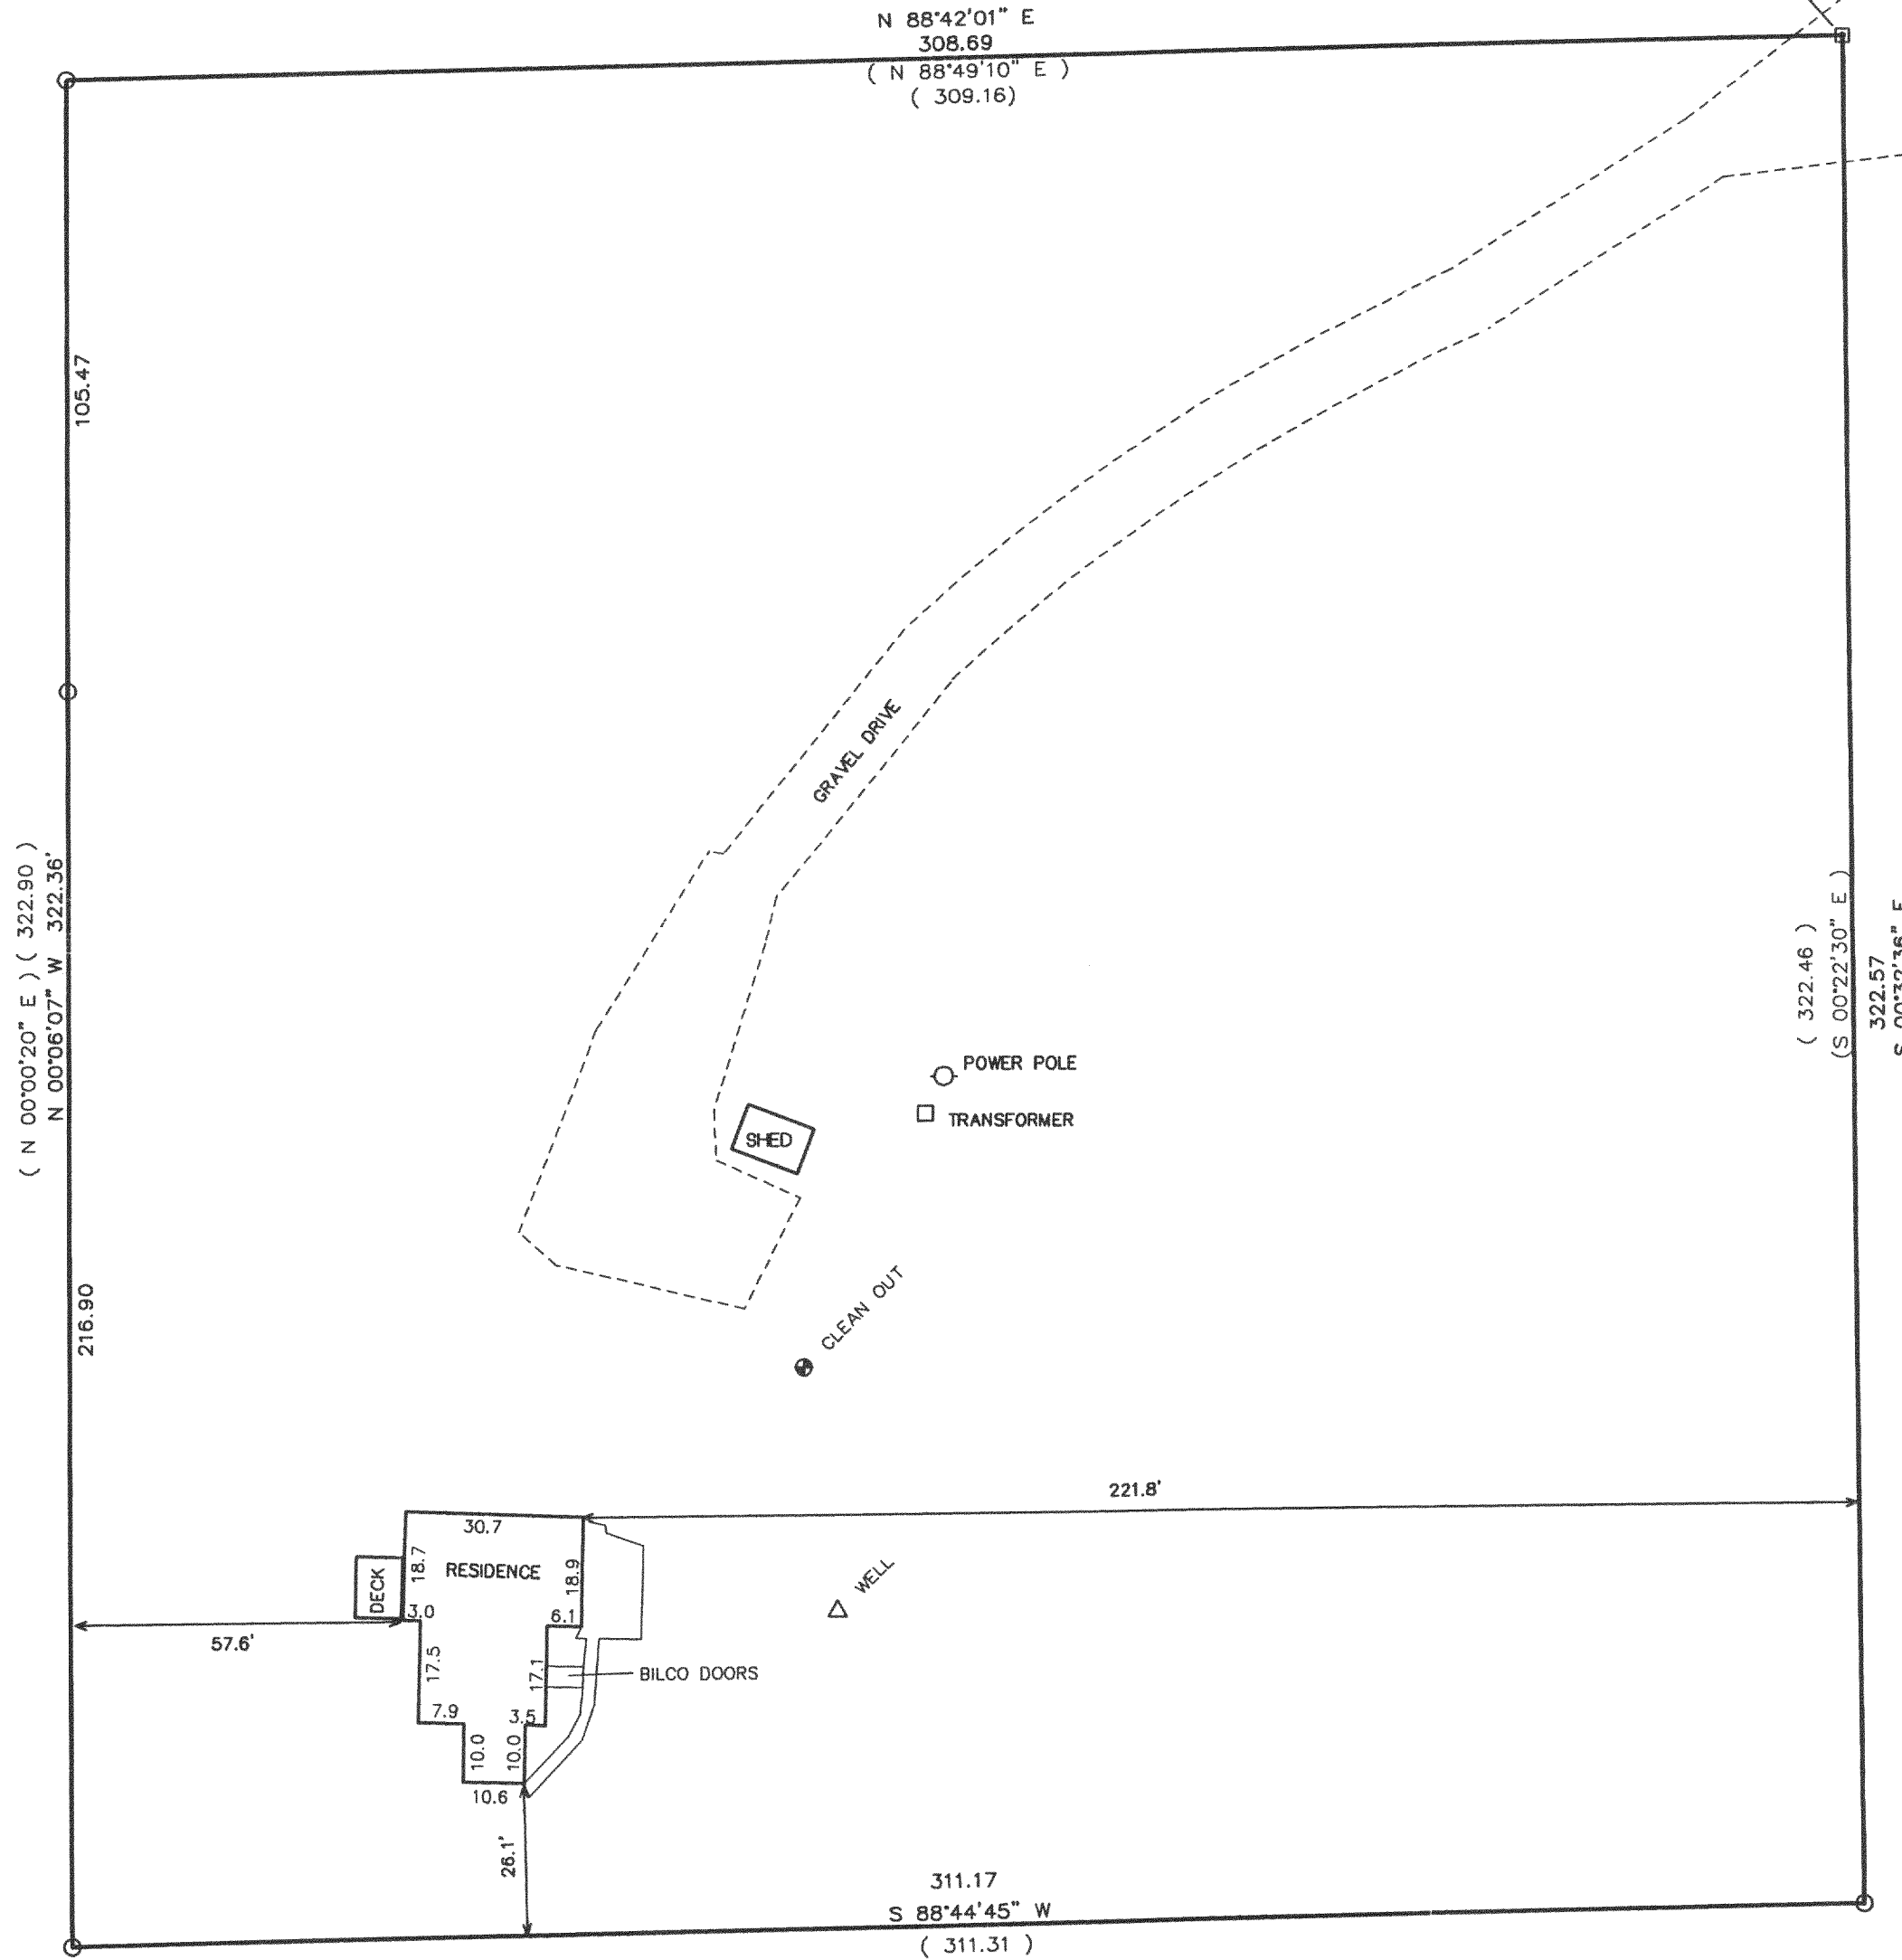

TURTLE LAKE ROAD (50' WIDE ROW)

LEGEND

- = FOUND IRON PIPE STAKE
- = FOUND CONCRETE COUNTY MONUMENT
- (xxx) = RECORDED AS

WORK ORDERED BY:  
 PAM PAUL & ASSOCIATES  
 N6568 ANDERSON DRIVE  
 DELAVAN, WI. 53115

FARRIS, HANSEN & ASSOCIATES, INC.  
 Engineering, Architecture, Surveying  
 7 Ridgeway Court P.O. Box 437  
 ELKHORN, WISCONSIN 53121  
 Office: (414) 723-2098  
 Fax: (414) 723-5886

REVISIONS


NOTE: COPIES OF THIS MAP TO WHICH THE FOLLOWING  
 CERTIFICATE WILL APPLY SHOW SURVEYOR'S ORIGINAL SEAL  
 AND SIGNATURE IN RED INK. COPIES BY ANY OTHER MEANS  
 MAY HAVE ALTERATIONS WHICH DO NOT REPRESENT THE  
 SURVEYOR'S WORK PRODUCT.

I HEREBY CERTIFY THAT THE ABOVE DESCRIBED PROPERTY HAS  
 BEEN SURVEYED UNDER MY DIRECTION AND THAT THE ABOVE MAP  
 IS A TRUE REPRESENTATION THEREOF AND SHOWS THE SIZE AND  
 LOCATION OF THE PROPERTY AND ITS EXTERIOR BOUNDARIES.  
 THIS SURVEY IS MADE FOR THE USE OF THE PRESENT OWNERS  
 OF THE PROPERTY, AND ALSO THOSE WHO PURCHASE, MORTGAGE,  
 OR GUARANTEE THE TITLE THERETO WITHIN ONE YEAR FROM THE  
 DATE HEREOF.

DATED: Nov. 20, 2000

*Peter S. Gordon*  
 PETER S. GORDON R.L.S. 2101

PROJECT NO.	5710
DATE:	11-17-00
SHEET NO.	1 OF 1

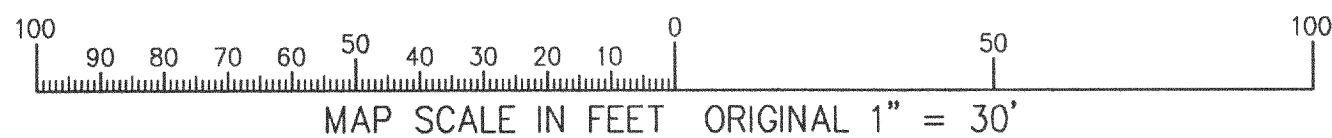

NOV 20 2000

315-727

CA-1504-1