


Kenneth B. Abernathy Jr.

Wisconsin Registered Land Surveyor S-1594

**W4056 BRAY RD.
ELKHORN, WI. 53121
PHONE: (262) 723-4260 (OFFICE)
(262) 723-7209 (FAX)
Email: abernathy@elknet.net**

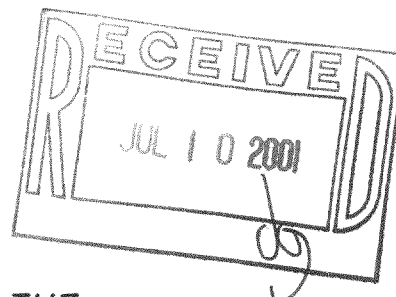

LOT 3 OF CERTIFIED SURVEY MAP NO. 2143, LOCATED IN THE
NORTHEAST 1/4 OF THE SOUTHWEST 1/4 OF SECTION 12, TOWN 3
NORTH, RANGE 15 EAST, RICHMOND TOWNSHIP, WALWORTH COUNTY,
WISCONSIN.

LOT 20
MEADOWWOOD SUBDIVISION

LOT 2

LOT 3
100,025 SQ. FT.

ORDERED BY:
SCHAUDER BUILDING, INC.
4115 HIGHWAY 51 NORTH
JANESVILLE, WISCONSIN
53545-9674

OWNERS:
ROBERT & JANET SWANSON

UNDERGROUND UTILITY BOXES —

EXISTING
RESIDENCE

-EXISTING PORCH FOUNDATION

UNDER CONSTRUCTION
2/20/2001

PROPOSED
DRIVEWAY

10' UTILITY EASEMENT.








N 89° 42' 38" E 215.70'


ANDERSON DRIVE
66' WIDE

REVISED 12-26-2000
REVISED 2-22-2001

SCALE: 1" = 60 FEET

Legend


-  FOUND IRON PIPE
 FOUND IRON ROD
 FOUND BRASS CAPPED MONUMENT
 FOUND CONCRETE MONUMENT
 CHISEL CUT IN CONCRETE
 SET IRON ROD, 24" LONG, WEIGHING 1.5 LBS./LINEAL FT., 3/4" DIA.
 SET IRON ROD, 30" LONG, WEIGHING 4.5 LBS./LINEAL FT., 1-11/16" DIA.
 (x x) RECORDED AS DIMENSION
 — x — x — EXISTING FENCE

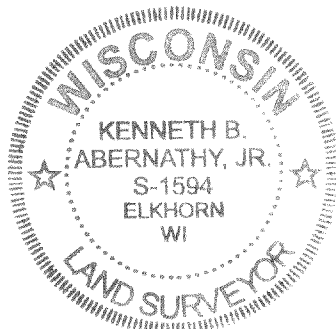

"I hereby certify that the above described property has been surveyed by me or under my direction and that the above map is a true representation thereof and shows the size and location of the property, its exterior boundaries, the location of all visible structures and dimensions of all principal buildings thereon, boundary fences, apparent easements, roadways and visible encroachments, if any."

"This survey is made for the use of the present owners of the property, and also those who purchase, mortgage, or guarantee the title thereto within one year from date hereof."

within one year from date hereof.



KENNETH B. ABERNATHY, JR.
WISCONSIN REGISTERED LAND SURVEYOR,
S-1594

Date: DEC. 7, 2000 Job No. 00.1104

DESIGN PRODUCTS 093113

CA-2143-3

315-739