

SURVEY, TOPOGRAPHIC MAPPING


LOT 1 OF CERTIFIED SURVEY MAP NO. 1094
LOCATED IN THE SW 1/4 OF THE SE 1/4 OF SECTION 11
TOWN 3 NORTH, RANGE 15 EAST
WALWORTH COUNTY, WISCONSIN

WORK ORDERED BY:
SCHAUDER HOMES
4115 US HWY 51 NORTH
JANESVILLE, WI. 53545

FARRIS, HANSEN & ASSOCIATES, INC.
Engineering, Architecture, Surveying
7 Ridgway Court P.O. Box 437
ELKHORN, WISCONSIN 53121
Office: (414) 723-2098
Fax: (414) 723-5886

REVISIONS

PROJECT NO.
4900
DATE
12-31-97
SHEET NO.
1 OF 1

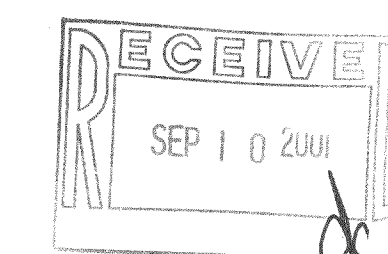

- = FOUND IRON PIPE STAKE
- = FOUND IRON REBAR STAKE
- (xxx) = RECORDED AS
- VERTICAL DATUM
TOP OF IRON PIPE STAKE NW SIDE HOLIDAY DRIVE
EL. = 100' PER CSM 1094
- = SOIL TEST AS LOCATED ON SOILS REPORT BY MARVIN HOMBURG DATED 09-23-1991

NOTE: COPIES OF THIS MAP TO WHICH THE FOLLOWING
CERTIFICATE WILL APPLY SHOW SURVEYOR'S ORIGINAL SEAL AND
SIGNATURE IN RED INK. COPIES BY ANY OTHER MEANS MAY HAVE
ALTERATIONS WHICH DO NOT REPRESENT THE SURVEYOR'S WORK
PRODUCT.


I HEREBY CERTIFY THAT THE ABOVE DESCRIBED PROPERTY HAS
BEEN SURVEYED UNDER MY DIRECTION AND THAT THE ABOVE MAP
IS A TRUE REPRESENTATION THEREOF AND SHOWS THE SIZE AND
LOCATION OF THE PROPERTY AND ITS EXTERIOR BOUNDARIES.
THIS SURVEY IS MADE FOR THE USE OF THE PRESENT OWNERS OF
THE PROPERTY, AND ALSO THOSE WHO PURCHASE, MORTGAGE, OR
GUARANTEE THE TITLE THEREIN WITHIN ONE YEAR FROM THE DATE
HEREOF.

DATED: 01-14-1998

Peter S. Gordon
PETER S. GORDON R.L.S. 2101

REVISED 03-27-2001
TO SHOW PROPOSED RESIDENCE LOCATION
REVISED 04-17-2001
REVISED 07-04-2001 TO SHOW SIZE & LOCATION OF FOUNDATION AS BUILT

10 5 0 10 20 30 40 50 60 70 80 90 100
MAP SCALE IN FEET ORIGINAL 1" = 20'

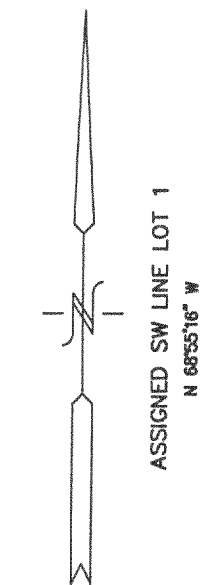

SOURCE BENCH MARK

HOLIDAY DRIVE

TURTLE LAKE
ICE ELEVATION = 68' ON DATE OF TOPO

BENCH MARK
TOP OF 2" DIA IRON PIPE
EL. = 77.31'

BENCH MARK
TOP OF IRON REBAR STAKE
EL. = 92.10'

315-750