

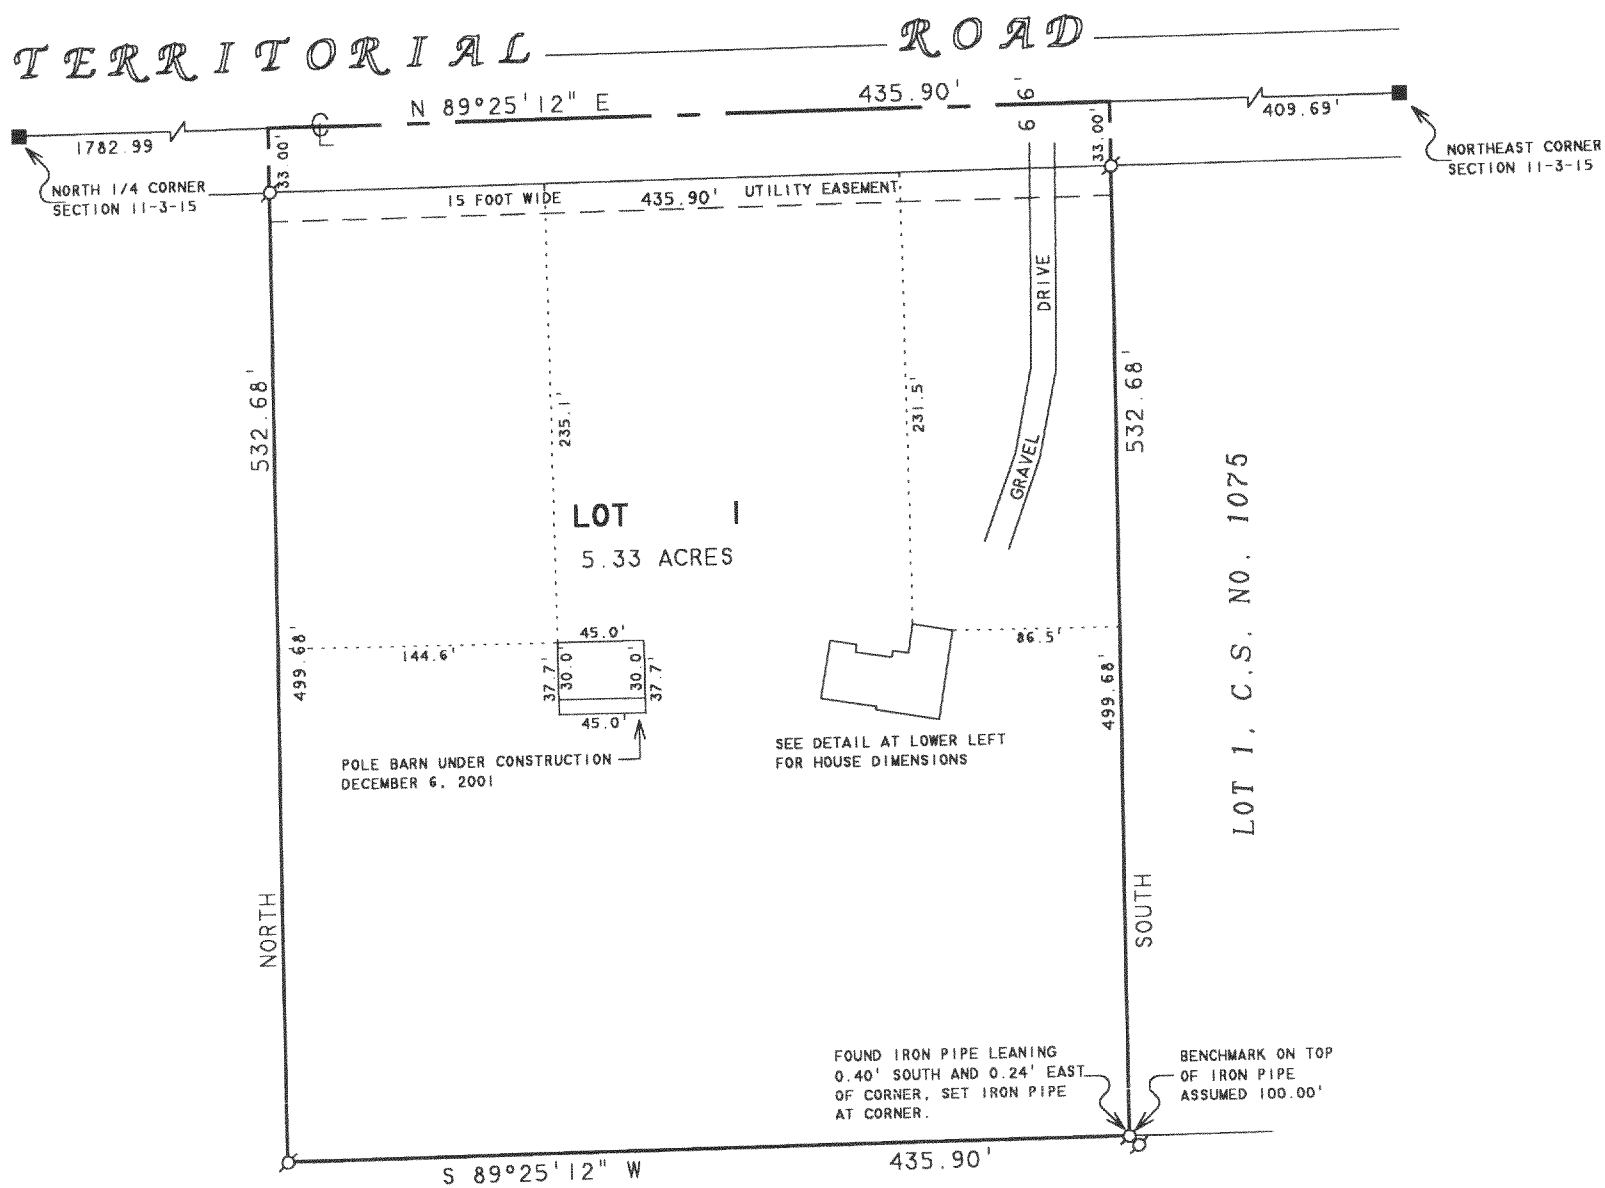


ABELL
SURVEYING & MAPPING

1140 SEQUOIA STREET • DELAVAN, WISCONSIN 53115
262-728-6737

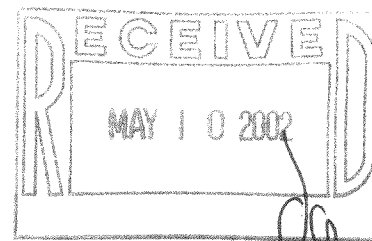

DETAIL SCALE - 1"=30'

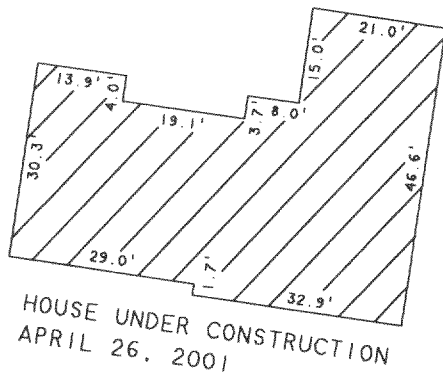

PLAT OF SURVEY OF

LOT 1, CERTIFIED SURVEY MAP NO. 3294, LOCATED IN
THE NORTHEAST 1/4 OF THE NORTHEAST 1/4 OF SECTION
11, T3N.R15E, WALWORTH COUNTY, WISCONSIN.

ORDERED BY: GINGER HAMMERSTAD
W7864 COUNTY ROAD A
DELAVAN, WI 53115

NOTE: BEARINGS ARE REFERENCED TO
CERTIFIED SURVEY MAP NO. 3294.

N



SCALE 1"=100'

LEGEND

○ - IRON PIPE FOUND
■ - WALWORTH COUNTY MONUMENT

REVISED: DECEMBER 7, 2001 TO SHOW
THE POLE BARN UNDER
CONSTRUCTION.

ORDERED BY: GINGER HAMMERSTAD
W7733 TERRITORIAL RD.
DELAVAN, WI 53115

I, DAVID F. ABELL, DO HEREBY CERTIFY THAT I HAVE SURVEYED THE PROPERTY HEREON
DESCRIBED ACCORDING TO THE OFFICAL RECORDS AND THAT THE PLAT HEREON IS A
CORRECT REPRESENTATION OF THE PROPERTY LINES TO THE BEST OF MY KNOWLEDGE AND
BELIEF.

David F. Abell

DAVID F. ABELL
WISCONSIN REGISTERED LAND SURVEYOR, S-1596

April 26, 2001

DATE JOB NUMBER - 00095C
NOTE: THIS IS NOT A CERTIFIED COPY UNLESS SEALED.

315-771