

# PLAT OF SURVEY

J.K. SURVEYING INC.  
 13705 WILLOWBEND LANE  
 LAKE GENEVA, WI, 53147  
 262-248-3697

-OF-

LOT 2 OF CERTIFIED SURVEY MAP NO. 2060, BEING A PART OF THE NORTHWEST 1/4 OF THE NORTHWEST 1/4 OF SECTION 21,  
 TOWN 3 NORTH, RANGE 15 EAST, TOWN OF RICHMOND, WALWORTH COUNTY, WISCONSIN.

ORDERED BY:  
 PAT & DIANNE SHOWALTER  
 CENTURY 21 SKANDIA REALTY  
 DELAVAN WI



- ( ) = recorded as
- = found iron bar
- = found iron pipe
- = set iron pipe
- = set iron bar

SCALE " = 50'

JOB # 02-272



TAX KEY # CA-2060-2

COMPARE LEGAL DESCRIPTION ABOVE AND DRAWING WITH DEED. FOR BUILDING RESTRICTIONS AND EASEMENTS NOT SHOWN, REFER TO DEED, ABSTRACT SOURCES AND LOCAL MUNICIPAL CODES. NOTIFY THE SURVEYOR IMMEDIATELY OF ANY DISCREPANCY.

"I hereby certify that I have surveyed the above described property and that the above map is a true representation thereof and shows the size and location of all visible structures, apparent easements and encroachments if any."

This survey is made for the present owners of the property, and those who purchase, mortgage, or guarantee the title thereto, within one year from the date hereof.

DATED THIS 6 TH, DAY OF JUNE, 2002.

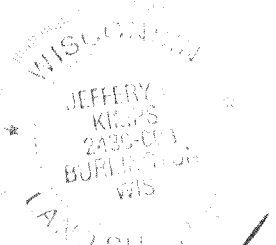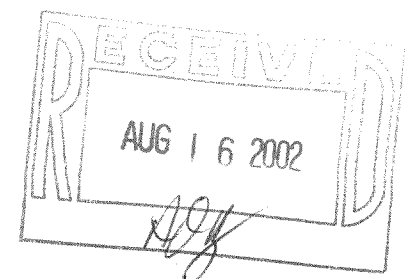

JEFFREY L. KIMPS S-2436  
 Wisconsin Registered Land Surveyor  
 (original if signed in red)