


ABELL  
SURVEYING & MAPPING

1140 SEQUOIA STREET • DELAVAN, WISCONSIN 53115  
262-728-6737

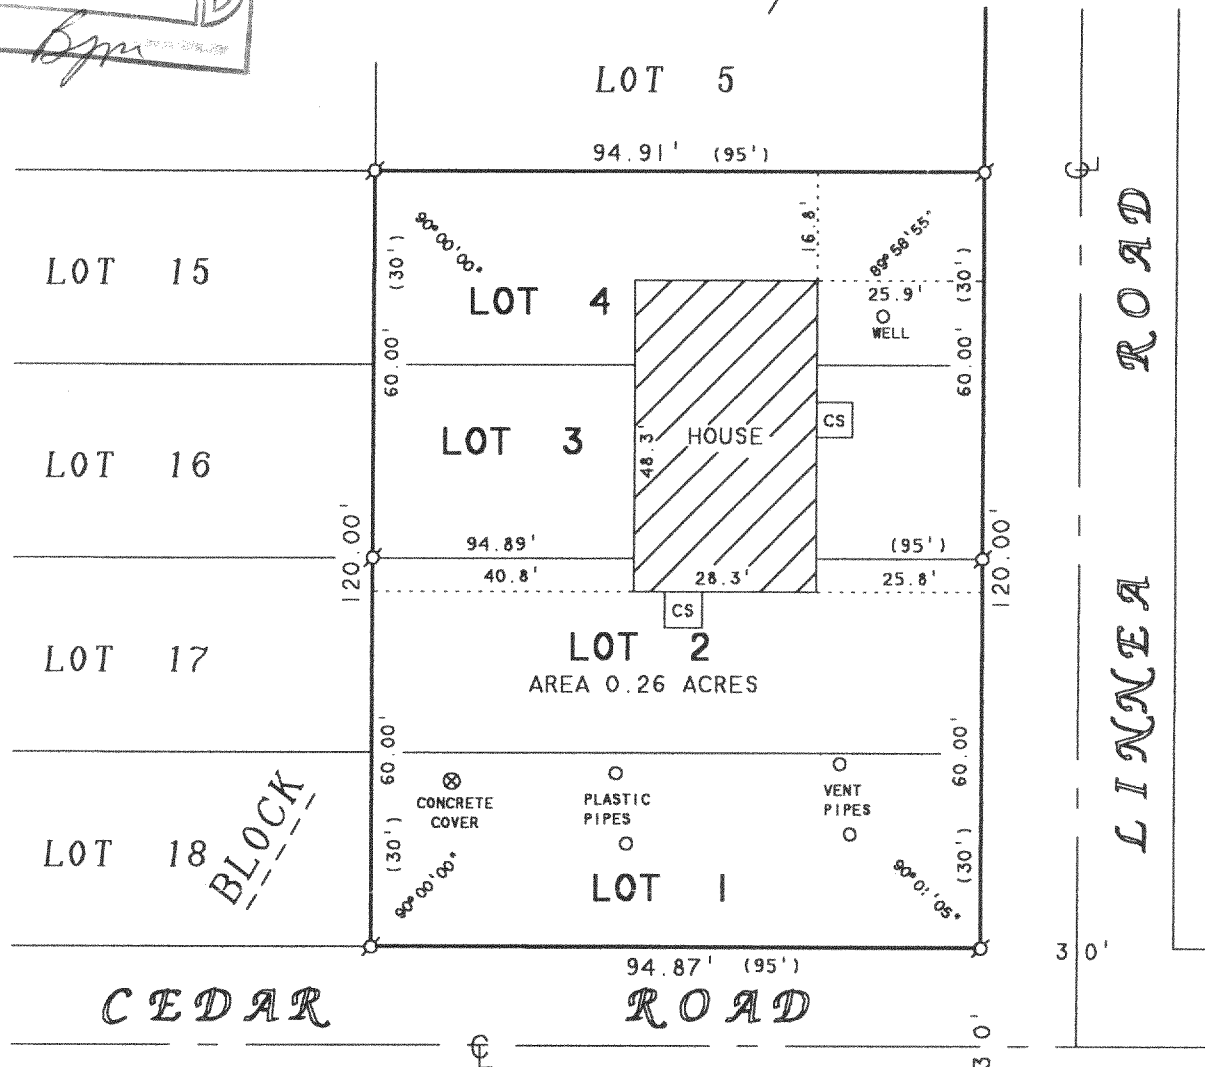

REVISED: JULY 8, 2002 TO SHOW  
HOUSE LOCATION.

REVISED: MAY 13, 2002 TO SHOW NEW  
PROPOSED HOUSE LOCATION.

REVISED DATE: MAY 1, 2002  
REVISED TO SHOW NEW PROPOSED  
HOUSE LOCATION.

ORDERED BY: TAGGART REAL ESTATE  
797 WELLS STREET  
LAKE GENEVA, WI 53147

PLAT OF SURVEY OF

LOTS 1-4, BLOCK 7, SKANSEN SWEDISH TRIBUNE NEWS  
SUBDIVISION, LOCATED IN T3N, R15E, WALWORTH  
COUNTY, WISCONSIN.

N



SCALE 1"=30'

LEGEND

Ø - IRON PIPE FOUND  
CS - CONCRETE STOOP  
( ) - RECORDED AS

I HEREBY CERTIFY THAT I HAVE SURVEYED THE ABOVE DESCRIBED PROPERTY AND THAT THE  
ABOVE MAP IS A TRUE REPRESENTATION THEREOF AND SHOWS THE SIZE AND LOCATION OF  
THE PROPERTY, ITS EXTERIOR BOUNDARIES, THE LOCATION OF ALL VISIBLE STRUCTURES  
AND DIMENSIONS OF ALL PRINCIPAL BUILDINGS THEREON, BOUNDARY FENCES, APPARENT  
EASEMENTS, ROADWAYS AND VISIBLE ENCROACHMENTS, IF ANY, TO THE BEST OF MY  
KNOWLEDGE AND BELIEF.

THIS SURVEY IS MADE FOR THE USE OF THE PRESENT OWNERS OF THE PROPERTY, AND ALSO  
THOSE WHO PURCHASE, MORTGAGE, OR GUARANTEE THE TITLE THERETO WITHIN ONE (1) YEAR  
FROM DATE HEREON.

*David F. Abell*

DAVID F. ABELL  
WISCONSIN REGISTERED LAND SURVEYOR, S-1596

April 15, 2002

DATE: April 15, 2002 JOB NUMBER - 92020E  
NOTE: THIS IS NOT A CERTIFIED COPY UNLESS SEALED.

CS 118

315-781