ABELL SURVEYING & MAPPING


1140 SEQUOIA STREET . DELAVAN, WISCONSIN 53115 262-728-6737

AUG 2 6 2002

国の国IV

Mm

SHORE TERRACE WOOD

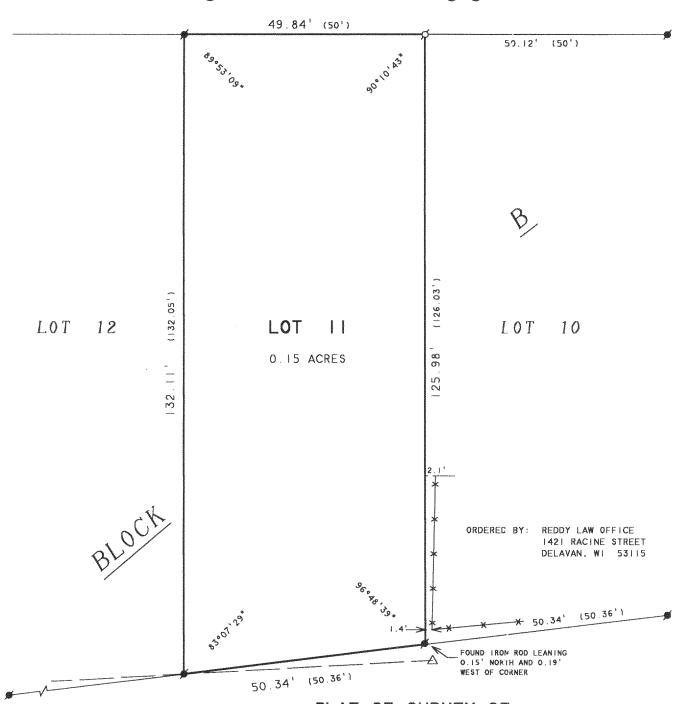

PLAT OF SURVEY OF

LOT II, BLOCK B OF CRYSTAL BOWL SUBDIVISION. LOCATED IN T3N, RISE, WALWORTH COUNTY, WISCONSIN.

I HEREBY CERTIFY THAT I HAVE SURVEYED THE ABOVE DESCRIBED PROPERTY AND THAT THE ABOVE MAP IS A TRUE REPRESENTATION THEREOF AND SHOWS THE SIZE AND LOCATION OF THE PROPERTY, ITS EXTERIOR BOUNDARIES, THE LOCATION OF ALL VISIBLE STRUCTURES AND DIMENSIONS OF ALL PRINCIPAL BUILDINGS THEREON, BOUNDARY FENCES, APPARENT EASEMENTS, ROADWAYS AND VISIBLE ENCROACHMENTS, IF ANY, TO THE BEST OF MY KNOWLEDGE AND BELIEF.



SCALE | " = 20 '

LEGEND

- IRON ROD FOUND

Ø - IRON PIPE FOUND Δ - UTILITY POLE OVERHEAD UTILITY LINES

-X- - WOOD FENCE ()- RECORDED AS THIS SURVEY IS MADE FOR THE USE OF THE PRESENT OWNERS OF THE PROPERTY, AND ALSO THOSE WHO PURCHASE, MORTGAGE, OR GUARANTEE THE TITLE THERETO WITHIN ONE (I) YEAR FROM DATE HEREON.

DAVID F. ABELL WISCONSIN REGISTERED LAND SURVEYOR, S-1596

DATE JOB NUMBER - NOTE: THIS IS NOT A CERTIFIED COPY UNLESS SEALED.