

FARRIS, HANSEN & ASSOCIATES, INC.


ENGINEERING — ARCHITECTURE — SURVEYING
7 RIDGWAY COURT — P.O. BOX 437 — ELKHORN, WISCONSIN 53121
PHONE: (262) 723-2098 FAX: (262) 723-5886

— WORK ORDERED BY —
RICHARD GRANSEE
6126 N. LITTLE PAPOOSE DRIVE
PRESCOTT VALLEY, AZ 86314



PLAT OF SURVEY

C.S.M. 158
RECORDED AS DOC. NO. 652566
LOCATED IN THE SW 1/4 22-3-15
WALWORTH COUNTY, WISCONSIN

LEGEND
○ = FOUND IRON PIPE STAKE
(XXX) = RECORDED AS

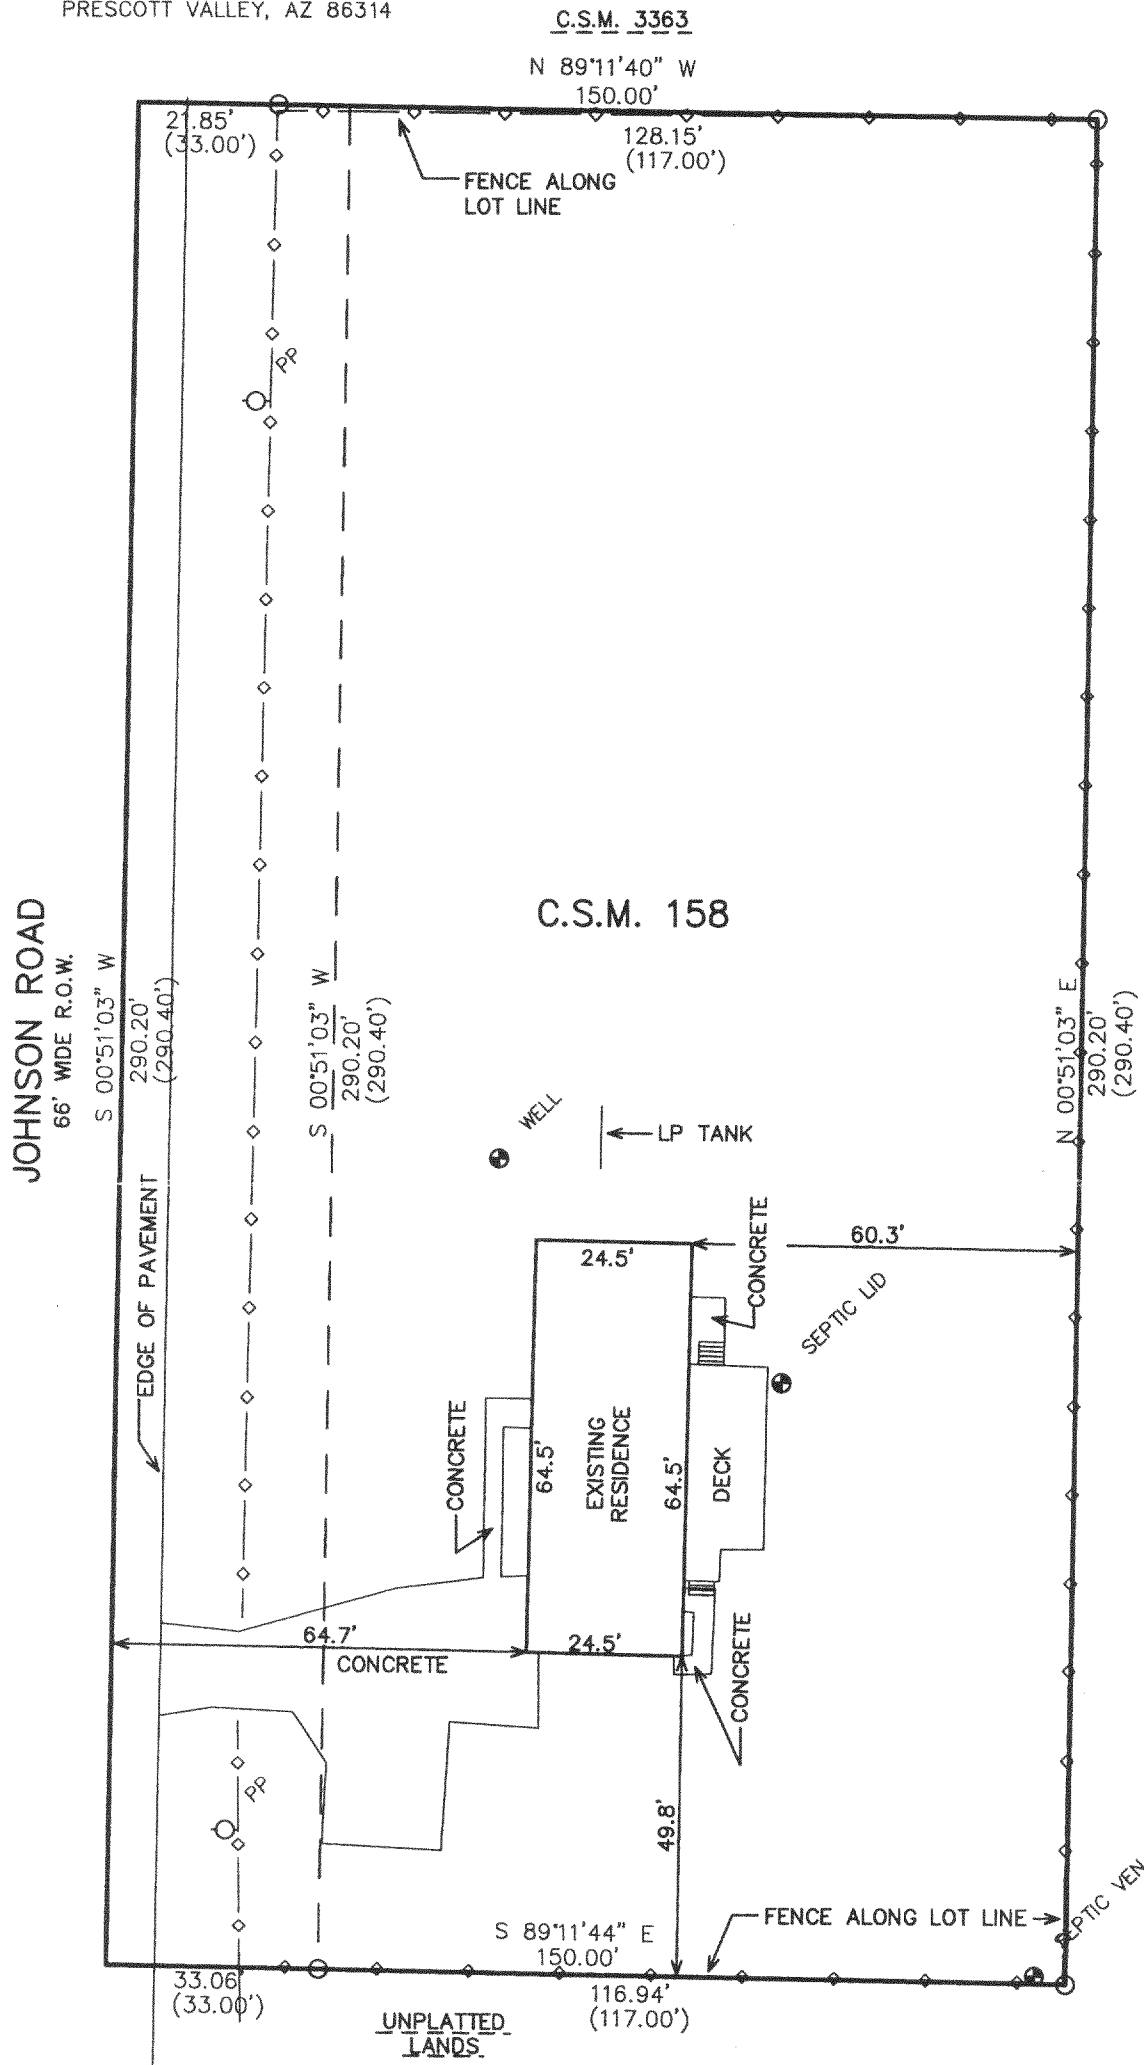

UNPLATTED
LANDS

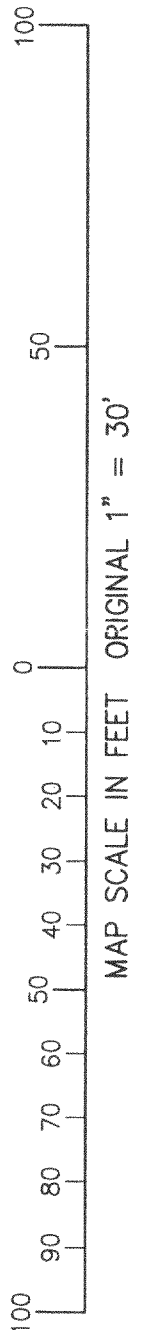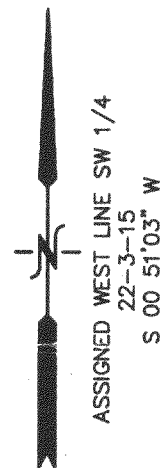


NOTE: COPIES OF THIS MAP TO WHICH THE FOLLOWING CERTIFICATE
WILL APPLY SHOW THE SURVEYOR'S ORIGINAL SEAL AND SIGNATURE
IN RED INK. COPIES BY ANY OTHER MEANS MAY HAVE ALTERATIONS
WHICH DO NOT REPRESENT THE SURVEYOR'S WORK PRODUCT.

I HEREBY CERTIFY THAT THE ABOVE DESCRIBED PROPERTY HAS BEEN
SURVEYED UNDER MY DIRECTION AND THAT THE ABOVE MAP IS A TRUE
REPRESENTATION THEREOF AND SHOWS THE SIZE AND LOCATION OF
THE PROPERTY AND ITS EXTERIOR BOUNDARIES. THIS SURVEY IS
MADE FOR THE USE OF THE PRESENT OWNERS OF THE PROPERTY, AND
ALSO THOSE WHO PURCHASE, MORTGAGE, OR GUARANTEE THE TITLE
THERE TO WITHIN ONE YEAR FROM THE DATE HEREOF.

DATED: 10/24/02

PETER S. GORDON R.L.S. 2101

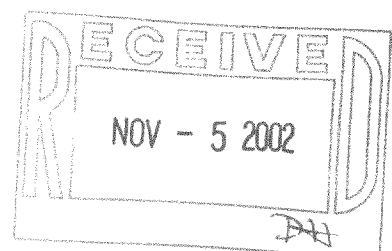

PROJECT: 5777.02
DATE: 10/24/02
SHEET 1 OF 1

CA 158-1

315-795