

1140 SEQUOIA STREET • DELAVAN, WISCONSIN 53115
262-728-6737


NOTE: BEARINGS ARE REFERENCED TO
EXISTING SURVEY RECORDS.



SCALE 1" = 20'

LEGEND

- ♂ - IRON PIPE FOUND
- - CONCRETE MONUMENT FOUND WITH POSEY PIN
- - 1" DIA. IRON PIPE SET
- ⌘ - 10" SPIKE SET AT BASE OF SMALL UTILITY PED
- ⚡ - IRON ROD FOUND
- - UTILITY PED
- BE - BASEMENT ENTRY
- () - RECORDED AS

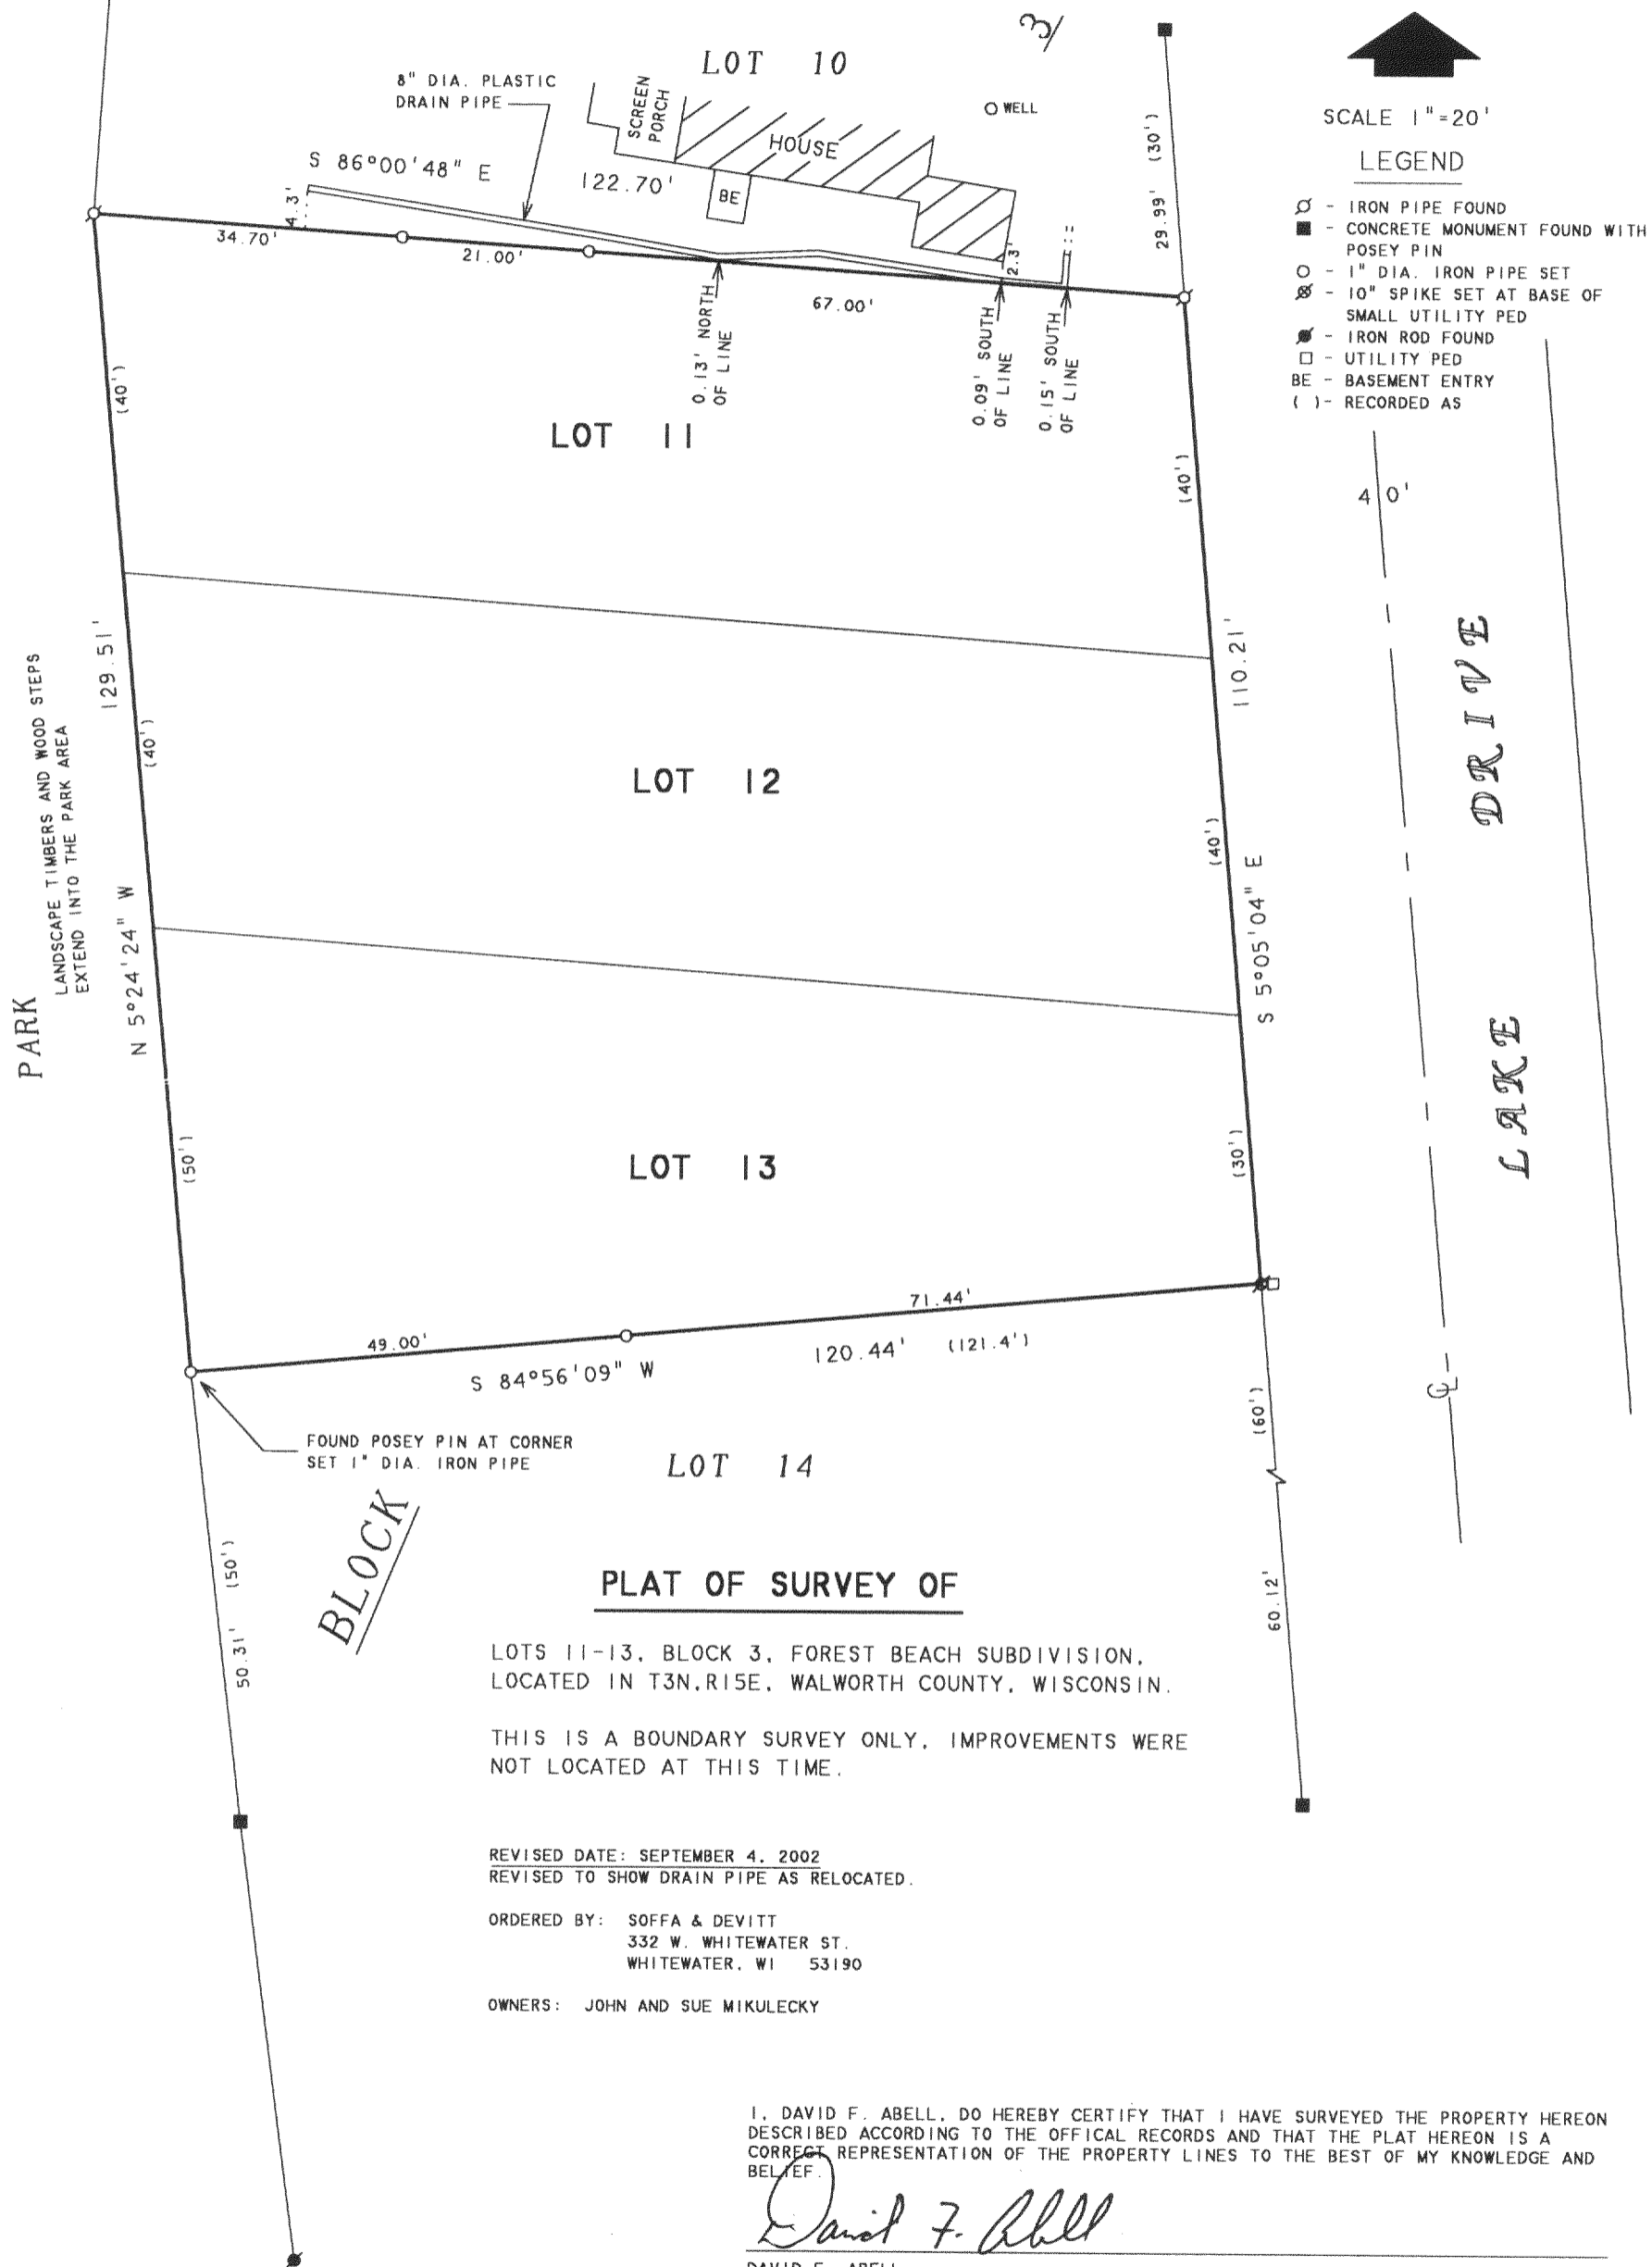

I, DAVID F. ABELL, DO HEREBY CERTIFY THAT I HAVE SURVEYED THE PROPERTY HEREON DESCRIBED ACCORDING TO THE OFFICAL RECORDS AND THAT THE PLAT HEREON IS A CORRECT REPRESENTATION OF THE PROPERTY LINES TO THE BEST OF MY KNOWLEDGE AND BELIEF

DAVID F. ABELL
WISCONSIN REGISTERED LAND SURVEYOR, S-1596

May 14, 2002

DATE _____ JOB NUMBER - 02059A

NOTE: THIS IS NOT A CERTIFIED COPY UNLESS SEALED.

NOV 12 2002

✓ CFB-16B 315-796