
GEORGE T. DUNHAM SURVEYING & SUBDIVIDING DELAVAN, WISCONSIN

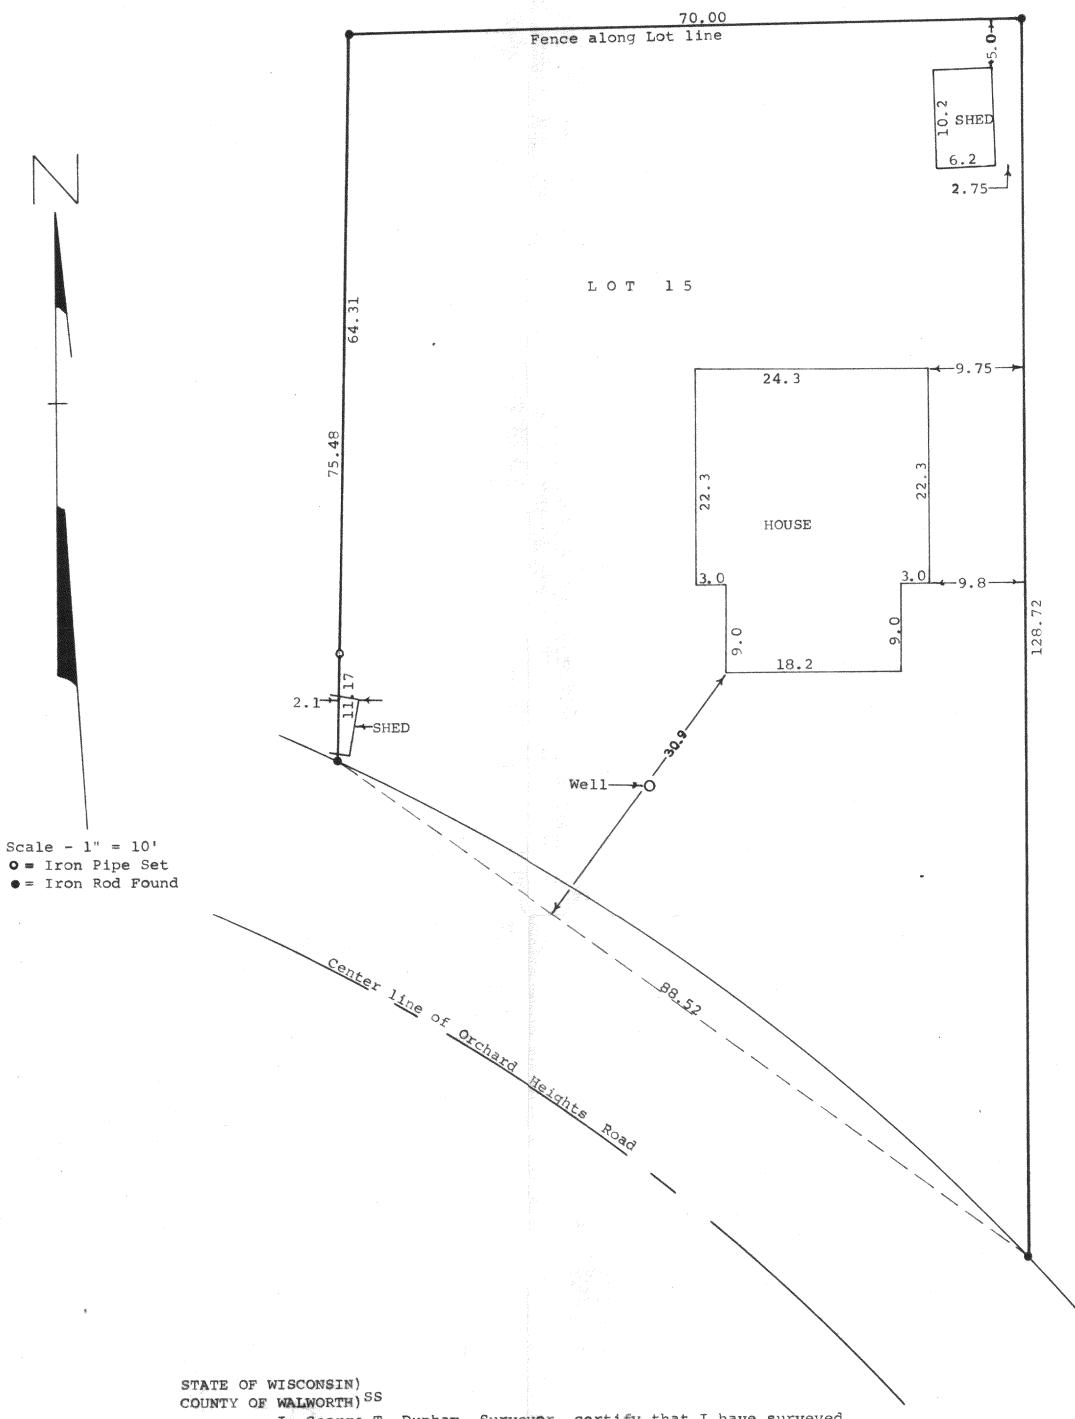

I, George T. Dunham, Surveyor, certify that I have surveyed

the property described as follows, Lot 15, Block "D" of Crystal Bowl, a subdivision located in Section 12, T 3 N, R 15 E, Walworth County, Wisconsin, and the above map is a true representation thereof and shows the size and location of the property, its exterior boundaries, the location and dimensions of all structures thereon, fences, apparent easements and roadways

and visible encroachments, if any. This survey is made for the exclusive use of the present owners of the property, and also those who purchase, mortgage, or guarantee the title thereto within one (1) year from date hereof; and as to them I warrant the accuracy of said survey and map.

October 16, 1975

