
DUNHAM SURVEYING, S.C. SURVEYING & SUBDIVIDING DELAVAN, WISCONSIN 53115

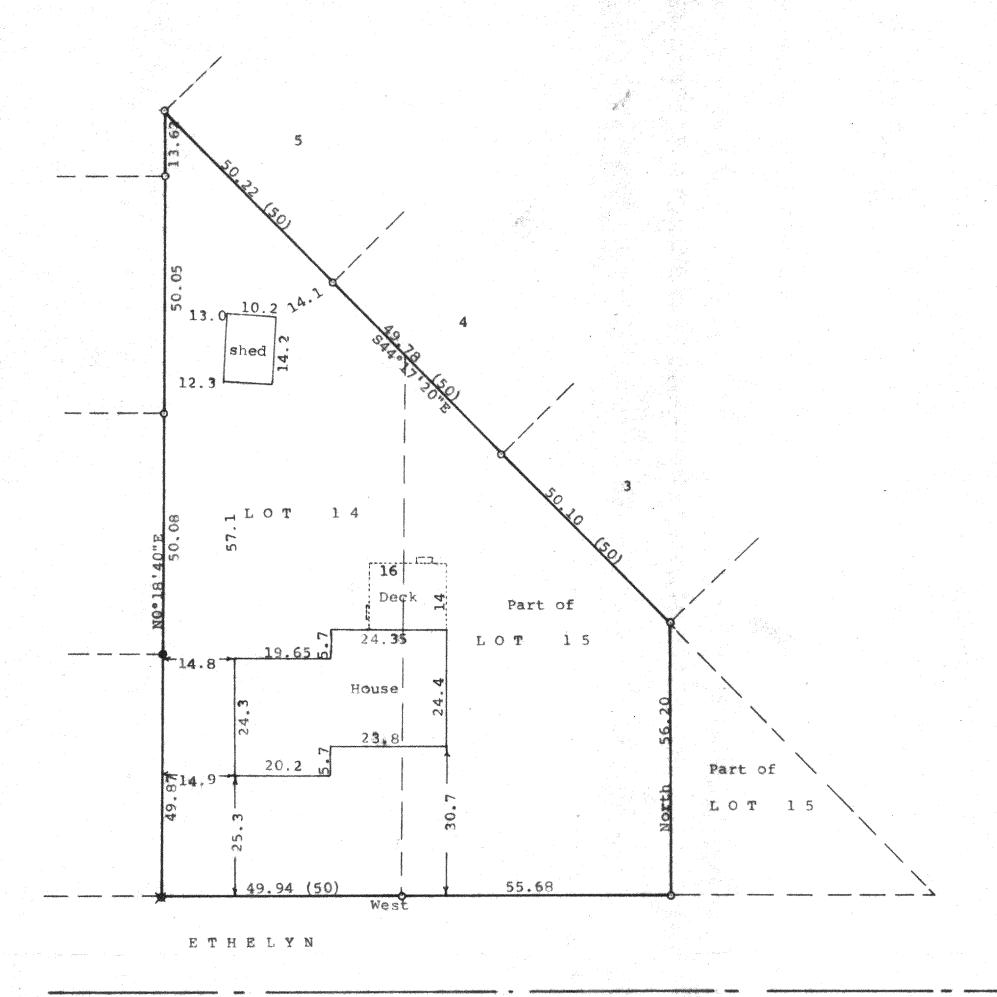

Scale - 1" = 20'

0 = 5" Iron Rod Found

(0.00) = recorded distance

Survey ordered by: Harold Murphy

525 Turtle Creek Drive

Delavan, WI 53115

Bearings referenced to the north line of

Bearings referenced to the north line of Ethelyn Drive with the assumed bearing of West.

• = 3/4" Iron Pipe Set

m = 60 penny spike set in RR Tie

DRIVE

STATE OF WISCONSIN) SS

COUNTY OF WALWORTH)

I, George T. Dunham, Surveyor, certify that I have surveyed the property described as follows:

Lot 14 and a part of Lot 15 in Block "H" of Crystal Bowl Subdivision located in Sections 12 and 13, T 3 N, R 15 E, Walworth County, Wisconsin, the entire parcel is described as follows: Beginning at the southwest corner of said Lot 14; thence N0°18'40"E along the west line of said Lot 14, 163.62 feet to the northwest corner of said Lot 14; thence S44°17'20"E along the northeasterly line of said Lots 14 and 15, 150.10 feet to the most southerly corner of Lot 3 in said Block "H"; thence South 56.20 feet to the south line of said Lot 15; thence West along the south line of said Lots 15 and 14, 105.62 feet to the place of beginning, subject to easements of record

and that the plat shown hereon is a correct representation thereof and shows the size and location of the property, its exterior boundaries, the location of all visible structures and dimensions of all principal buildings thereon, boundary fences, apparent easements, roadways and visible encroachments, if any, and that I have surveyed the property hereon described, according to the official records, to the best of my knowledge and belief.

July 16, 1993

Updated and recertified to this 9th day of August, 2000

George J. Dunham, Surveyor

