

N



SCALE 1"=20'


LEGEND

- ⊕ - IRON PIPE FOUND
- CP - COVERED PORCH
- () - RECORDED AS

ABELL
SURVEYING & MAPPING

1140 SEQUOIA STREET • DELAVAN, WISCONSIN 53115
262-728-6737

NOTE: BEARINGS ARE REFERENCED TO THE
RECORDED SUBDIVISION PLAT.

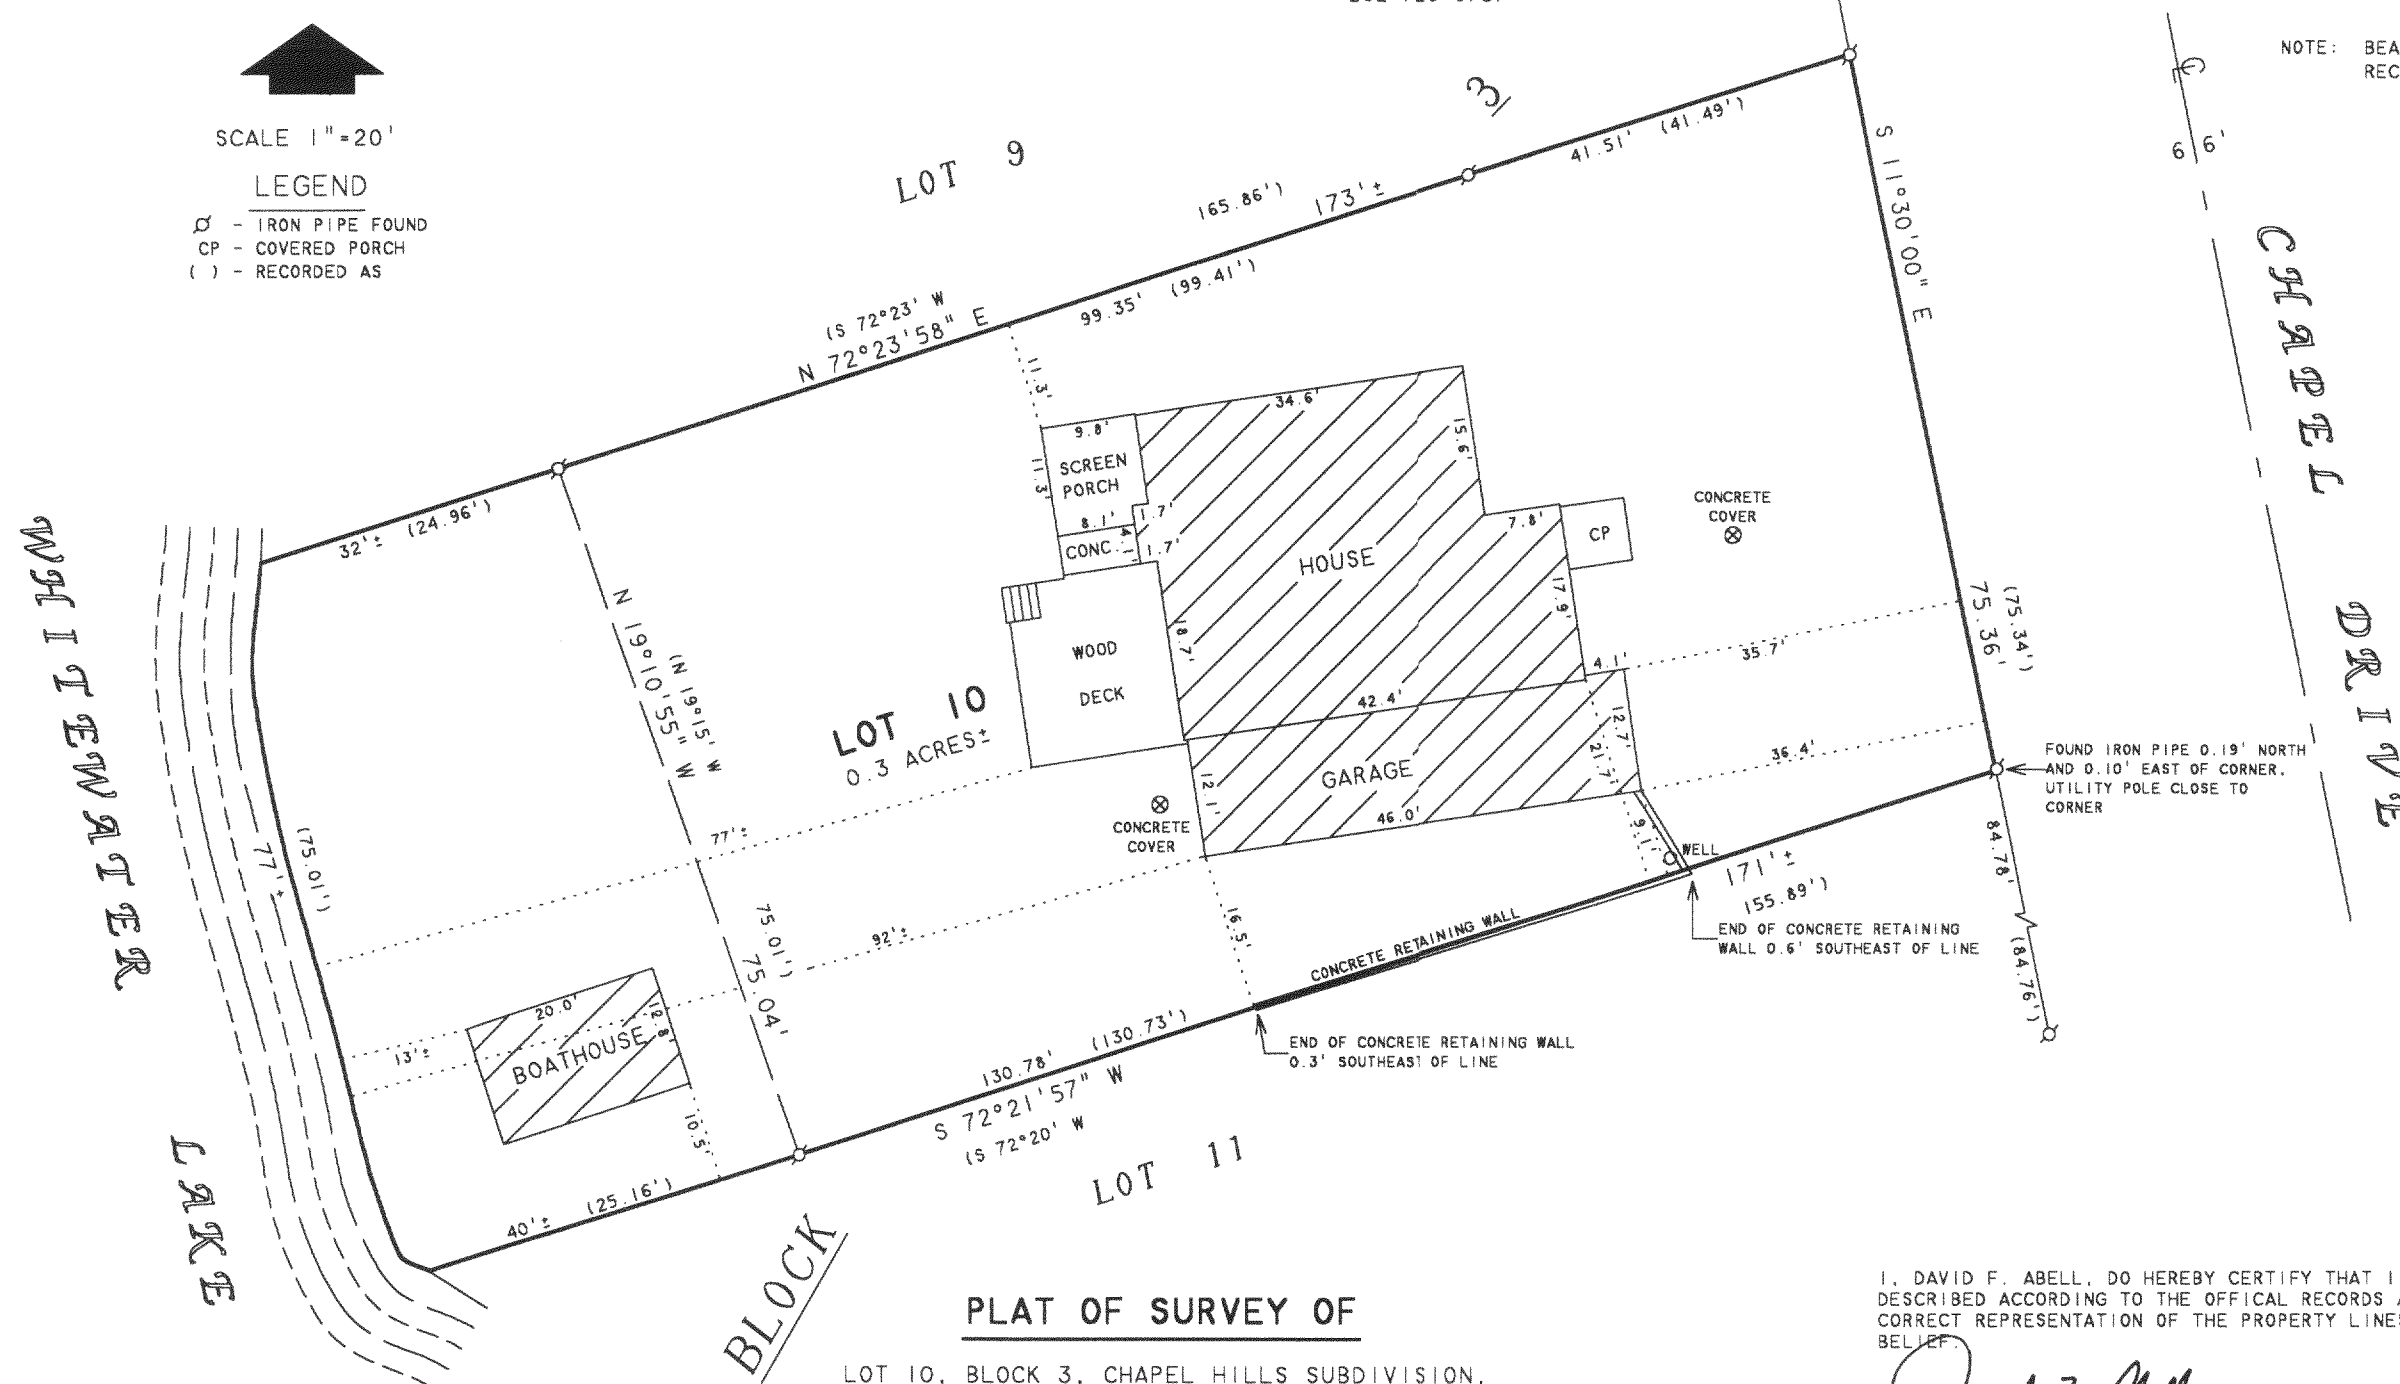

PLAT OF SURVEY OF

LOT 10, BLOCK 3, CHAPEL HILLS SUBDIVISION,
LOCATED IN T3N, R15E, WALWORTH COUNTY,
WISCONSIN.

ORDERED BY: RONALD SHAPIRO
222 E. CHESTNUT STREET
APT. 5C
CHICAGO, IL 60611

REVISED DATE: MAY 21, 2004
REVISED TO SHOW LOCATION OF
WOOD DECK, WELL AND CONCRETE
COVERS.

ORDERED BY: JANET LIPPINCOTT
741 CRESTWOOD DRIVE
WAUKESHA, WI 53188

I, DAVID F. ABELL, DO HEREBY CERTIFY THAT I HAVE SURVEYED THE PROPERTY HEREON
DESCRIBED ACCORDING TO THE OFFICIAL RECORDS AND THAT THE PLAT HEREON IS A
CORRECT REPRESENTATION OF THE PROPERTY LINES TO THE BEST OF MY KNOWLEDGE AND
BELIEF.

David F. Abell

DAVID F. ABELL
WISCONSIN REGISTERED LAND SURVEYOR, S-1596

February 11, 1999

DATE: February 11, 1999 JOB NUMBER - 99009A
NOTE: THIS IS NOT A CERTIFIED COPY UNLESS SEALED.

CLH 000080

315-863