


**ABERNATHY and ASSOCIATES**

**Kenneth B. Abernathy Jr.**

Wisconsin Registered Land Surveyor S-1594

W4056 BRAY RD.  
ELKHORN, WI. 53121  
PHONE: (262) 723-4260 (OFFICE)  
(262) 723-7209 (FAX)  
Email: abernathy@elknet.net

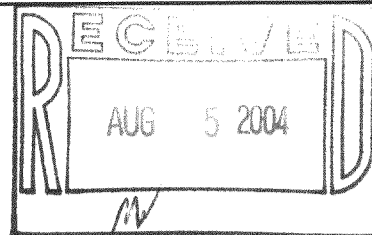


PLAT OF SURVEY


LOT 1 OF CERTIFIED SURVEY MAP NO. 1028 AS RECORDED IN VOL. 4 P. 310 AS DOCUMENT NO. 57708, LOCATED IN THE NE 1/4 OF THE NW 1/4 OF SECTION 5, T3N, R15E, TOWN OF RICHMOND, WALWORTH COUNTY, WISCONSIN.

Ordered by: Schauder Building, Inc.  
4115 North U.S. Highway 51  
Janesville, Wi. 53545-9674

OWNER: TIMOTHY EISNER  
189 S. BLUFFRIDGE DR # 204  
WHITEWATER, WI. 53190

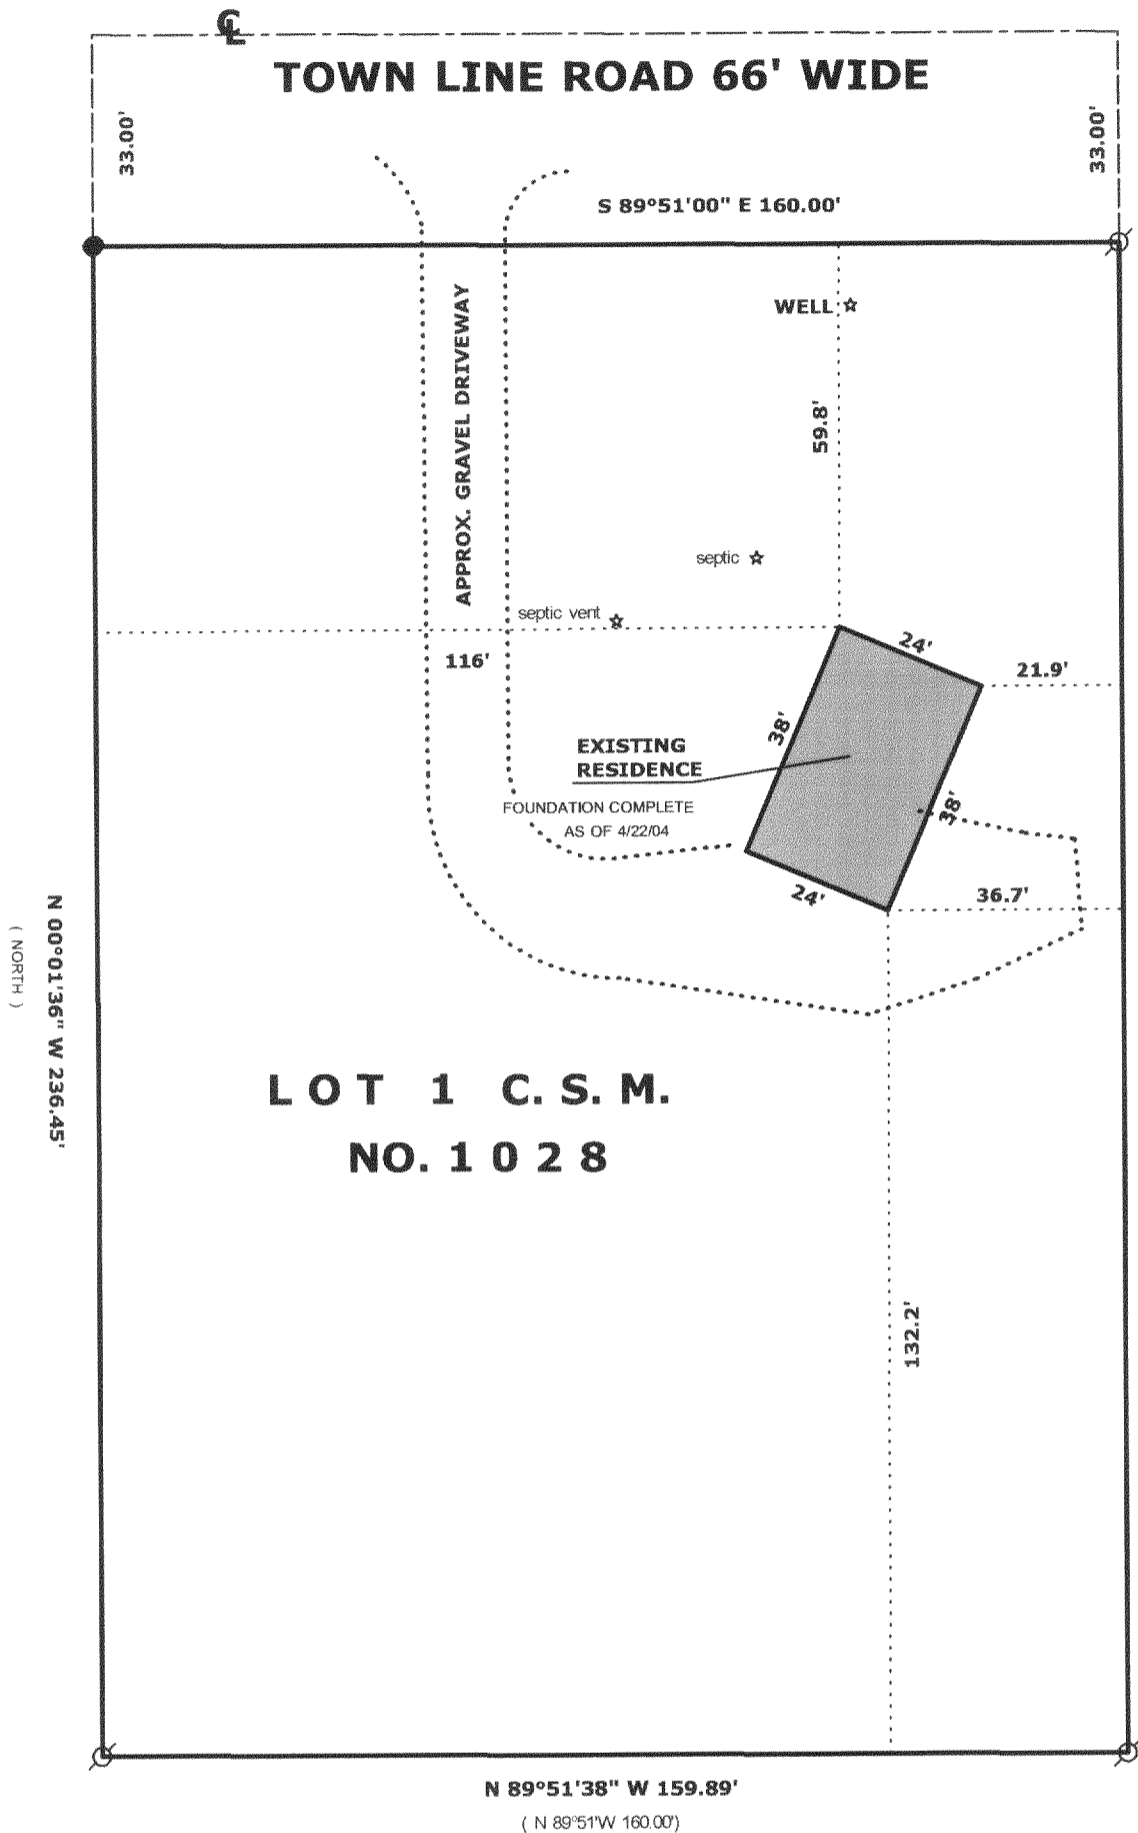

LOT 2

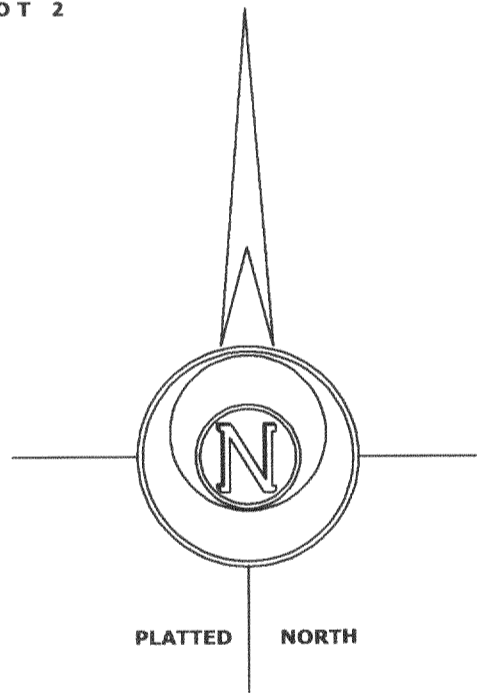

SCALE: 1" = 30 FEET

LEGEND

- ⊙ FOUND IRON PIPE
- FOUND IRON ROD
- ⊠ FOUND BRASS CAPPED MONUMENT
- FOUND CONCRETE MONUMENT
- + CHISEL CUT IN CONCRETE
- SET IRON ROD, 24" LONG, WEIGHING 1.5 LBS./LINEAL FT., 3/4" DIA.
- SET IRON ROD, 30" LONG, WEIGHING 4.5 LBS./LINEAL FT., 1-11/16" DIA.
- ( x x x ) RECORDED AS DIMENSION|
- x-x-x-x- EXISTING FENCE



"I hereby certify that the above described property has been surveyed by me or under my direction and that the above map is a true representation thereof and shows the size and location of the property, its exterior boundaries, the location of all visible structures and dimensions of all principal buildings thereon, boundary fences, apparent easements, roadways and visible encroachments, if any."  
"This survey is made for the use of the present owners of the property, and also those who purchase, mortgage, or guarantee the title thereto within one year from the date hereof."

*Kenneth B. Abernathy, Jr.*  
KENNETH B. ABERNATHY, JR. S-1594  
WISCONSIN REGISTERED LAND SURVEYOR,

DATED SEPT. 18, 2003 Job No. 03.906

REVISED 10/06/03  
REVISED 4/22/04 AS BUILT

CA 102800(1)

315-867