


PLAT OF SURVEY

LOT 1 CERTIFIED SURVEY MAP NO. 1051, being a part of the Southwest 1/4 of Section 8, Town 3 North, Range 15 East, Town of Richmond, Walworth County, Wisconsin.

Surveyed for: Century 21 Walton Realty

Survey address: N6587 State Road "89"

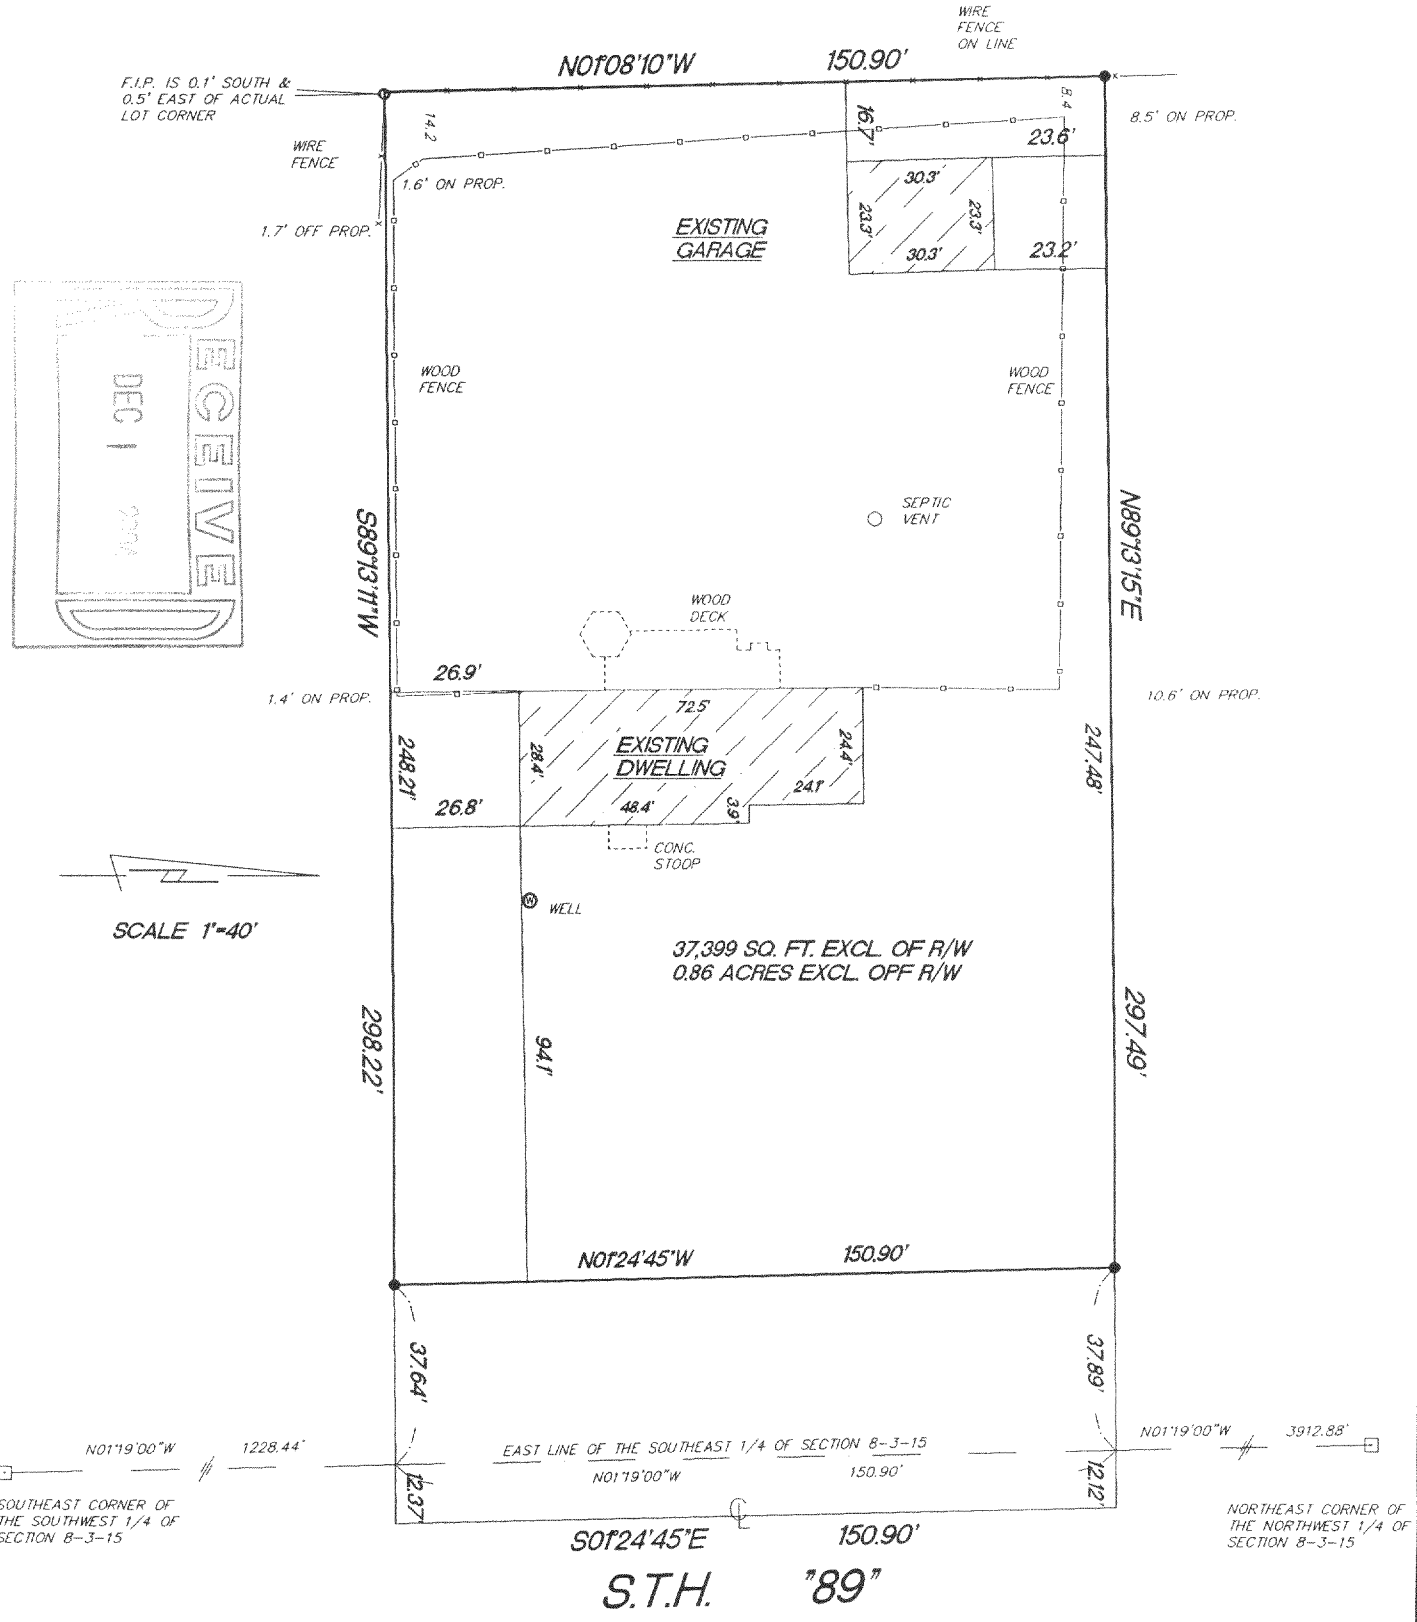

SCALE 1"=40'


37,399 SQ. FT. EXCL. OF R/W
0.86 ACRES EXCL. OFF R/W

- FOUND 1" IRON PIPE (F.I.P.)
- SET 1" IRON PIPE
- FOUND 6" CONC. MON.

"I hereby certify that I have surveyed the above described property and that the above map is a true representation thereof and shows the size and location of the property, its exterior boundaries, the location of all visible structures and dimension of all principal buildings thereon, boundary fences, apparent easements, roadways and encroachments if any."

"This survey is made for the use of the present owners of the property, and also those who purchase, mortgage or guarantee the title thereto within one year from date hereof."

KETTLE MORaine SURVEYING INC.
W356 S9050 Godfrey Lane
Eagle Wisconsin 53119
P.O. Box 357
(262) 594-3484
Terrance E. Pisarek R.L.S.

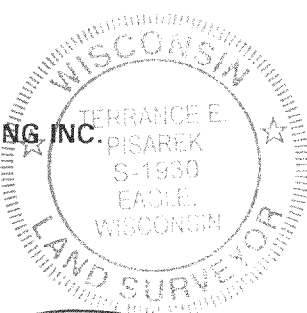

[Handwritten Signature]

THIS IS NOT AN ORIGINAL SURVEY UNLESS THE SEAL IS RED.

10/12/04 TEP/DW TEP 04185
DATE FIELD WORK BY DRAWN BY JOB NUMBER

CA105100001

315-885